


No. Fail

Rajah di muka

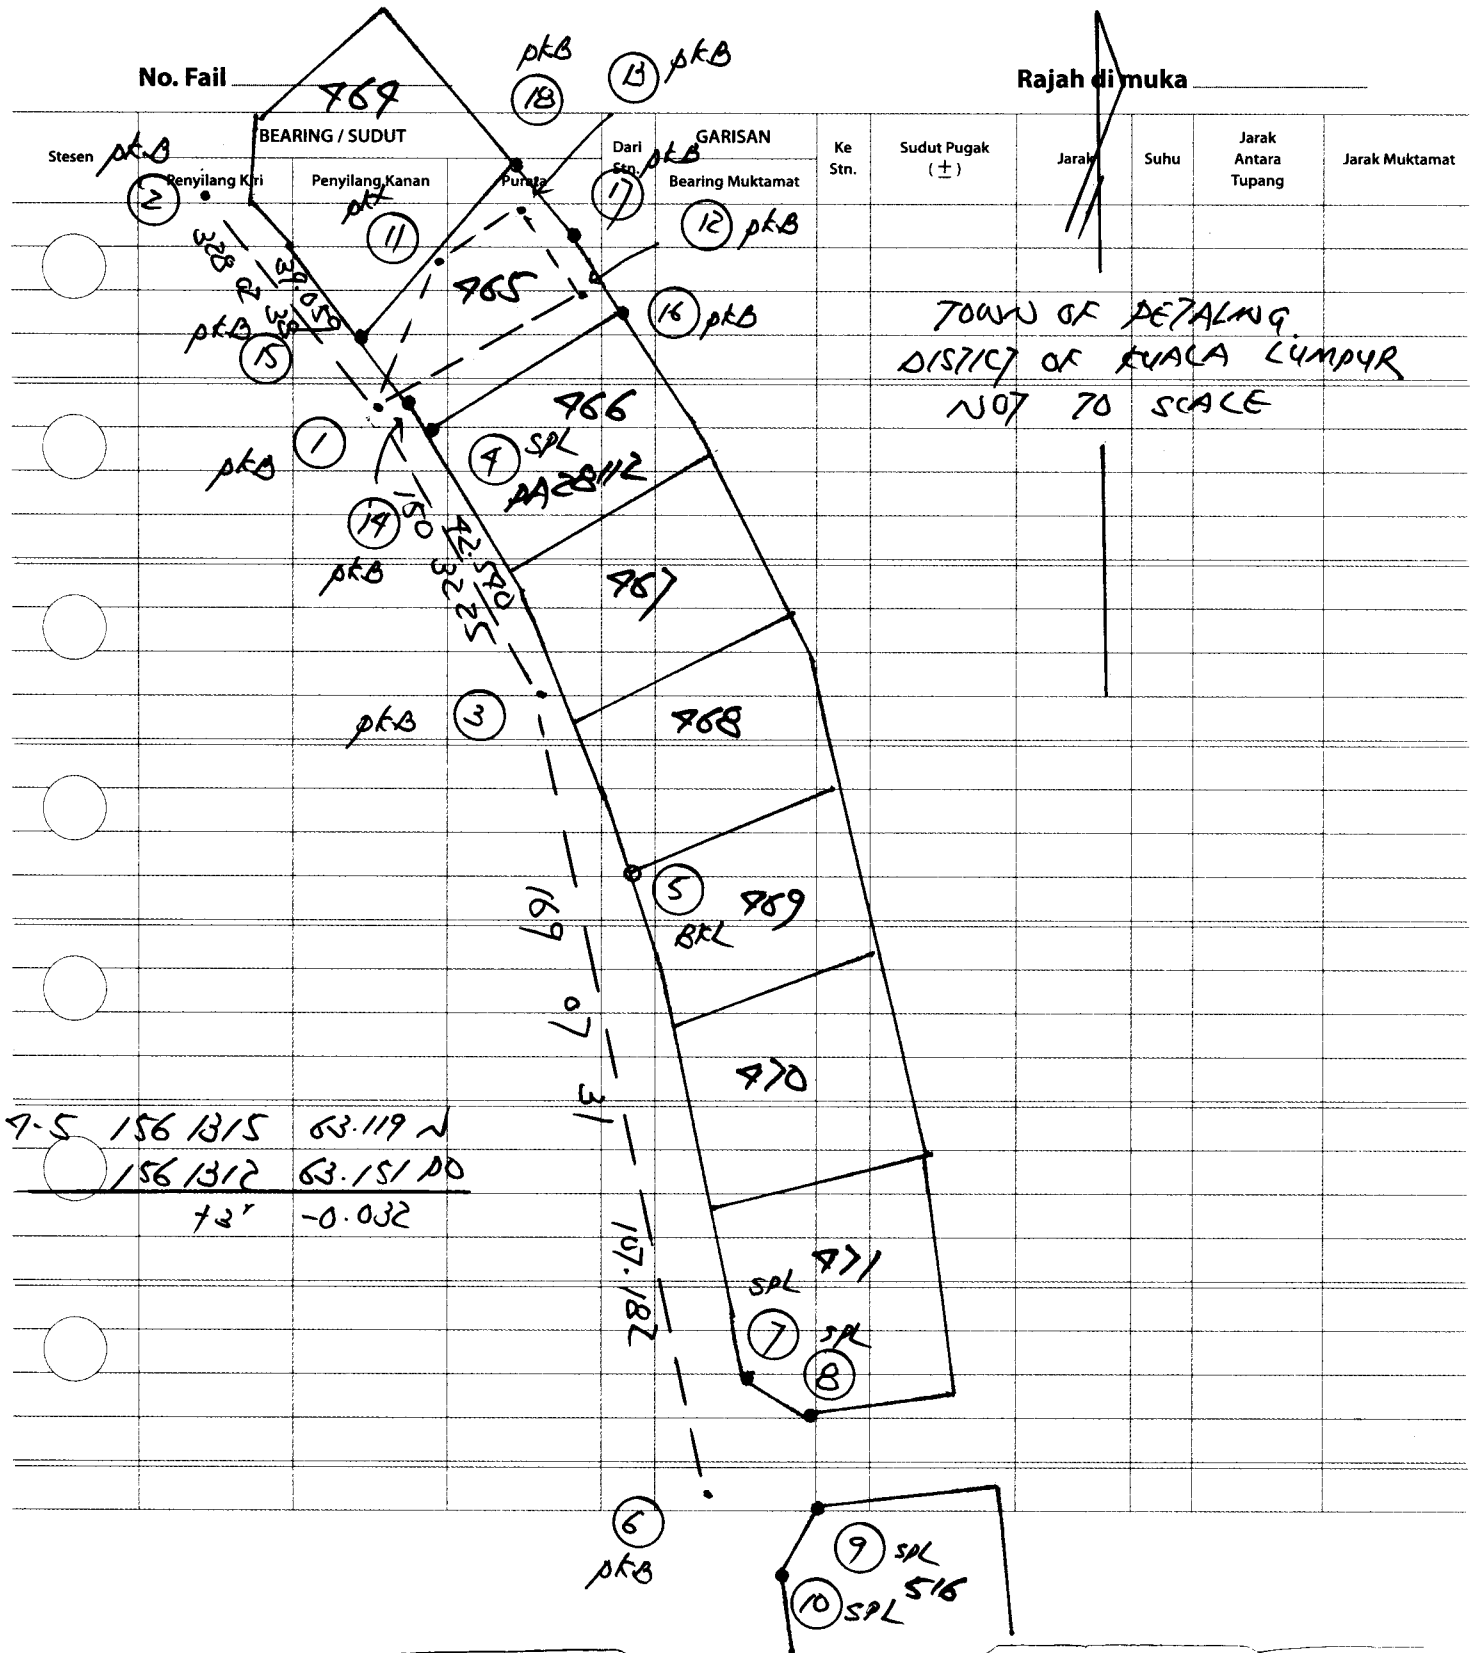

Taken for.....

To.....
P.O. No. 1979-03011

34