

No. 523 Mutham Hums.

08/08/20

Datum Daripada

2 1962127 1 H
pkB Ag Af. pkB
Dgn MH

67.518

67.518

2-3 332153

2 332153 3 H

6.899

BKL

6.899

2-7 1370000

2 1370000 7 H

55.097

BKL

55.097

2-5 1915259

2 1915259 5 H

25.596

BKL

25.596

1-6 2-6 291978

1 291978 6 H

8.692

BKL

8.692

1-7 963655

1 963655 7 H

49.770

PL

49.770


4-8 1960035

7 1960035 8 H

5.887

AB

5.887

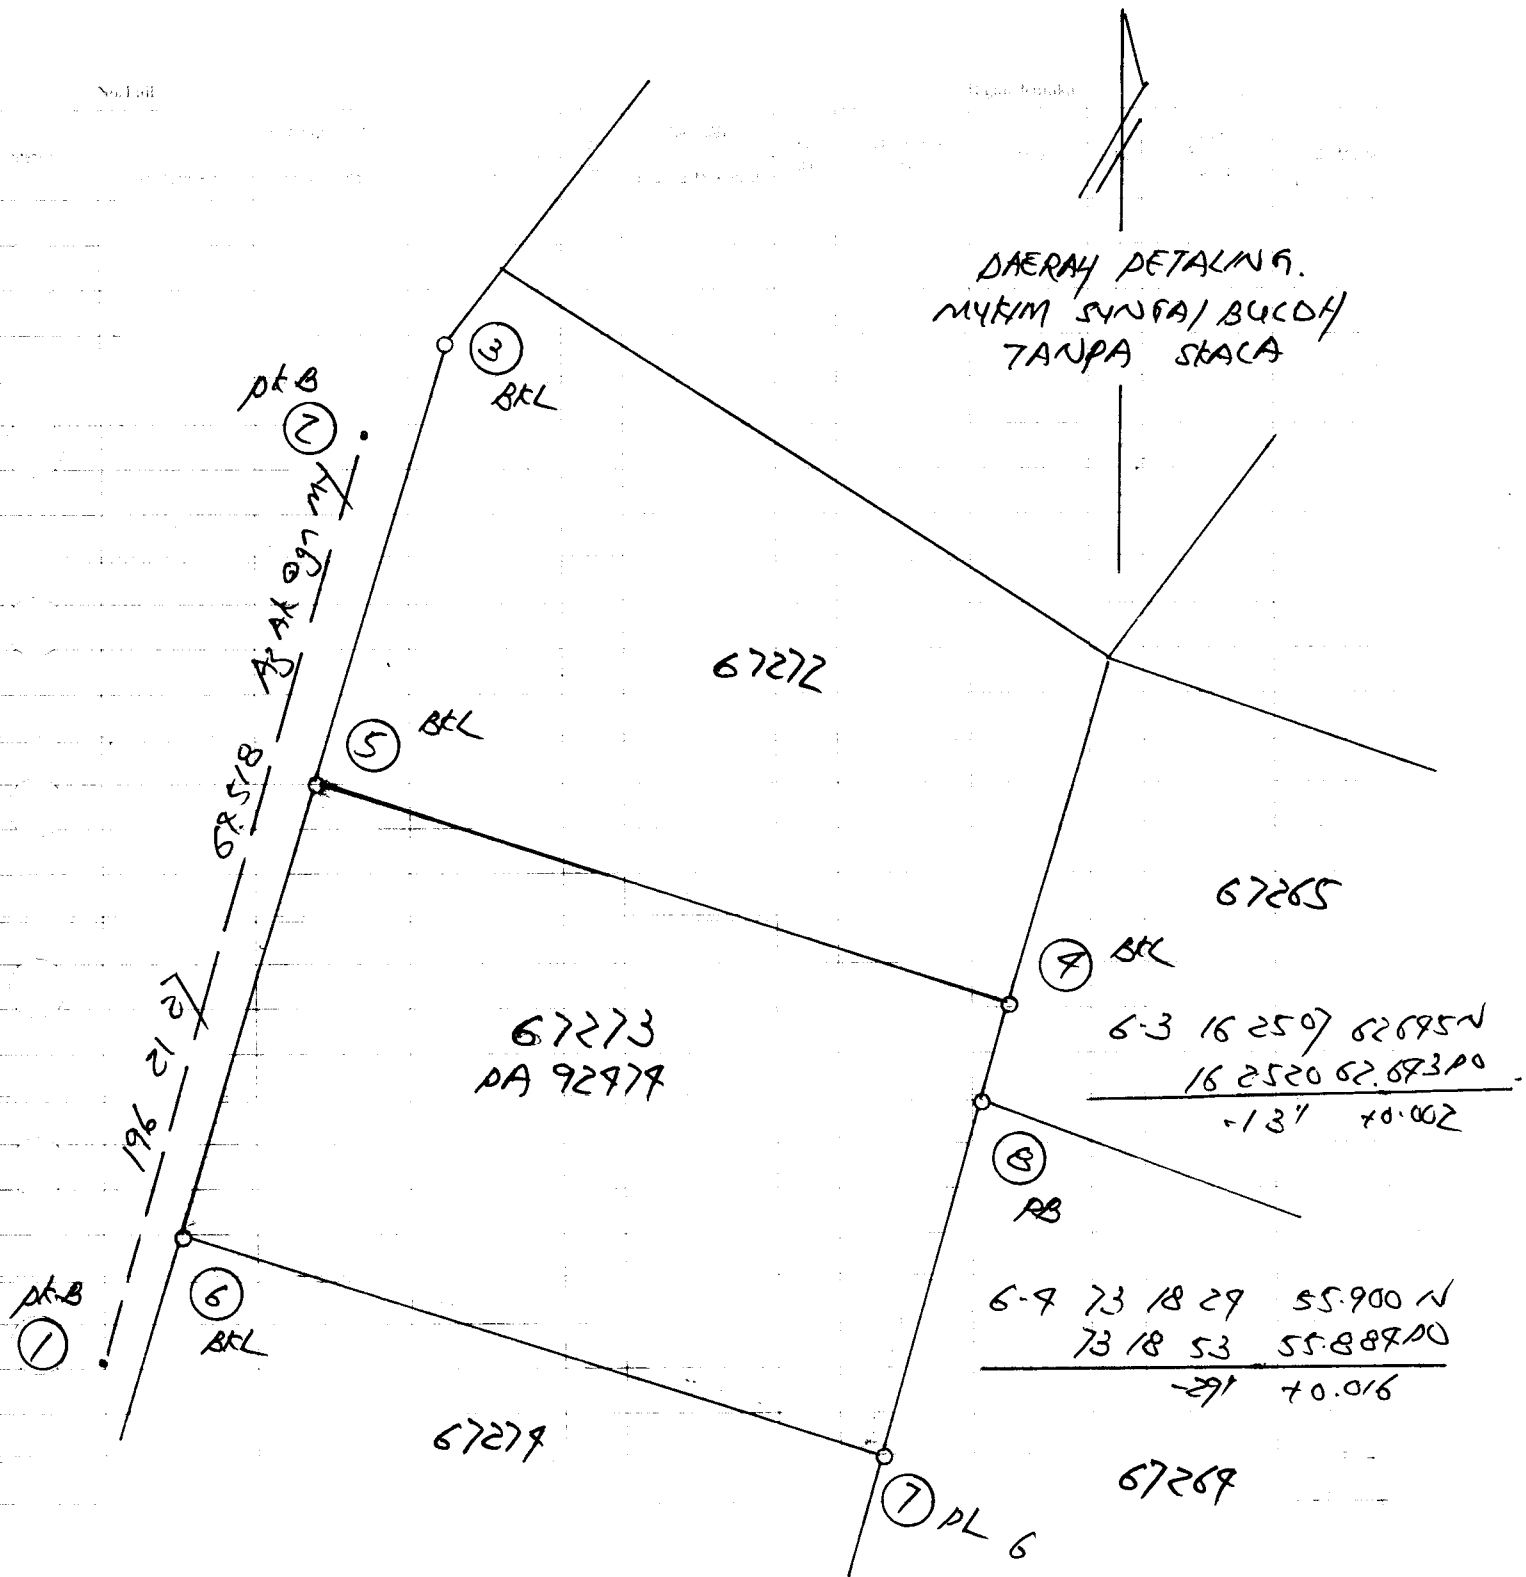

Location J2523
 Purpose muting home

26

Stn. No.	Horiz. Dist.	Ht. Diff. + or -	RL of Inst.	RL Centre Reading	m	RL Object	Remarks
1	1.9715					78.087	GPS
		1.7237				77.835	F2
		1.9950				78.0635	BM F3389
		1.9167				78.1918	BM F3390
		1.3852				78.1733	F1501

All the heights is based
 on BM W0089
 Banta 7701

BM W0089
 GPS level: 59.037
 BM level: 59.009
 +0.028

GPS
 GPS level: 78.115
 constant: 0.028
 78.087