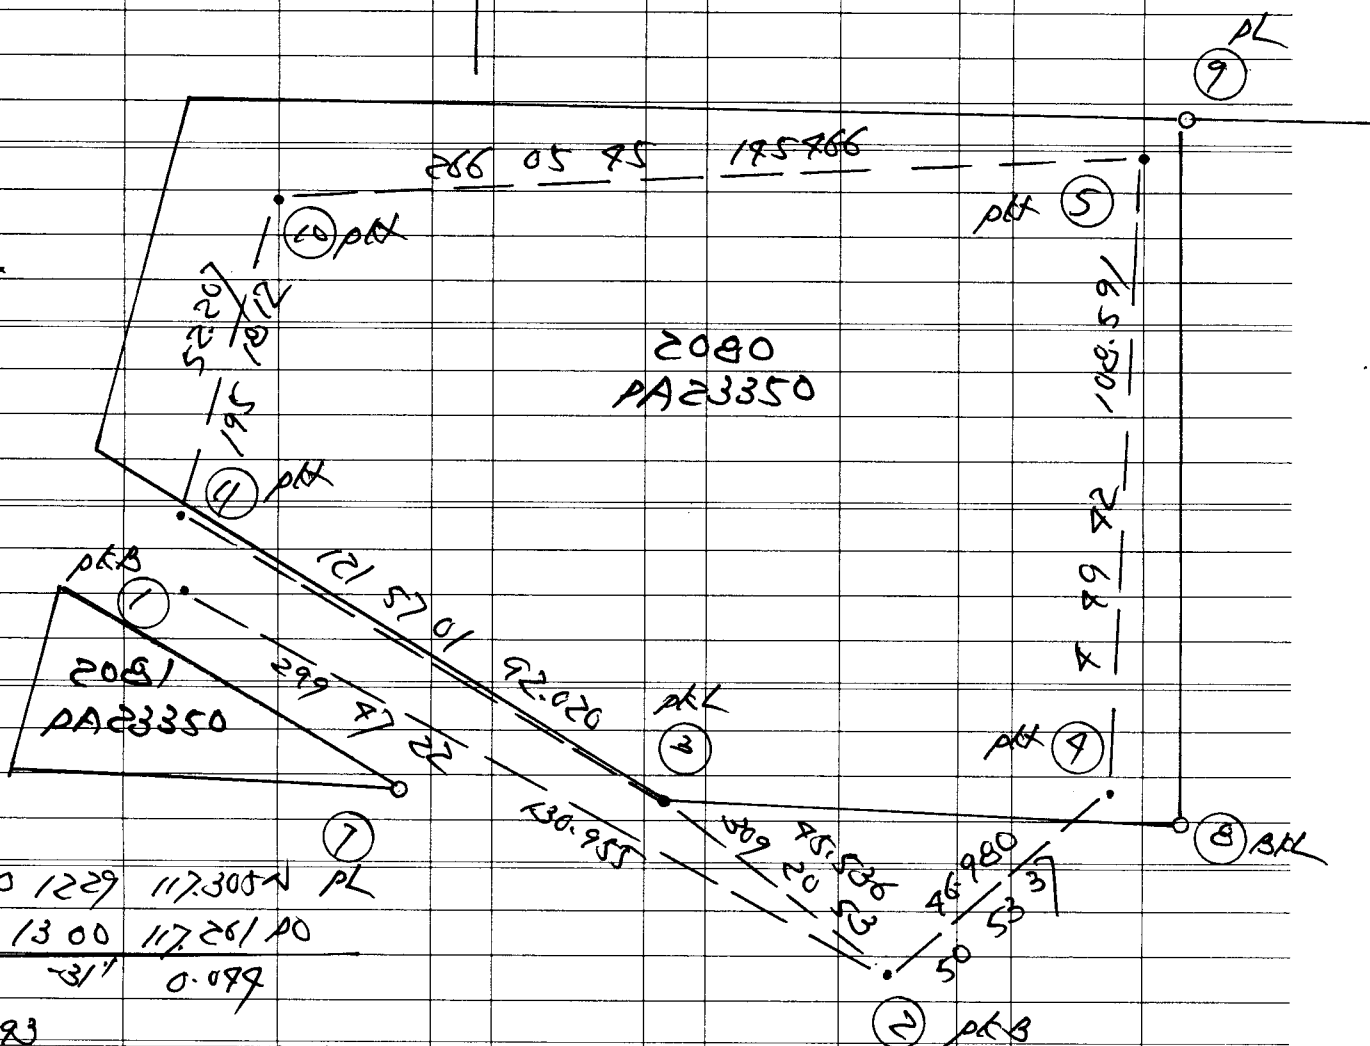


[illegible]

DAERAH 44 SELANGOR

Rajah di muka

[illegible]

Location

Purpose *5 friends*

10

Horiz. Dist.	Ht. Diff. + or -	RL of Inst.	RL Centre Reading	m	RL Object	Remarks
1.2993				37.316		BM B 5119
	1.1863			37.379		TBM F3952/P1
0.3536		2.3799		36.1859		CP1
0.9688		2.7341		39.1089		CP2
	1.9919			33.6323		TBM F3953/P2