


JZG12 Mahkota Putra

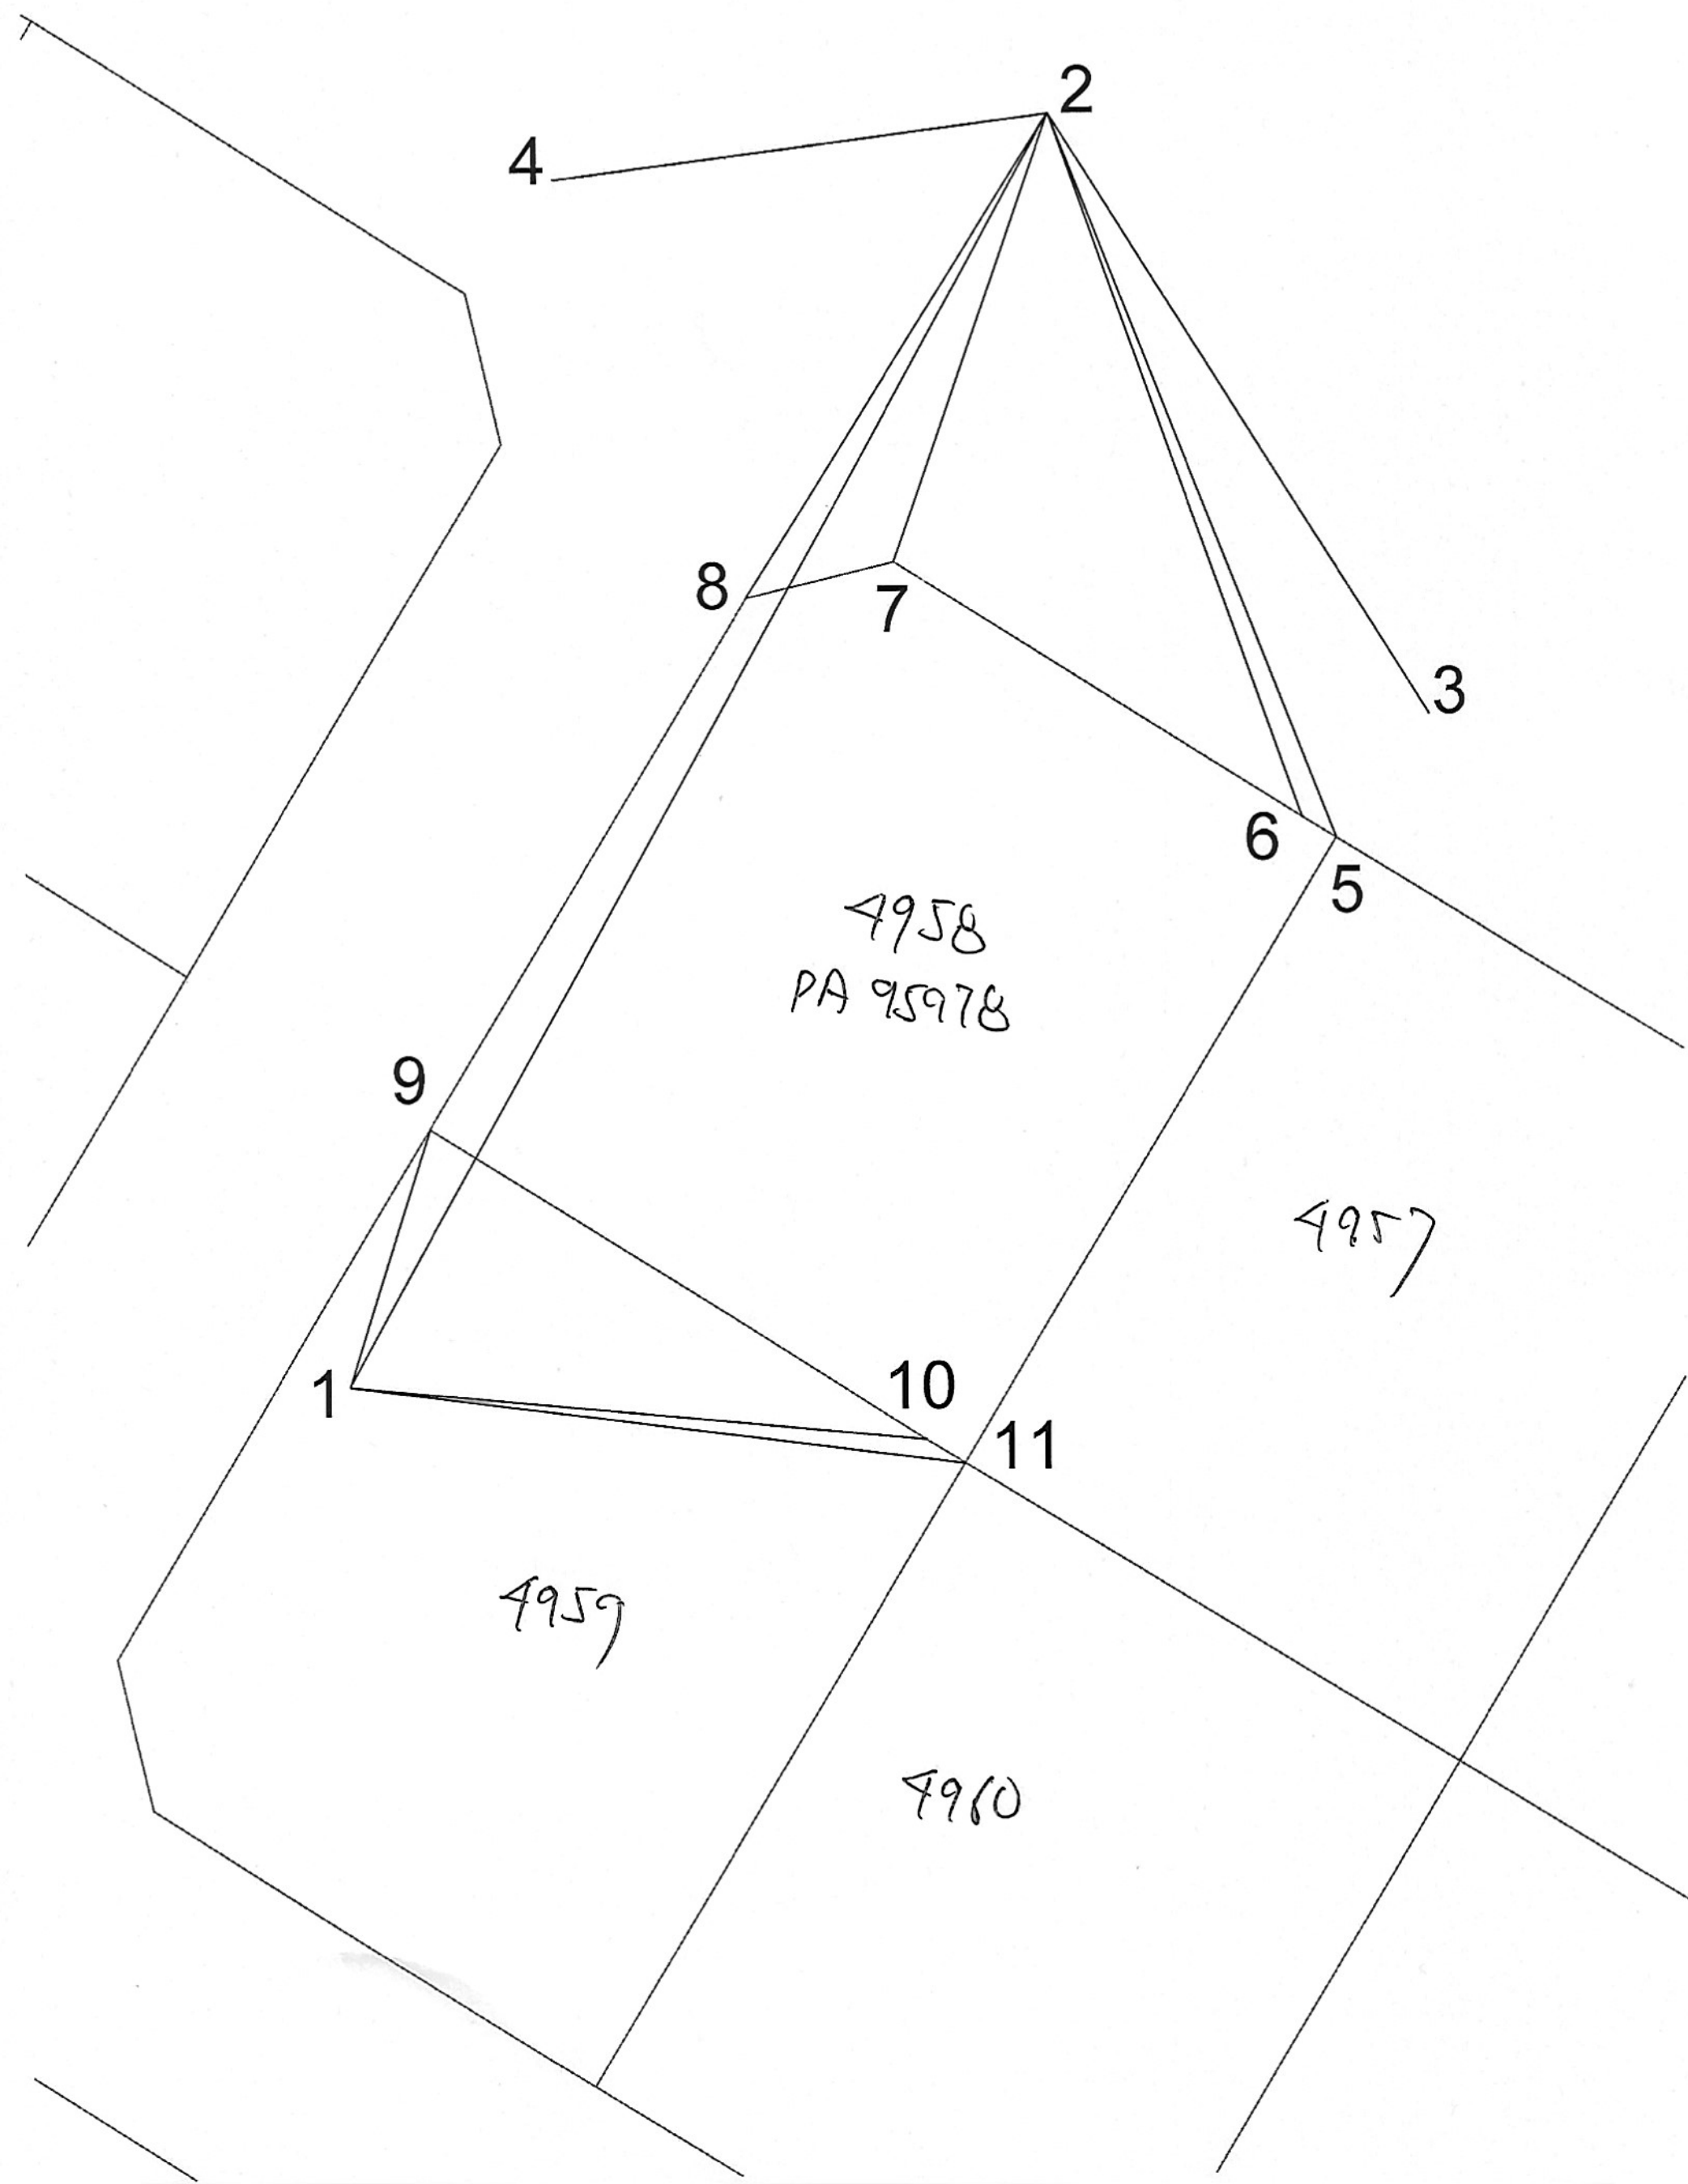

Location

Purpose *MARIN FY19*

Horiz. Dist.	Ht. Diff. + or -	RL of Inst.	RL Centre Reading	m	RL Object	Remarks
0.8970				70.295		TBM F38/5
	1.8980			39.299		TBM F381(7#)
	2.0622			38.9298	F1	
		1.2707		39.7513	F3	

Based on
All the heights BM B0369
* BM Level 21.810