


[illegible]

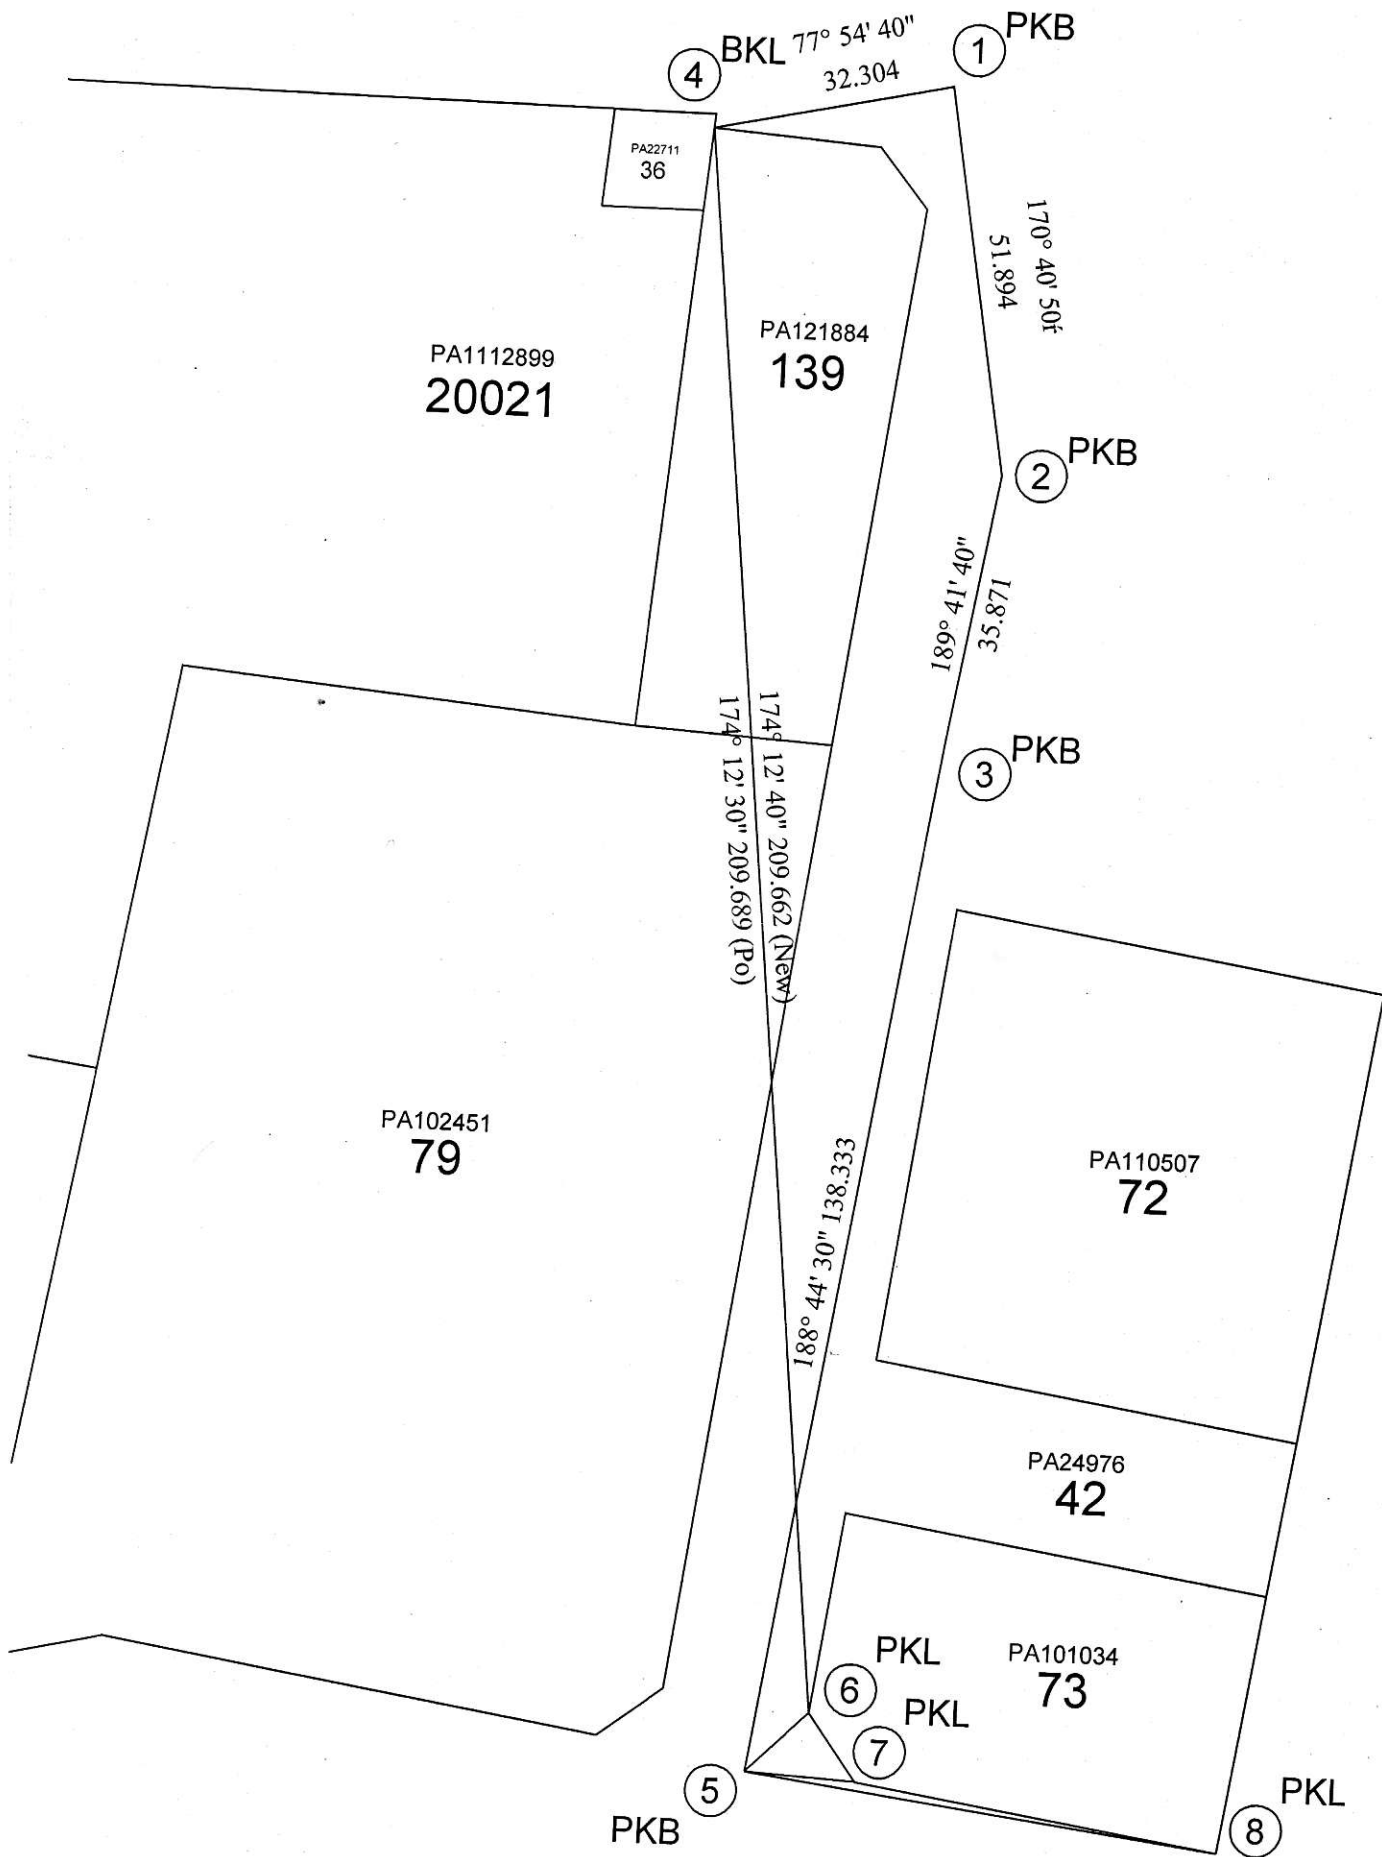

38

522

Location.

Purpose.

Ht. Diff.	RL of	RL Centre	m	Object	Remarks
+ or -	Inst.	Reading			
Dist.					
Ioniz.					

222%

1.2961

8/11/

2023.3.20

78M F3839 (72)

34

73-82

43.221

78M + 3030

Remarks

w

Object

78M ✓ 3838

61.8 : 1000 50/0

constant: 0.027

43.22/

BMW 450619

8m (rev) 1 70.19

0/1.05 : 1007 500

20.0