


No. Fail

Rajah di muka

Stesen	BEARING / SUDUT			Dari Stn.	GARISAN	Ke Stn.	Sudut Pukak (±)	Jarak	Suhu	Jarak Antara Tupang	Jarak Muktamat
	Penyilang Kiri	Penyilang Kanan	Purata		Bearing Muktamat						
	Datum Daripada			2	392 27 90	1	H	27.666			27.660
				pkB		pkB					
				7BM		7BM					
2-3	3 07 26			2	3 07 26	3	H	92.912		pkLE	92.912
2-4	1 52 06			2	1 52 06	4	H	80.230		pk-LE	80.230
2-5	355 23 20			2	355 23 20	5	H	99.511		pkLE	99.511
2-6	350 39 10			2	350 39 10	6	H	76.900		pk-LE	76.900
2-7	292 09 13			2	292 09 13	7	H	49.613		pkLE	49.613
2-8	328 03 57			2	328 03 57	8	H	19.853		pk-LE	19.853
2-9	320 46 45			2	320 46 45	9	H	17.288		pk-LE	17.288
2-10	278 46 17			2	278 46 17	10	H	10.672		pk-LE	10.672
2-11	253 18 09			2	253 18 09	11	H	9.935		pkLE	9.935
2-12	266 59 80			2	266 59 80	12	H	41.760		pkLE	41.760

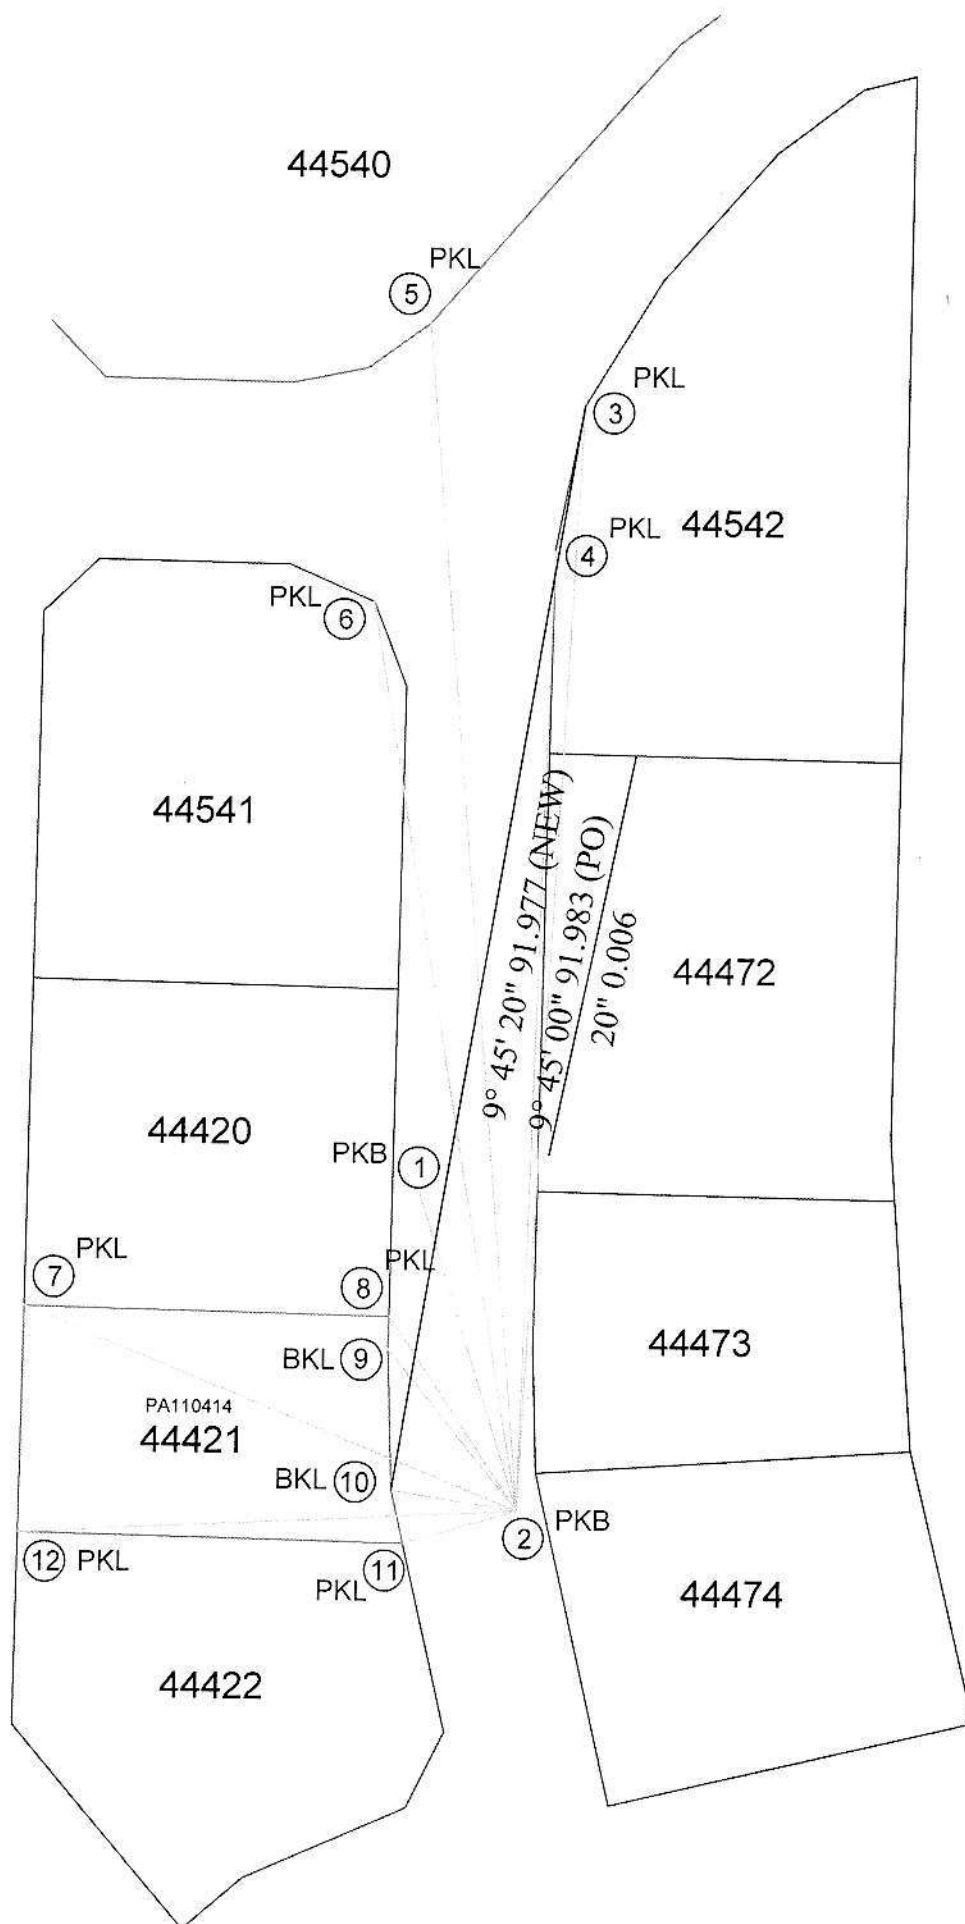

JZ 636 Syng 4/1/1

1.273

0.276

62.617

63.619

TBM F386X

TBM F3865

BM B5331

BM Level: 49.913

GPS Level: 49.952

0.039

TBM F3865

GPS Level: 63.653

constant: 0.039

63.619