

No. Fail. JE 677 Damansara Jaya


Rajah di muka

[illegible]

No. Fail

Rajah di muka

Stesen	BEARING / SUDUT			Dari Stn.	GARISAN		Ke Stn.	Sudut Pukak (±)	Jarak	Suhu	Jarak Antara Tupang	Jarak Muktamat
	Penyilang Kiri	Penyilang Kanan	Purata		Bearing Muktamat							
1-2	Spartan	di Atas	320 1620	2	320 1620	12	H	37.108				37.108
2-4												
12-12	320 1620	140 1620										
	pkt.											
2-12	140 1620	320 1620	225 9919	12	225 9919	13	H	16.729				16.729
12-13	225 9919	75 9919										
	pktB											
12-13	75 9919	225 9919	128 5576	13	128 5576	11	H	22.137				22.137
13-11	128 5576	308 5576										
13-11	308 5576	128 5576	92 1991	11	92 1991	2	Sila lihat m/s 13 & 7					
					Bearing							
2-11	92 1991	272 1991			Tutupang.							
	Bearing 11-2 Didara		92 1991									
	Sepatutnya Didara		92 1991									
	Tika in		Ni)									
	Amberukn.		Ni)									
11-20	53 2235			11	53 2235	20	H	18.670		77		18.670
11-21	53 4257			11	53 4257	21	H	17.978		pktB		17.978
11-22	148 2309			11	148 2309	22	H	2.925		PB		2.925
11-23	162 2355			11	162 2355	23	H	3.127		PB		3.127
13-24	263 3935			13	263 3935	24	H	2.290		pktB		2.290
13-25	30 0047			13	30 0047	25	H	9.166		pktB		9.166
12-26	337 9806			12	337 9806	26	H	3.603		pktB		3.603

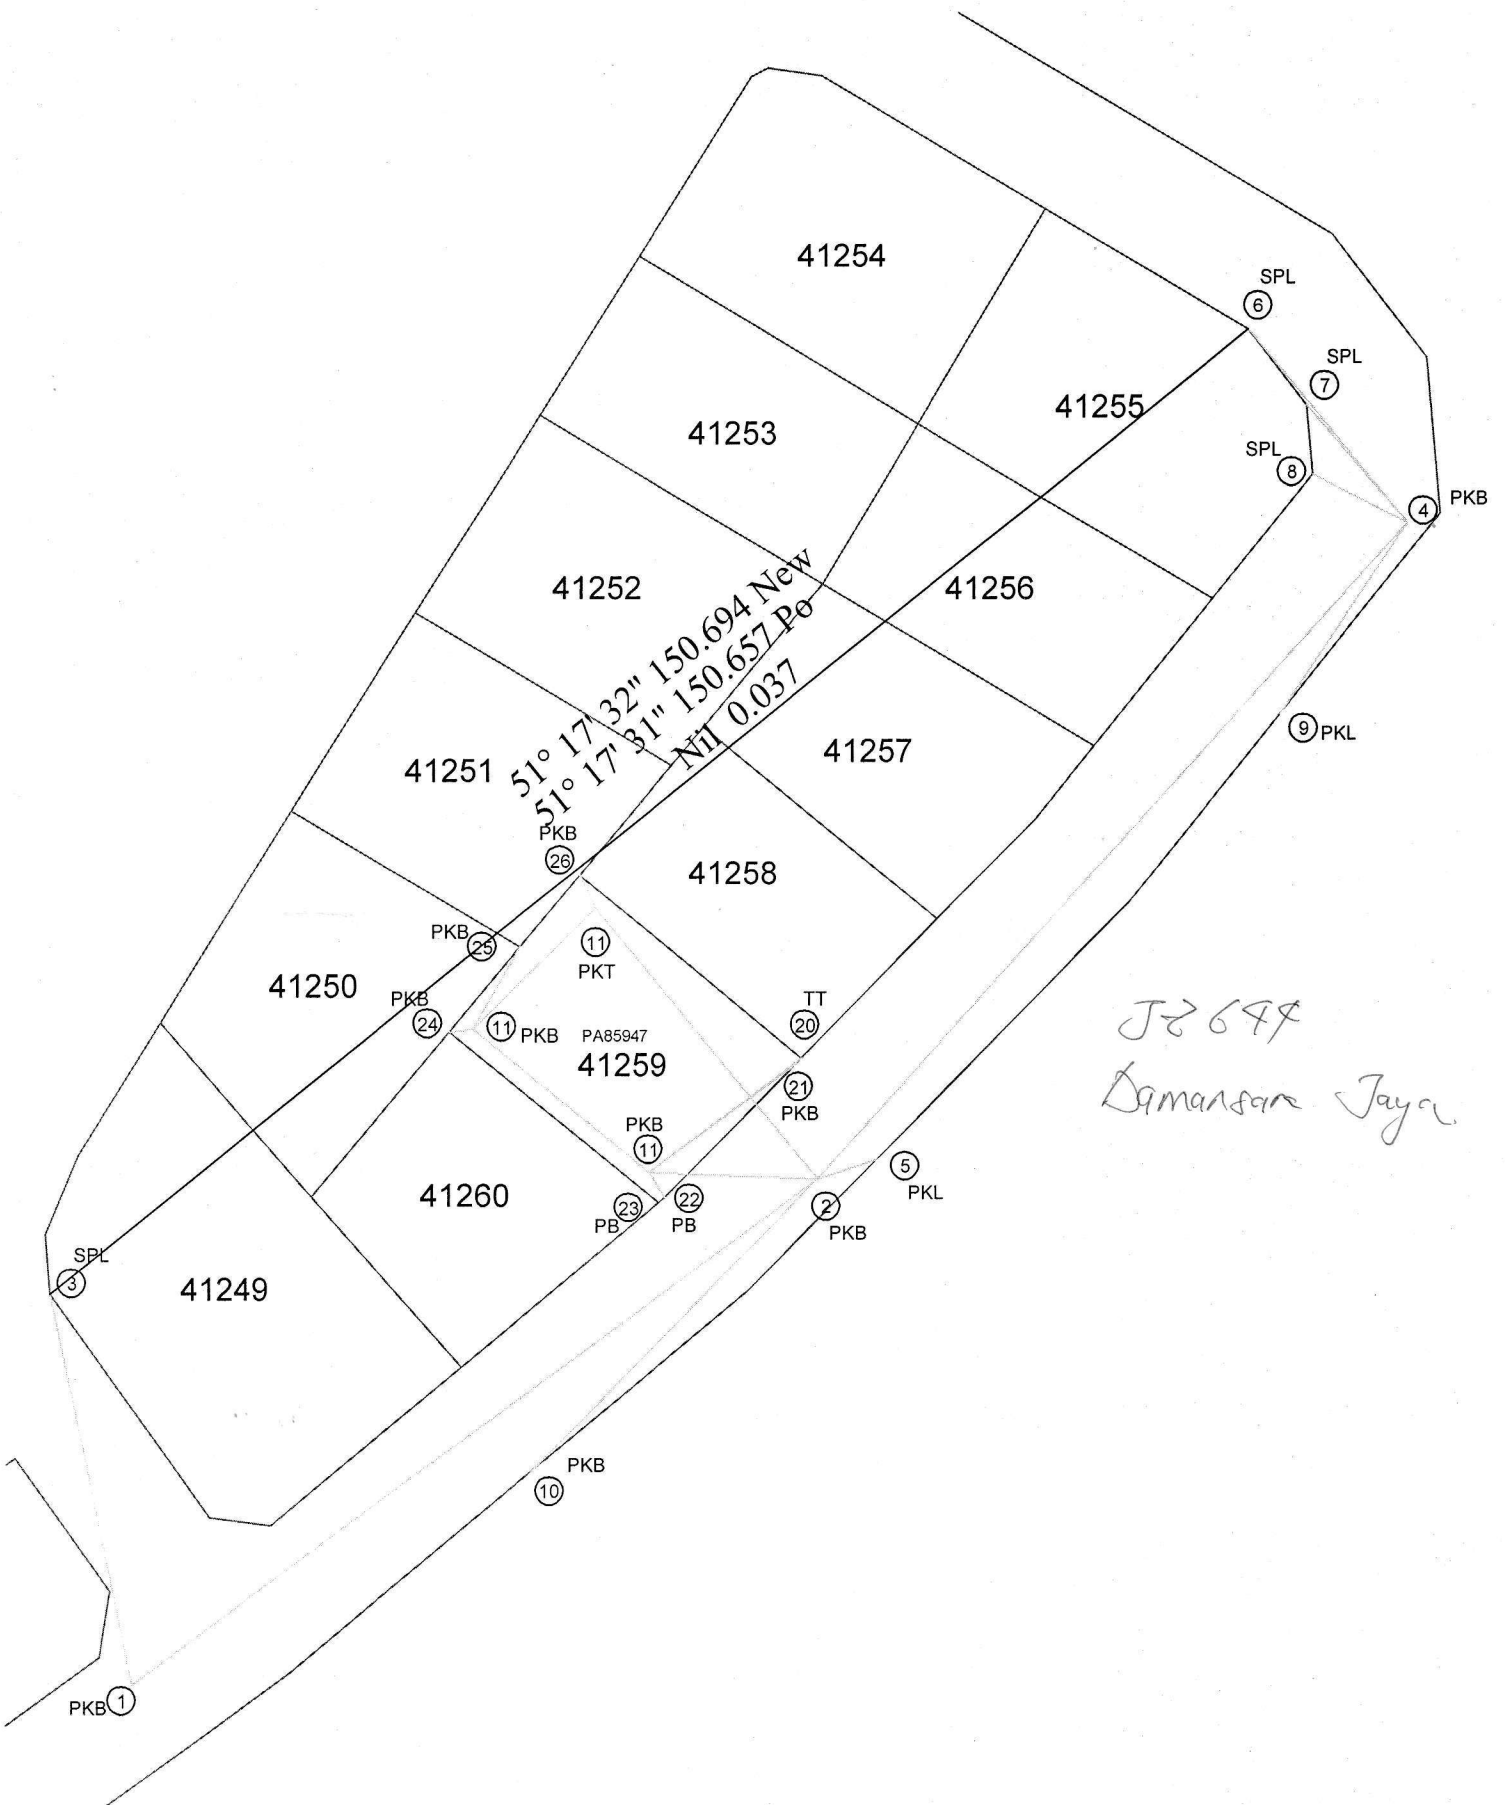

Deimansara Jaya J2689

2.3968

46.692

7BM F2956

1.6822

47.3786

7BM F

1.6929

0.5098

~~48.537~~ 48.5332

7BM F3866

0.5915

~~49.5057~~ 49.5896

7BM F3867

1.1586

~~51.335~~ 49.0175

F2

49.0185

F2

All the heights based on
BM W0009

Job: J2 155 7BM F2956