


No. Fail

Rajah di muka

[illegible]

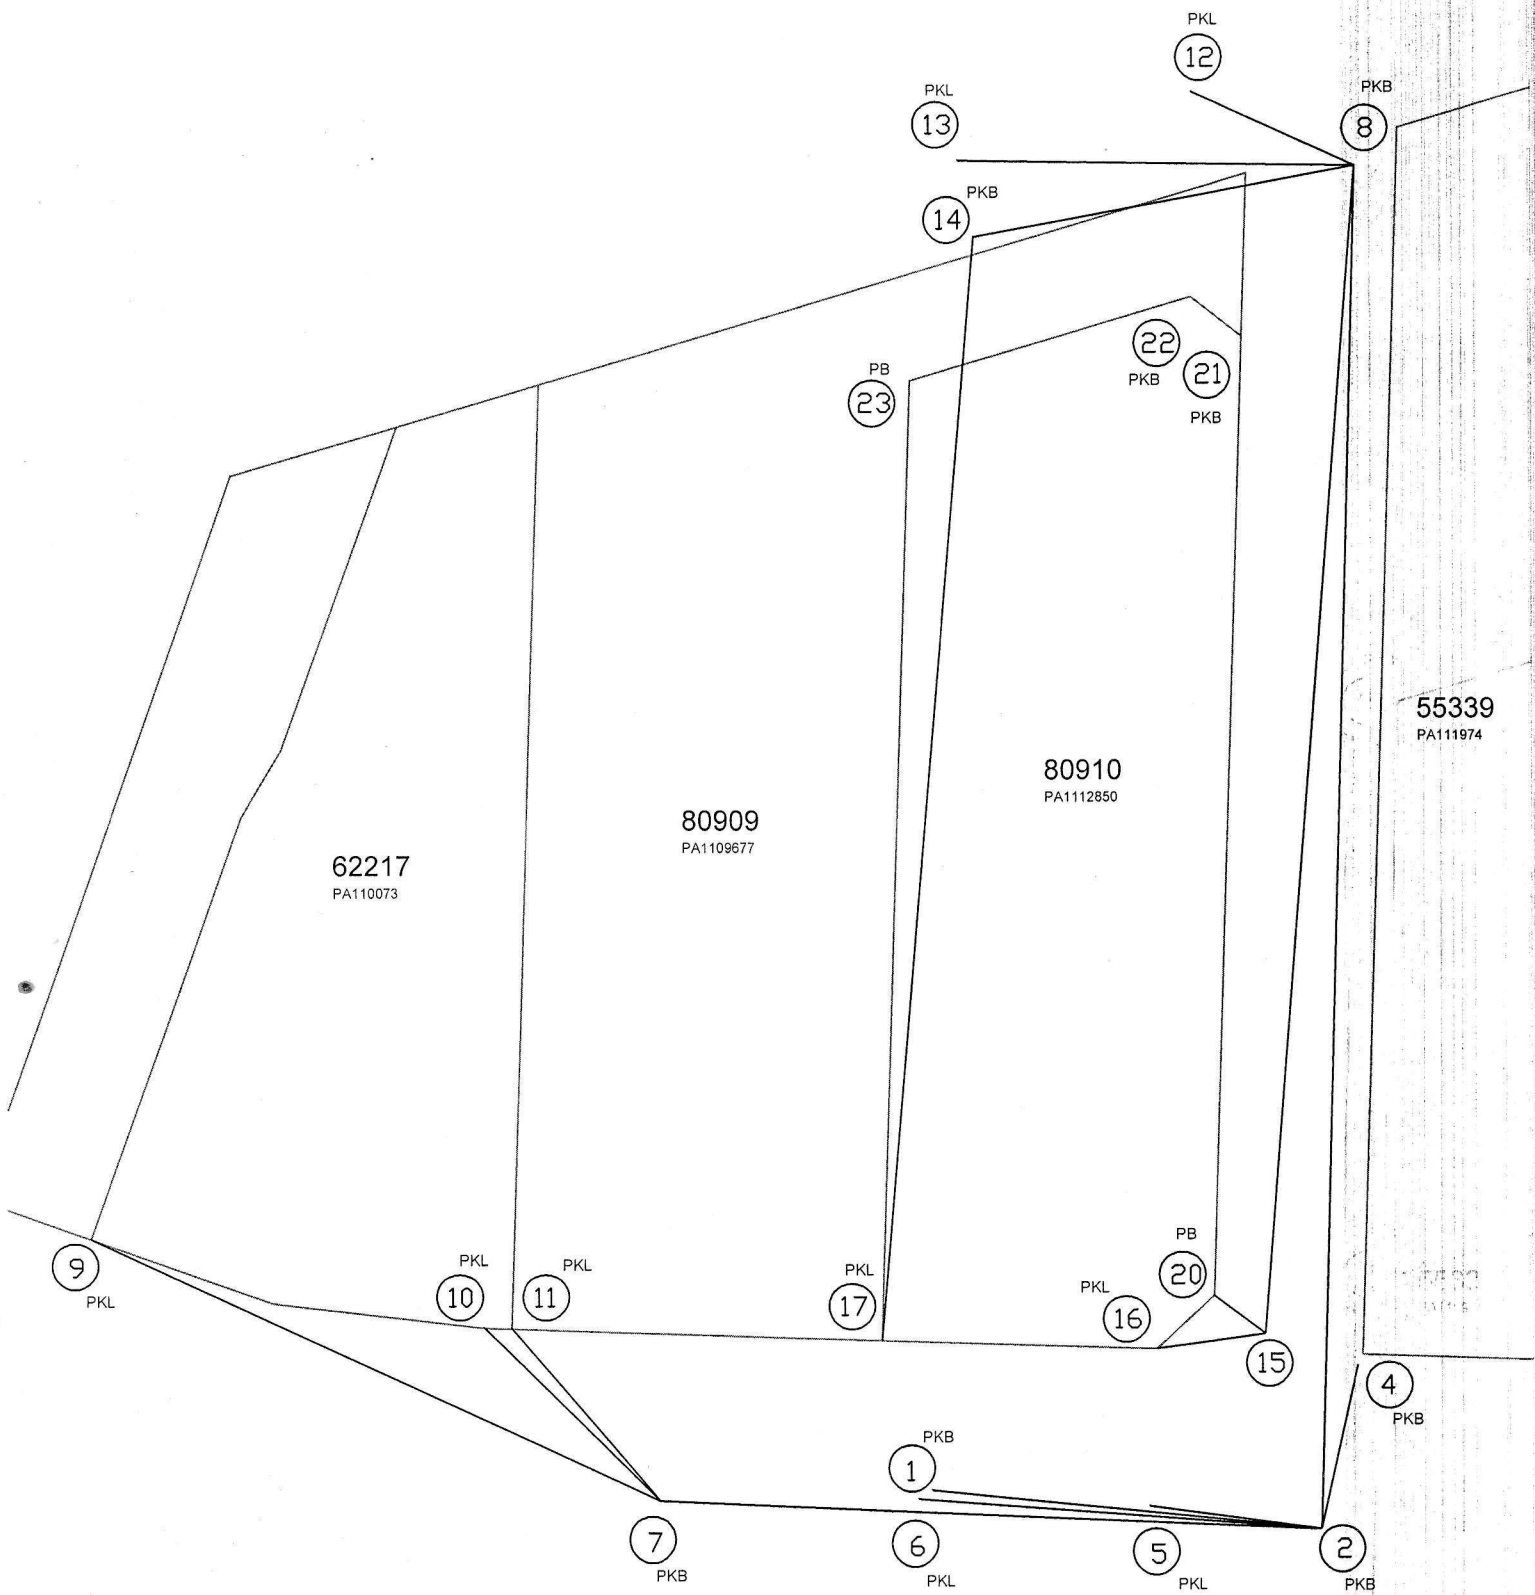

7.7357	83.6279	CPK
4.9180 4.9180	83.9998	TBM K3908/157
3.3971	85.015)	site RL: 83.793
0.1081	83.6766	F15
1.4902	82.2995	site RL: 81.827
1.7320	85.0525	site RL: 81.000
1.2192	80.2883	CP1
0.0332	81.4691	Sump Level (top)
0.8569	80.6959	RL: 80.180
1.2692	78.7499	CP2
1.0739	78.9352	GAS1
2.9527	78.985	* RL (TBM K3905)
1.5236	79.2927	F9 F14
1.6950	79.1803	old TBM 3
1.7574		

BM W5006

gas level $\rightarrow$ 32.698BM level $\rightarrow$ 32.698m

BM W6110

gas level $\rightarrow$ 36.426BM level $\rightarrow$ 36.400