


No. Fail

JZ 680 Jln Dua

Rajah di muka

Stesen	BEARING / SUDUT			Dari Stn.	GARISAN	Ke Stn.	Sudut Pugak (±)	Jarak	Jarak Antara Tiang	Jarak Muktamat	
	Penyilang Kiri	Penyilang Kanan	Purata		Bearing Muktamat						
○	Datum	Dirigat		2	319 0935 Ag AC Ag 615	1	1	86.750		86.750	
2	1	319 0935	139 0935	3	37 0752	3	1	82.909		82.909	
	3	37 0752	217 0752								
2-4	35 0241			2	35 0241	4	1	75.617	pkL	75.617	
2-5	33 5057			2	33 5057	5	1	32.722	pkL	32.722	
2-6	24 2016			2	24 2016	6	1	28.708	pkL	28.708	
2-7	311 1725			2	311 1725	7	1	197.737	pkL	197.737	
1	2	139 0935	319 0935	25 4143	1	25 4143	8	1	61.388		61.388
	8	25 4143	205 4143								
1-9	47 0938			1	47 0938	9	1	8.957	pkL	8.957	
8	18	205 4143	25 4143	127 3330	8	127 3330	3	1	96.878		96.878
	3	127 3330	509 3330								
3	8	309 3330	127 3330	217 0752	3	217 0752	2	1	Sila Lihat Atas R2		
	2	217 0752	37 0752		Bering Tertutup						

J2680
T/n Dna

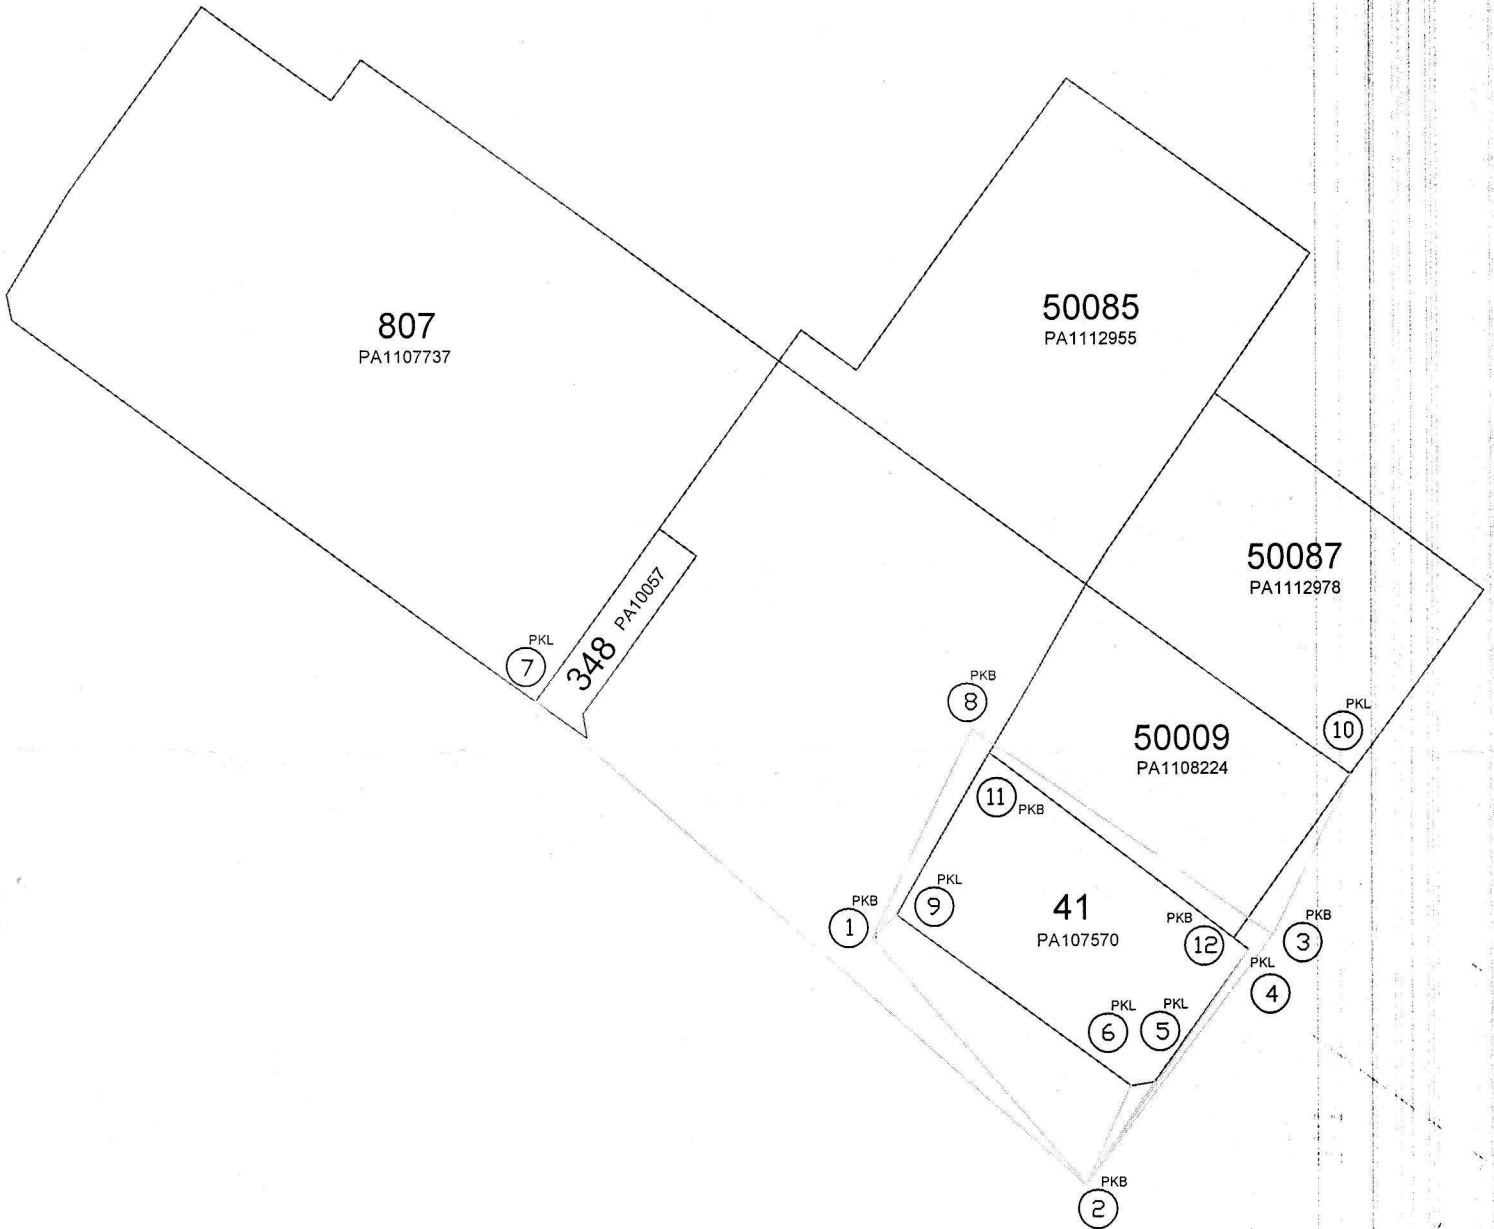

J2660 Jln Dua.

GAS /

1.2198

38.8928

TRM R3915

1.2896
~~1.4655~~

38.778

GAS /

1.4655

38.5971

F1009 / F2

2.1521

1.0823

38.9803

CP /

1.3959

39.7365

F1010 / H1

1.4217

39.7107

TRM R3196

BM W0131

GAS Level : 89.950

BM Level : 89.981

0.031

GAS /

GAS Level : 38.797

constant : 0.031

38.778