

No. Fail JZ 859 Equine,


No. Fail..

Rajah di muka

[illegible]

[illegible]

JZ659 Equine

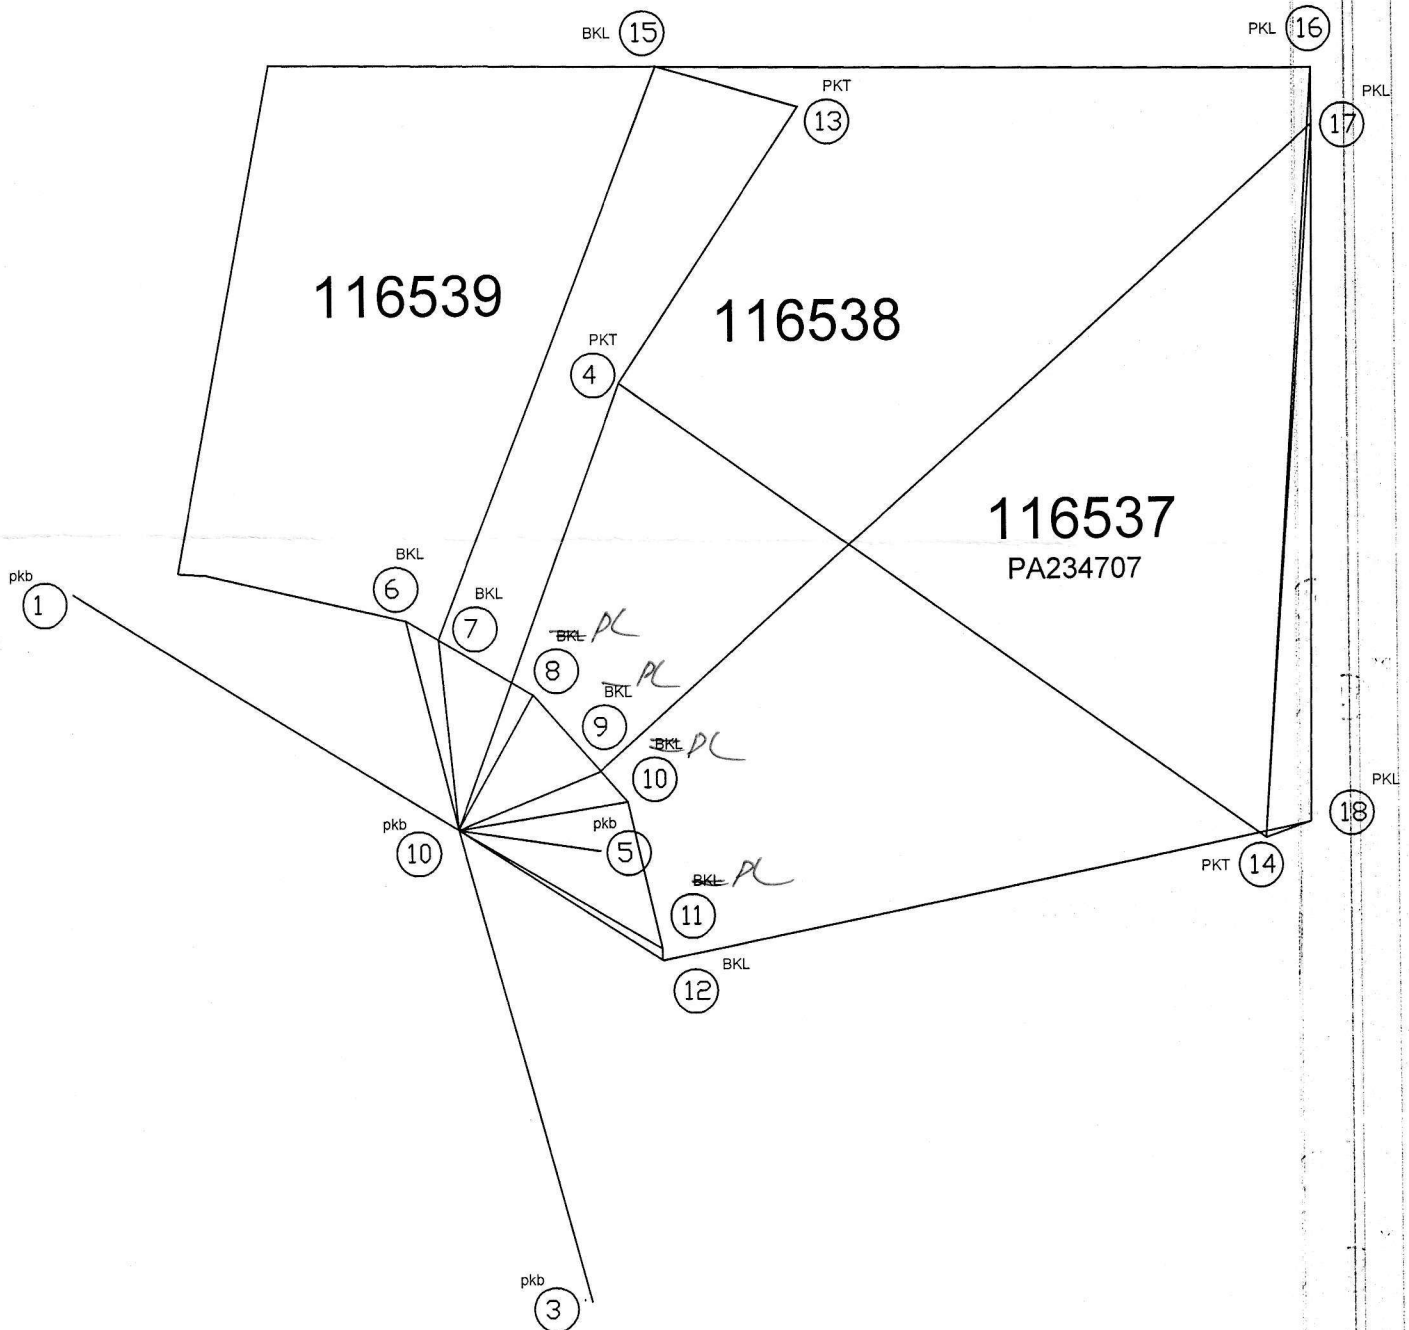

J8659 Equine.

2/197	3.5598		82209	GAS/CBL
1/98	1.7289	0.0847	85.7271	Q1
	1.6627		85.9866	TBM F3197
	1.2122		85.9368	TBM F3198
All the Core Based on			(BKL) GAS/	82209
J2/ SEC 533				
TBM J22				
RL: 61.542				