

No. Fail J2 696 Sutura

Rajah di muka

Stesen	BEARING / SUDUT			Dari Stn.	GARISAN		Ke Stn.	Sudut Pukak (±)	Jarak	Suhu	Jarak Antara Tupang	Jarak Mukamat
	Penyilang Kiri	Penyilang Kanan	Purata		Bearing Mukamat							
	Dorkim	Doripeda		2	33 16 18	1	H	40.373	17/6/29		70.323	
				pkB	Az Alt.	pkB						
					Sgn MH							
1	33 16 18	213 16 18	135 58 59	2	135 58 59	3	H	59.205			59.205	
2												
3	135 58 59	215 58 59										
	pkB											
2-4	133 11 31			2	133 11 31	4	H	78.855		pkL	78.855	
2-5	122 00 18			2	122 00 18	5	H	21.781		pkL	21.781	
2-6	41 29 42			2	41 29 42	6	H	11.362		pkL	11.362	
2-7	26 17 00			2	26 17 00	7	H	35.906		pkL	35.906	
1-8	55 20 50			1	55 20 50	8	H	15.193		pkL	15.193	
1-20	156 17 20			1	156 17 20	20	H	10.588		pkL	10.588	
	Demarcation											
2-9	137 03 10			2	137 03 10	9	H	73.187		pkB	73.187	
2-10	32 23 30			2	32 23 30	10	H	17.739		pkB	13.739	
2-11	152 46 40			2	152 46 40	11	H	38.42		pkB	38.42	
3-12	32 01 22			3	32 01 22	12	H	21.761		pkB	21.761	

J2696 Sutera

0.7953

02.2303

F1/TBM F9101

1.2816

1.8272

01.7989 -

F2

1.3910

01.039 -

F3/TBM F9102

BM B0991

GPS Level: 46.617 M

BM Level: 46.610 M

0.007

TBM F 9102

GPS Level: 01.076

- 0.007


01.039

JZ696 Sutura

5-7356 38 10 43.814(New)

356 36 18 43.804(Po)

1 52 0.010

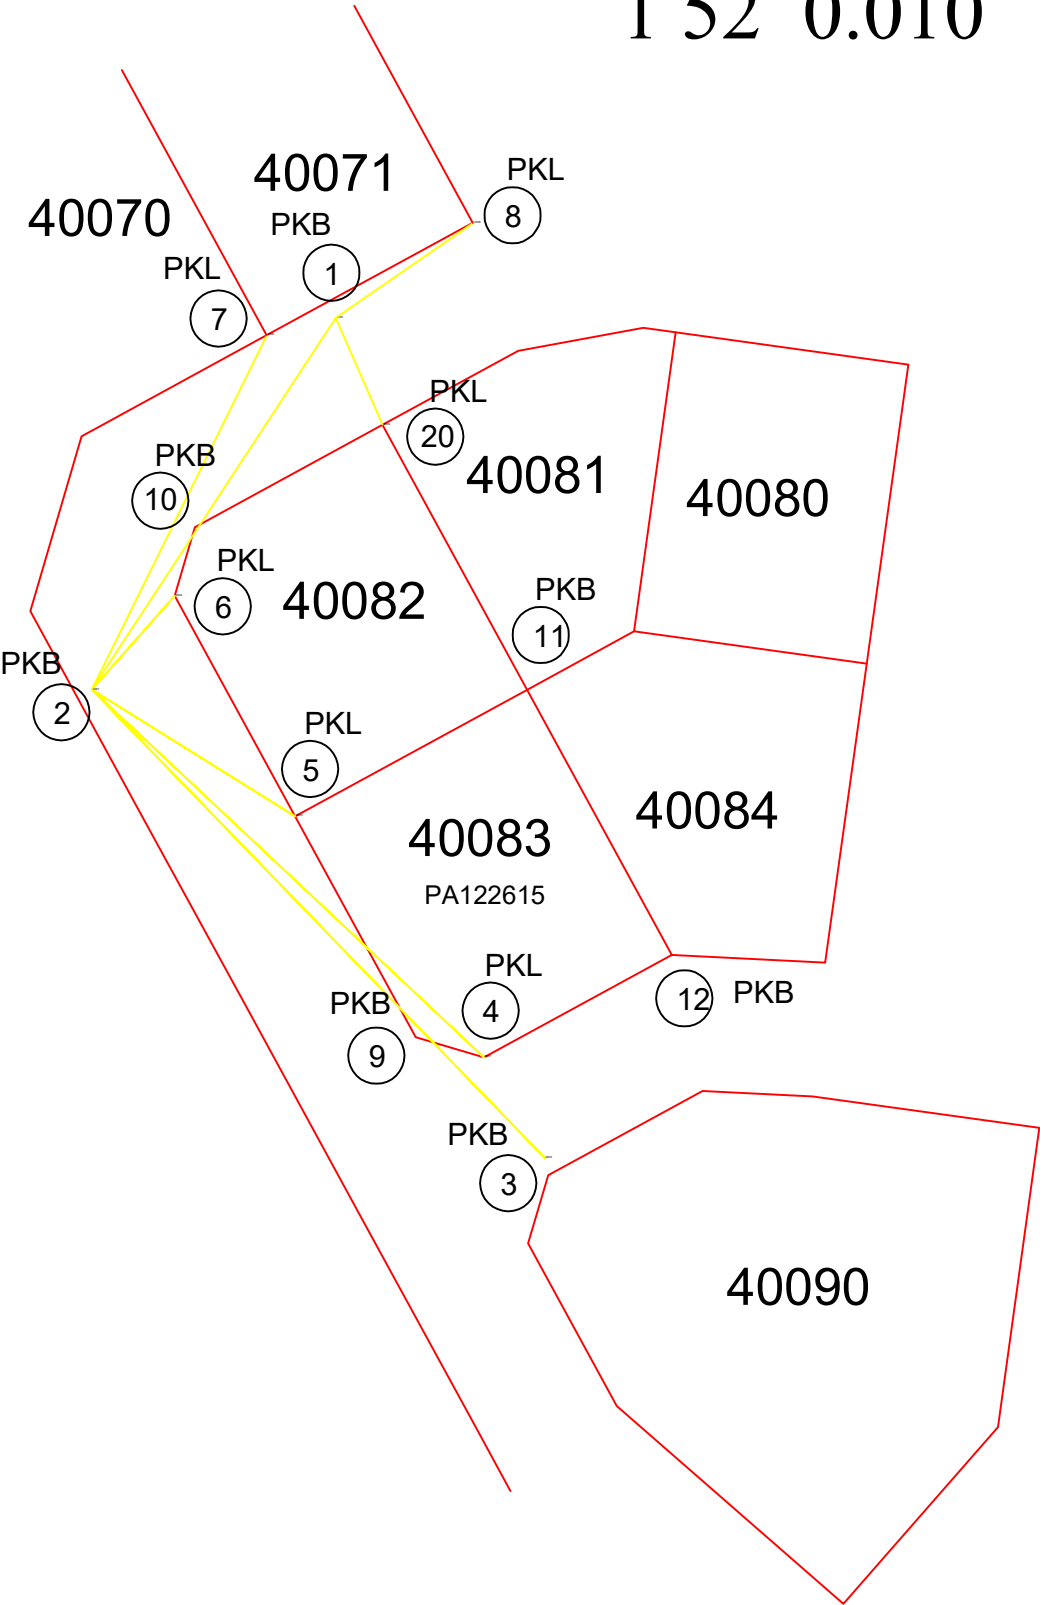

Penilik: JZ696 Sutura Tarikh: 20/06/2024
 Stn. 2 Koordinat: S13370 B4525 Selangor
 T.R. 1 B.K. Ms.
 Tiodolit Satu bah. aras ufuk:

Waktu	Sasaran	Ufuk	Gelembong	Puguk		
	T.R.	80 00 00				
9 05	M.H.	112 12 57		63 06 51	Waktu purata	9 05 30
9 05	M.H.	111 36 24		63 00 02	Beza dari U.T. -	8 00 00
9 06	M.H.	291 35 12		297 06 34	U.T.	1 05 30
9 06	M.H.	292 09 32		297 12 16	Deklinasi	23 26 11
	T.R.	260 00 00				

	T.R.	80 00 00				
9 07	M.H.	112 07 37		62 36 35	Waktu purata	9 07 30
9 07	M.H.	111 30 44		62 29 53	Beza dari U.T. -	8 00 00
9 08	M.H.	291 29 28		297 37 22	U.T.	1 07 30
9 08	M.H.	292 03 44		297 44 27	Deklinasi	23 26 11
	T.R.	260 00 00				

	Set 1	Set 2
Sudut pugak	27 02 59	27 33 50
Pembetulan	- 0 01 35	- 0 01 33
Altitud	27 01 24	27 32 17
Jarak kutub	66 33 49	66 33 49
Latitud	3 03 12	3 03 12
Azimut M.H. yang dikira	65 10 17	65 04 43
Purata ke M.H.	111 53 31	111 47 53
Selisih:	- 46 43 14	- 46 43 10
Purata ke T.R.	80 00 00	80 00 00
Azimuth T.R. sebenar	33 16 46	33 16 50
Pembetulan aras	+ 0 00 00	+ 0 00 00
Tirusan	- 0 00 30	- 0 00 30
Bering grid T.R.	33 16 16	33 16 20


Purata bering grid T.R. 33 16 18

JZ696 Sutura

5-7 356 38 10 43.814(New)

356 36 18 43.804(Po)

1 52 0.010

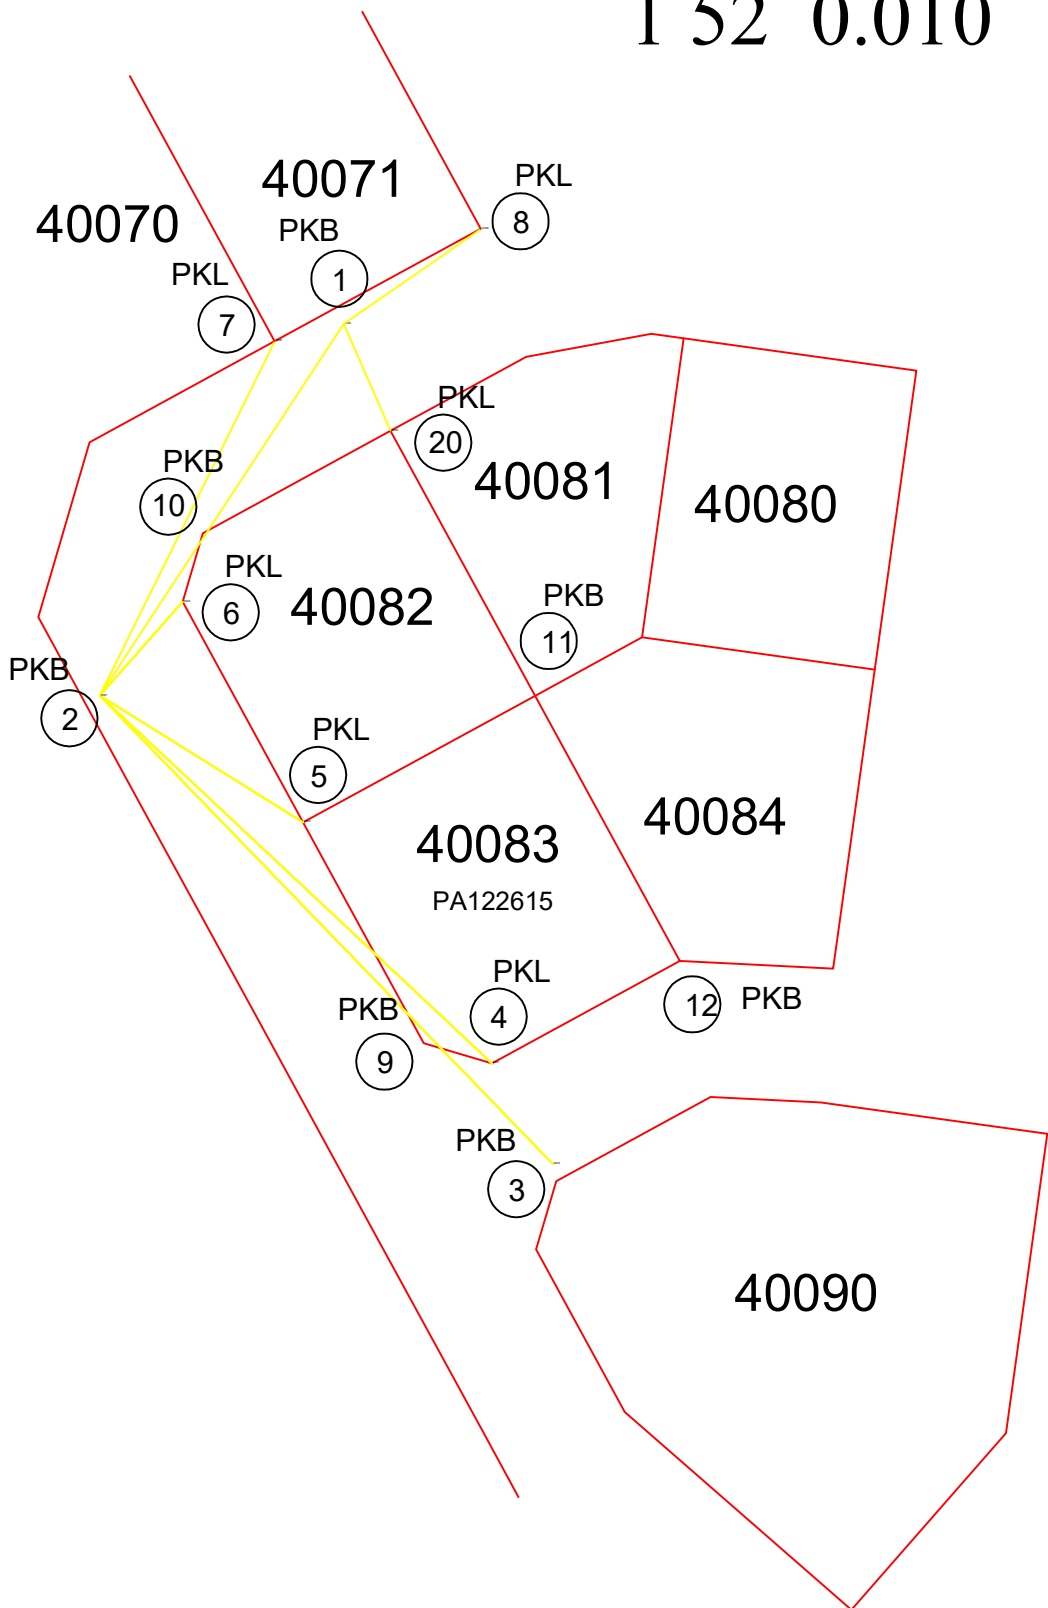

Penilik: JZ696 Sutera Tarikh: 20/06/2024
 Stn. 2 Koordinat: S13370 B4525 Selangor
 T.R. 1 B.K. Ms.
 Tiodolit Satu bah. aras ufuk:

Waktu	Sasaran	Ufuk	Gelembong	Puguk		
	T.R.	80 00 00				
9 05	M.H.	112 12 57		63 06 51	Waktu purata	9 05 30
9 05	M.H.	111 36 24		63 00 02	Beza dari U.T. -	8 00 00
9 06	M.H.	291 35 12		297 06 34	U.T.	1 05 30
9 06	M.H.	292 09 32		297 12 16	Deklinasi	23 26 11
	T.R.	260 00 00				

	T.R.	80 00 00				
9 07	M.H.	112 07 37		62 36 35	Waktu purata	9 07 30
9 07	M.H.	111 30 44		62 29 53	Beza dari U.T. -	8 00 00
9 08	M.H.	291 29 28		297 37 22	U.T.	1 07 30
9 08	M.H.	292 03 44		297 44 27	Deklinasi	23 26 11
	T.R.	260 00 00				

	Set 1	Set 2
Sudut pugak	27 02 59	27 33 50
Pembetulan	- 0 01 35	- 0 01 33
Altitud	27 01 24	27 32 17
Jarak kutub	66 33 49	66 33 49
Latitud	3 03 12	3 03 12
Azimut M.H. yang dikira	65 10 17	65 04 43
Purata ke M.H.	111 53 31	111 47 53
Selisih:	- 46 43 14	- 46 43 10
Purata ke T.R.	80 00 00	80 00 00
Azimuth T.R. sebenar	33 16 46	33 16 50
Pembetulan aras	+ 0 00 00	+ 0 00 00
Tirusan	- 0 00 30	- 0 00 30
Bering grid T.R.	33 16 16	33 16 20

Purata bering grid T.R. 33 16 18