

No. Fail J2700 Putra Murni

Rajah di muka

Stesen	BEARING / SUDUT			Dari Stn.	GARISAN		Ke Stn.	Sudut Pukak (±)	Jarak	Suhu	Jarak Antara Pupang	Jarak Muktammat
	Penyilang Kiri	Penyilang Kanan	Purata		Bearing Muktammat							
	Datum Darigada			1	109 49 27 A3 Ak. Dgn MY		2	4	57.322			57.322
2	109 49 27	289 49 27	16 07 52	1	16 07 52		3	4	96.025			96.025
3	16 07 52	196 07 52										
	pkB											
1-4	192 29 85			1	192 29 85		4	4	28.089		pkLE	28.089
1-5	1 26 52			1	1 26 52		5	4	25.778		pkLE	25.778
3-6	210 49 09			3	210 49 09		6	4	28.883		pkLE	28.883
3-7	20 59 19			3	20 59 19		7	4	16.086		pkLE	16.086


JZ 700 Putra Murni

1.3376	29.779	GPS 1
1.3531	29.7285	TBM F9105
1.4532	29.6289	F1009
1.3989	29.6827	F1005
1.4942	29.5879	TBM F9100/P2

BM 62067
 GPS Level : 17.897
 BM Level : 17.791
 0.106

GPS 1
 GPS Level : 29.850
 - 0.106
 29.744

JZ700 Putra Murni

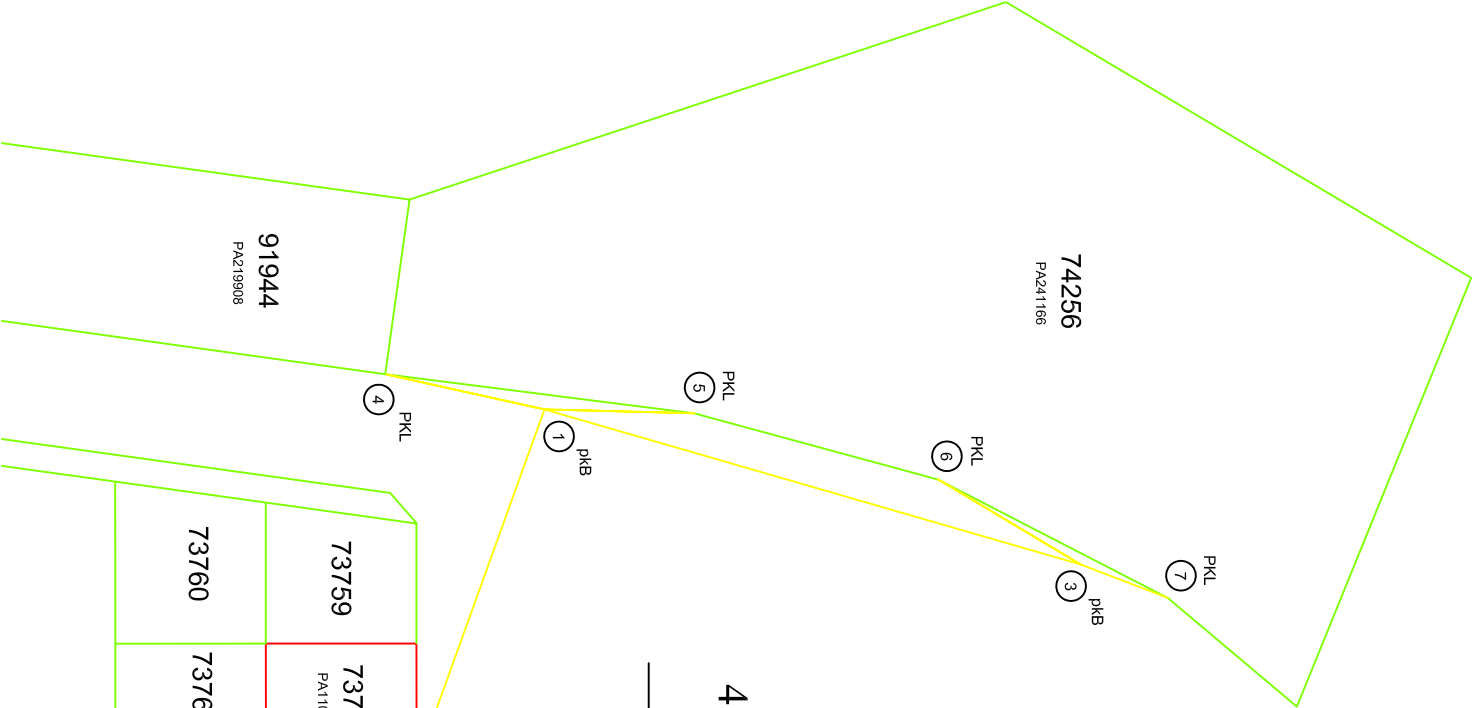

74256
PA241166

PKL
⑤

pKB
①

PKL
⑥

pKB
③

PKL
⑦

PKL
④

pKB
②

4-7 15 57 39 140.046 (New)
15 57 47 140.056(Po)

12 -0.010

73759	73758 PA110254	73758	73757	73756
73760	73761	73762	73763	73764

Penilik: JZ700 Putra Murni Tarikh: 22/07/2024

Stn. 2 Koordinat: S17683 B14214 Selangor

T.R. 1 B.K. Ms.

Tiodolit Satu bah. aras ufuk:

Waktu	Sasaran	Ufuk	Gelembong	Puguk
	T.R.	330 00 00		
9 47	M.H.	107 33 46	53 50 01	Waktu purata 9 47 30
9 47	M.H.	106 53 17	53 45 19	Beza dari U.T. - 8 00 00
9 48	M.H.	286 51 29	306 20 29	U.T. 1 47 30
9 48	M.H.	287 29 12	306 27 13	Deklinasi 20 12 00
	T.R.	150 00 00		

	T.R.	330 00 00		
9 45	M.H.	107 41 32	54 22 01	Waktu purata 9 45 30
9 45	M.H.	107 01 02	54 15 26	Beza dari U.T. - 8 00 00
9 46	M.H.	286 59 01	305 51 30	U.T. 1 45 30
9 46	M.H.	287 36 16	305 59 04	Deklinasi 20 12 01
	T.R.	150 00 00		

	Set 1	Set 2
Sudut pugak	36 18 06	35 48 17
Pembetulan	- 0 01 04	- 0 01 05
Altitud	36 17 02	35 47 12
Jarak kutub	69 48 00	69 47 59
Latitud	3 00 51	3 00 51
Azimut M.H. yang dikira	67 01 37	67 09 04
Purata ke M.H.	107 11 56	107 19 28
Selisih:	- 40 10 19	- 40 10 24
Purata ke T.R.	330 00 00	330 00 00
Azimuth T.R. sebenar	289 49 41	289 49 36
Pembetulan aras	+ 0 00 00	+ 0 00 00
Tirusan	- 0 00 13	- 0 00 13
Bering grid T.R.	289 49 28	289 49 23
Purata bering grid T.R.	289 49 26	