

Rajah di muka

Stesen	BEARING / SUDUT			Dari Stn.	GARISAN	Ke Stn.	Sudut Pukak (±)	Jarak	Suhu	Jarak Antara Utama	Jarak Mukamat
	Penyilang Kiri	Penyilang Kanan	Purata		Bearing Mukamat						
	Datym	Danipada		2	322 1138	1	H	36.728			36.728
				2	237 2907	3	H	17.620			17.620
				2	291 0091	7	H	15.451		BKL	15.451
				2	320 5737	5	H	0.872		BKL	0.872
				1	78 5822	6	H	2.812		BKL	2.812
				1	290 2916	7	H	12.937		BKL	12.937

J2 709

1.5373

1.5195

33.9183

TBM F9111

33.933

TBM F9110

BM B2891

GPS Level: 55.727

BM Level: 55.729

0.003


TBM F9110

GPS Level: 33.936

constant: 0.003

33.933

JZ704 Bkt Angkat

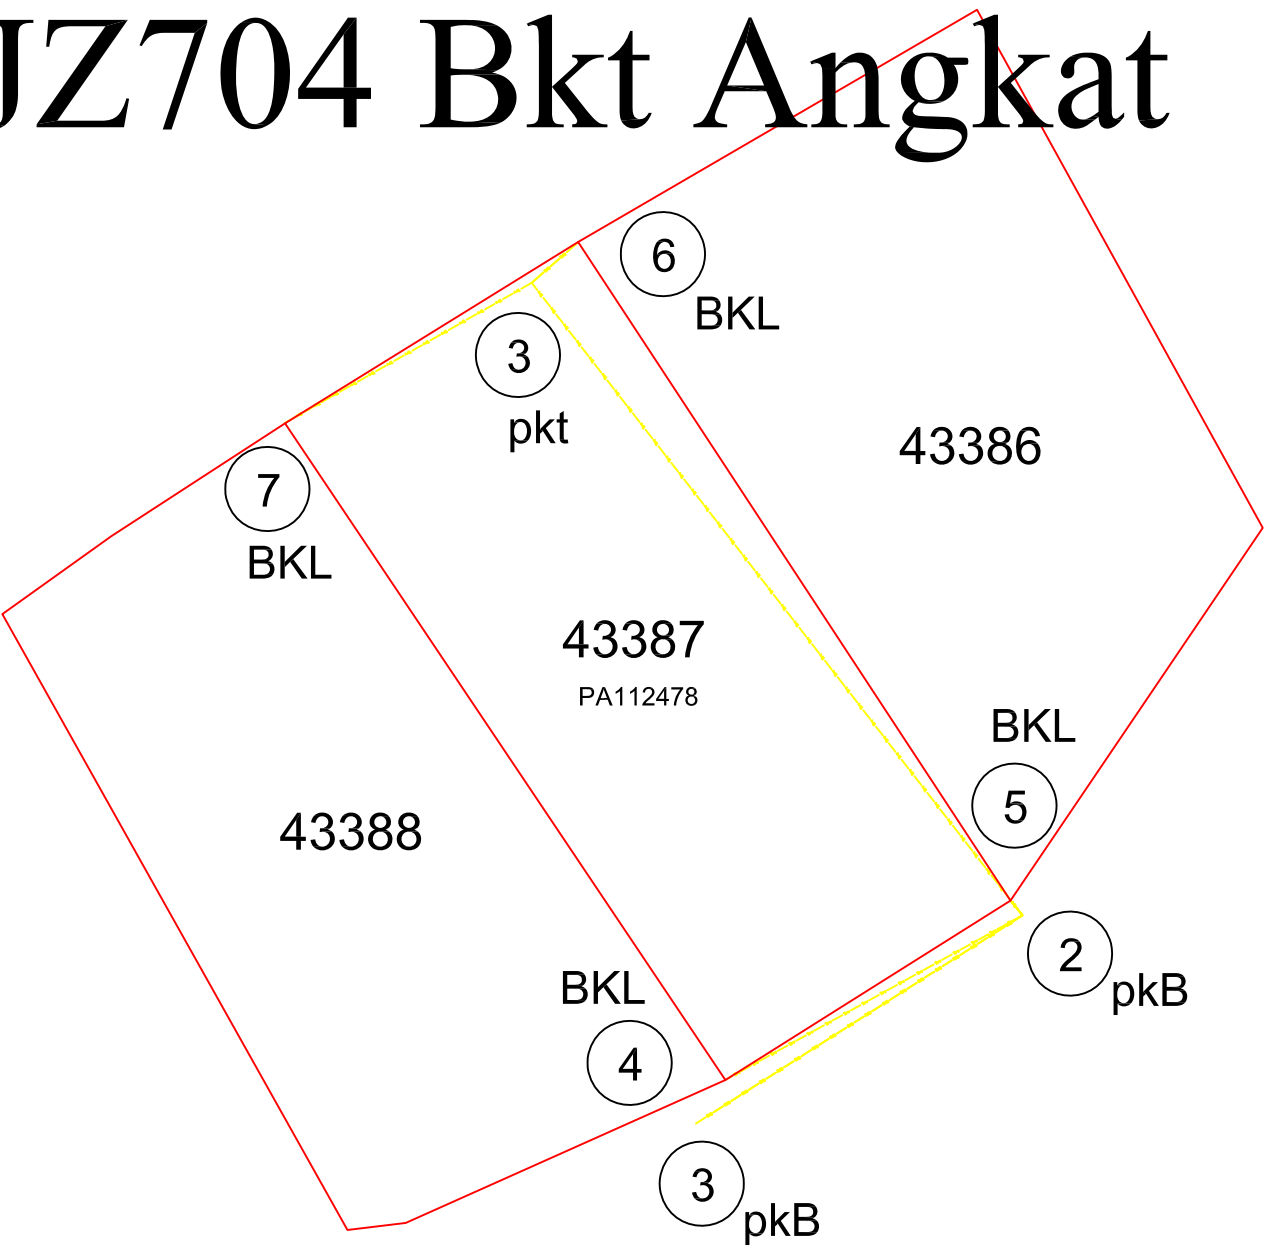

4-6	350 02 16	38.700(New)
	350 01 54	38.711(Po)
	20	-0.011