

J# 709 Jjak.

Rajah di muka

[illegible]

JZ709 Ijok.

1.4750

7.053

7BM F4112

1.1746

7.3239

7BM F4113

BM B0968

GPS Level: 5.975

BM Level: 5.639

0.306


7BM F4112

GPS Level: 7.359

const. : 0.306

7.053

JZ709 ijok

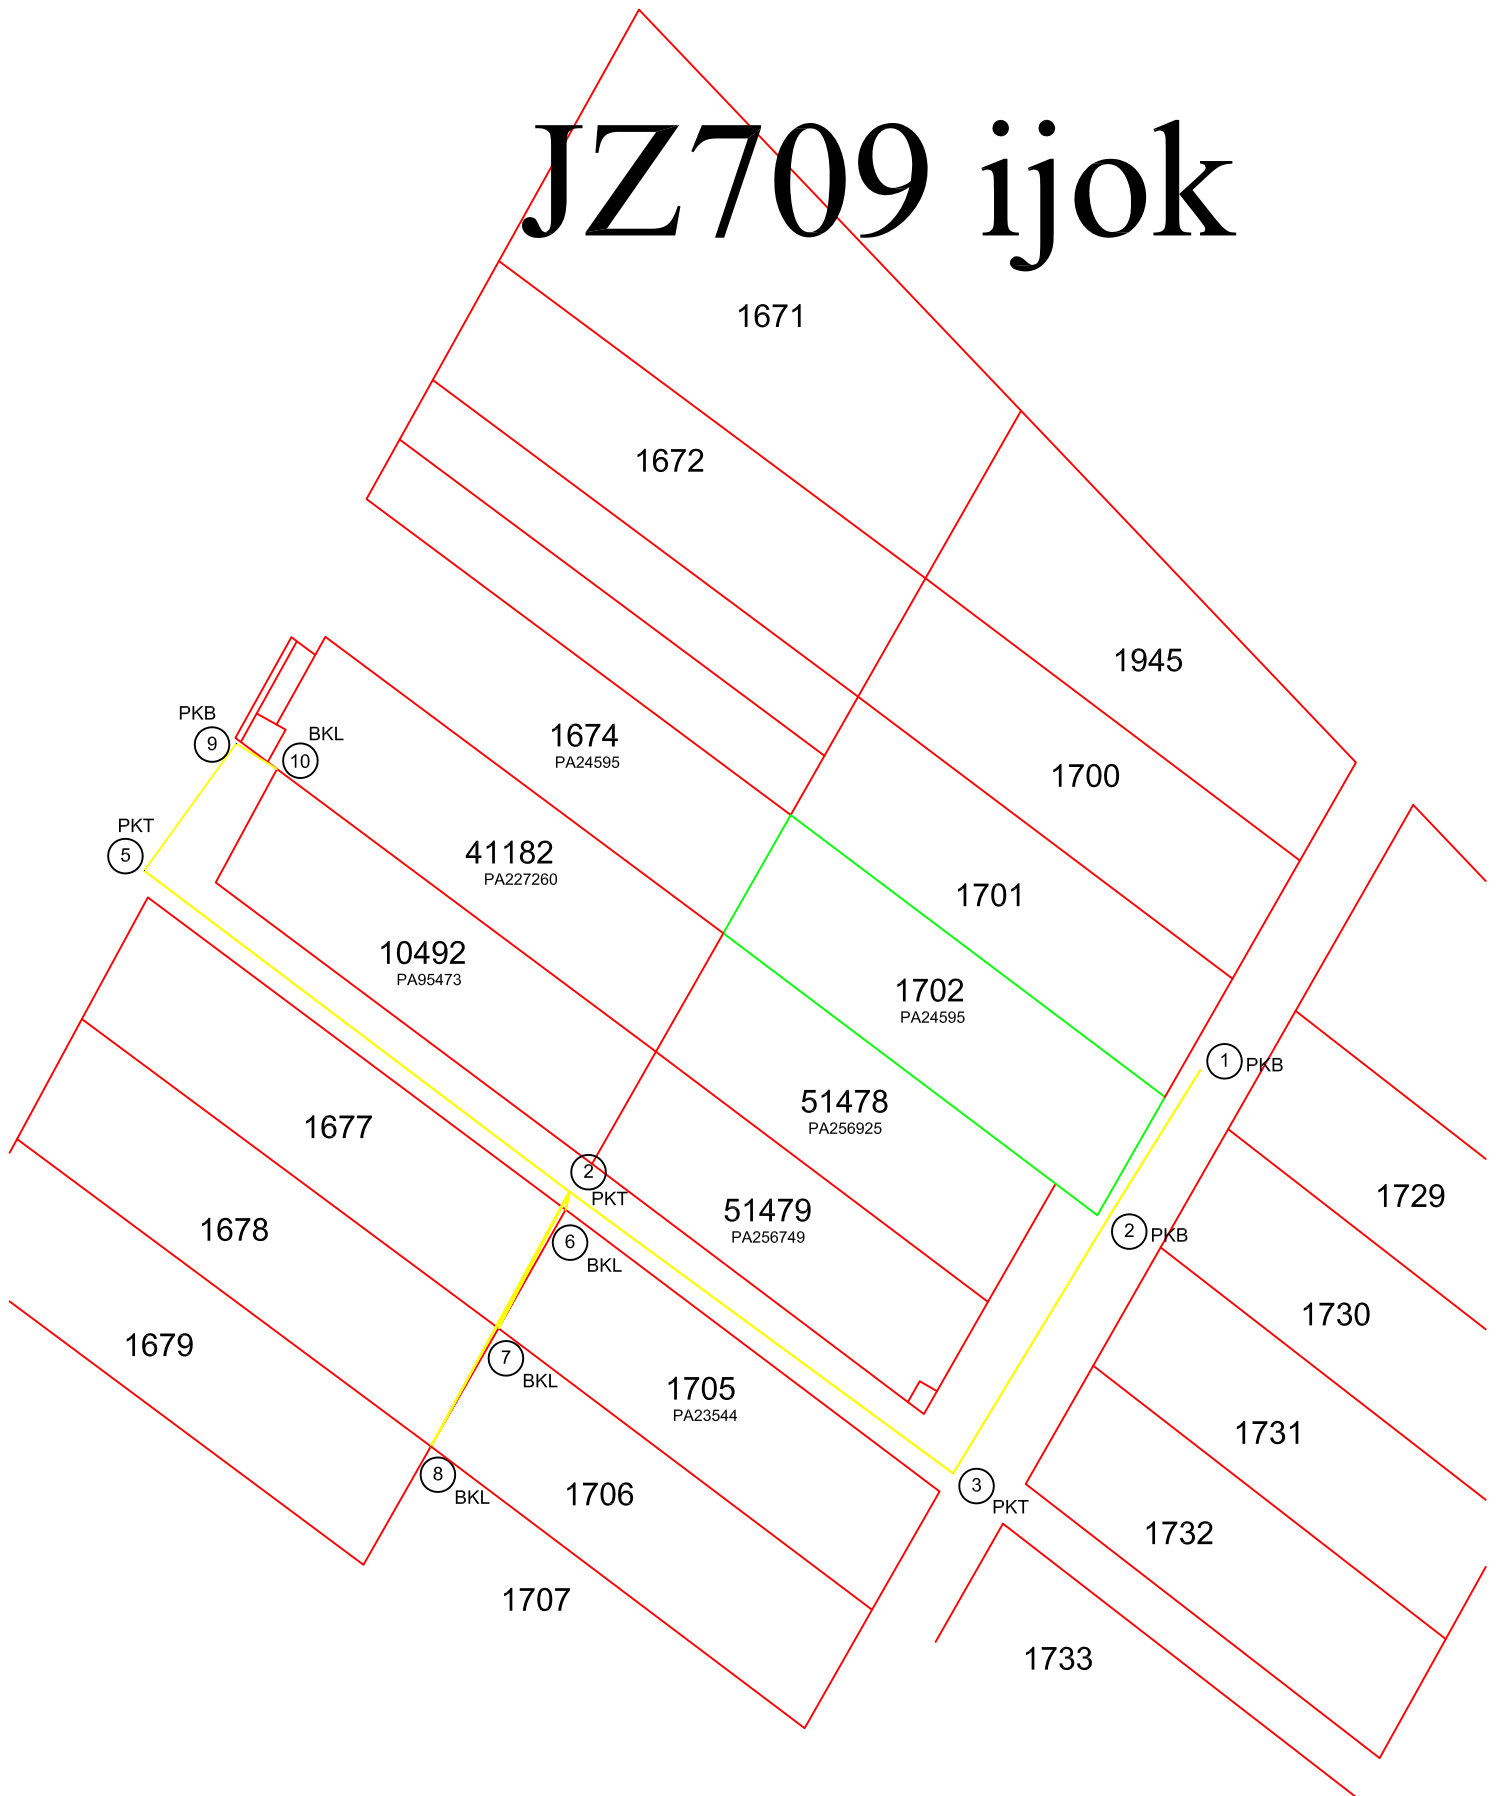

10-7	158 24 45	266.485(New)
	158 24 38	266.475(Po)
	17	0.010