

J2715 Dqmai 6

Rajah di muka

No. Fail


No. Fail												
Stesen	BEARING / SUDUT			Dari Stn.	GARISAN		Ke Stn.	Sudut Pukak (±)	Jarak	Suhu	Jarak Antara Tupang	Jarak Muktamat
	Penyilang Kiri	Penyilang Kanan	Purata		Bearing Muktamat							
	Datum Danipada			2	23931	1	H	83.557	6/12/27		83.557	
					A3 Ak.							
					Dgn MH							
1	23931	1823931	3091122	2	3091122	3	H	78.175			78.175	
2	3	3091122	K91122									
1	Seperti Di Atas 2723907			2	2723907	7	H	117.537			117.537	
2	7	2723907	923907									
	pk.											
2-5	15110			2	15110	5	H	37.076	pkB 7BM		37.076	
2-6	2870558			2	2870558	6	H	62.953	pkB 7BM		62.953	
3-7	172108			3	172108	7	H	17.761	pkLE		17.761	
2-8	2317630			2	2317630	8	H	9.700	pkLE		9.700	
4-9	923907	2723907	2753037	7	2753037	9	H	72.772			72.772	
4	9	2753037	953037									
	pkB											
4-10	333100			7	333100	10	H	20.020	pkL		20.020	
9-11	982100			9	982100	11	H	10.370	pkLE		10.370	
9-12	1393900			9	1393900	12	H	15.450	pkLE		15.450	
	Demarcation.											
3-13	679051			3	679051	13	H	30.197	pkB		30.197	
3-14	1175519			3	1175519	14	H	30.851	pkB		30.851	
3-15	1292512			3	1292512	15	H	29.272	pkB		29.272	
3-16	233227			3	233227	16	H	18.900	pkB		18.900	

Penilik: JZ715 Damai6 Tarikh: 06/12/2024
 Stn. 2 Koordinat: S1208 T2306 Selangor
 T.R. 1 B.K. Ms.
 Tiodolit Satu bah. aras ufuk:

Waktu	Sasaran	Ufuk	Gelembong	Puguk		
	T.R.	170 00 00				
9 44	M.H.	108 26 39		54 31 02	Waktu purata	9 44 30
9 44	M.H.	107 49 20		54 25 50	Beza dari U.T. -	8 00 00
9 45	M.H.	287 52 04		305 39 25	U.T.	1 44 30
9 45	M.H.	288 35 36		305 47 02	Deklinasi -	22 31 47
	T.R.	350 00 00				
	T.R.	170 00 00				
9 47	M.H.	108 46 13		53 51 31	Waktu purata	9 47 30
9 47	M.H.	108 08 51		53 47 00	Beza dari U.T. -	8 00 00
9 48	M.H.	288 12 30		306 21 24	U.T.	1 47 30
9 48	M.H.	288 56 37		306 28 41	Deklinasi -	22 31 48
	T.R.	350 00 00				

	Set 1	Set 2
Sudut pugak	35 37 24	36 17 54
Pembetulan	- 0 01 06	- 0 01 04
Altitud	35 36 18	36 16 50
Jarak kutub	112 31 47	112 31 48
Latitud	3 09 48	3 09 48
Azimut M.H. yang dikira	120 46 04	121 06 19
Purata ke M.H.	108 10 55	108 31 03
Selisih:	12 35 09	12 35 16
Purata ke T.R.	170 00 00	170 00 00
Azimuth T.R. sebenar	182 35 09	182 35 16
Pembetulan aras	+ 0 00 00	+ 0 00 00
Tirusan	- 0 00 43	- 0 00 43
Bering grid T.R.	182 34 26	182 34 33
Purata bering grid T.R.	182 34 30	

JZ715 DAMAI 6

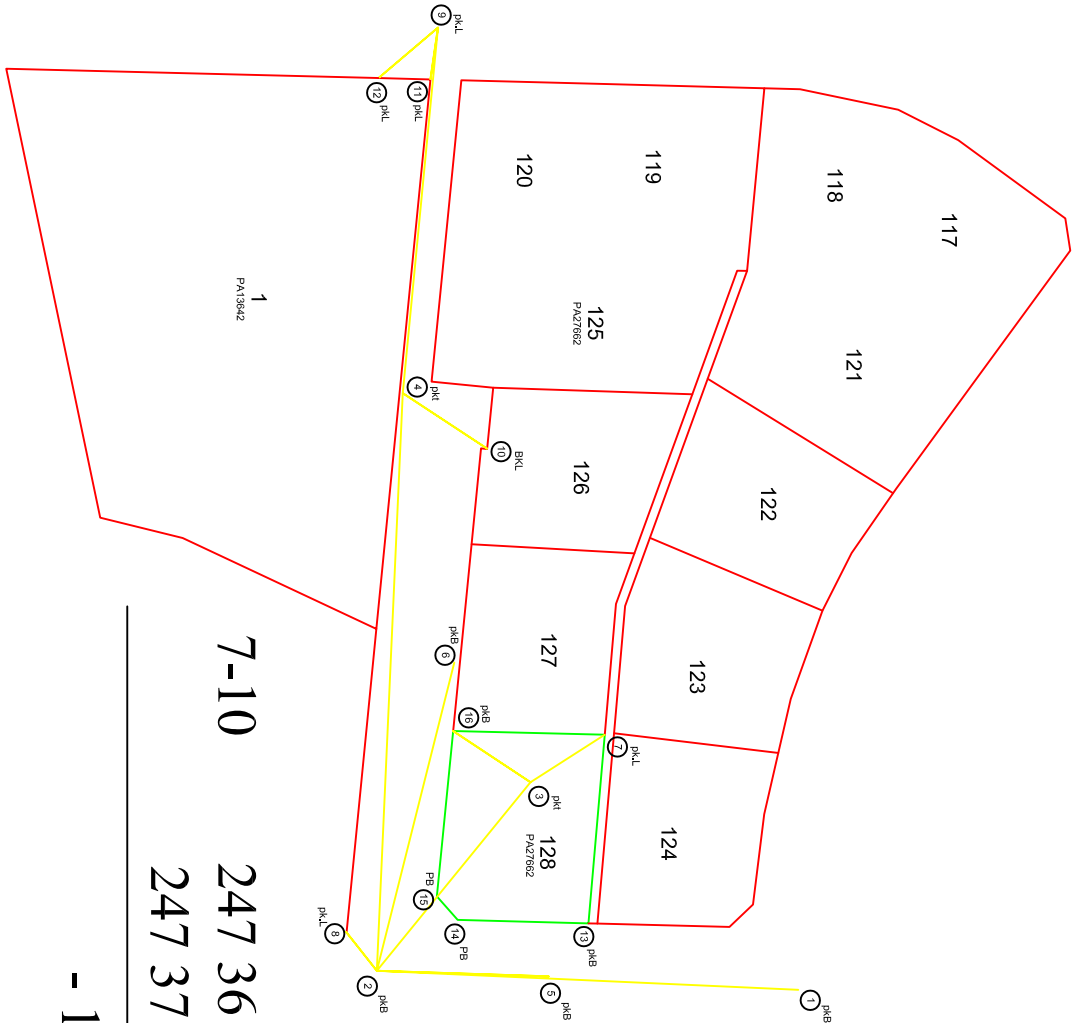

7-10	247 36 30	61.220(New)
	247 37 18	61.201(Po)

- 1 12 0.019