

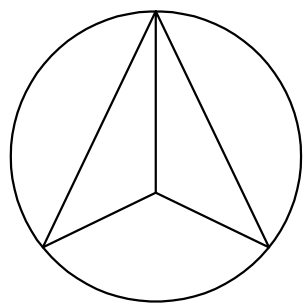
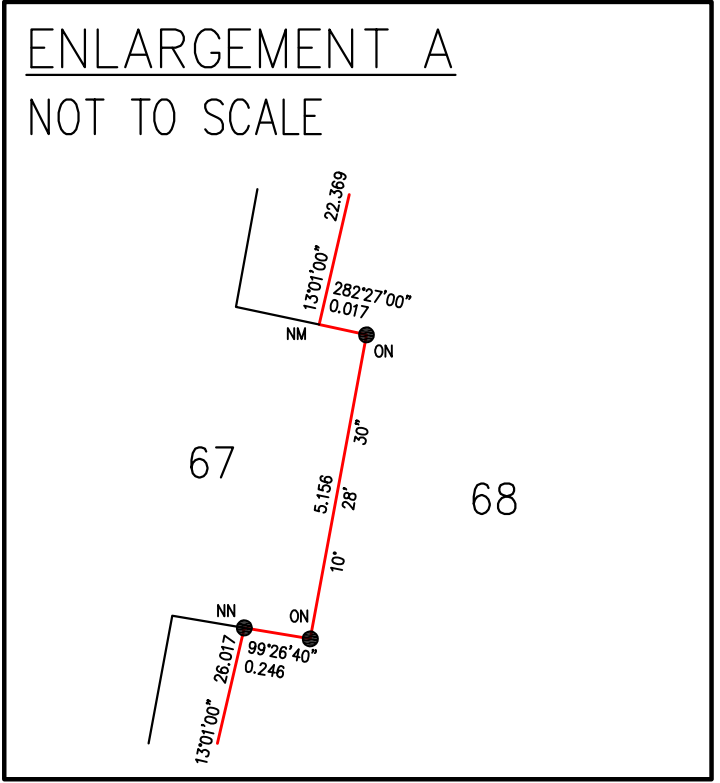
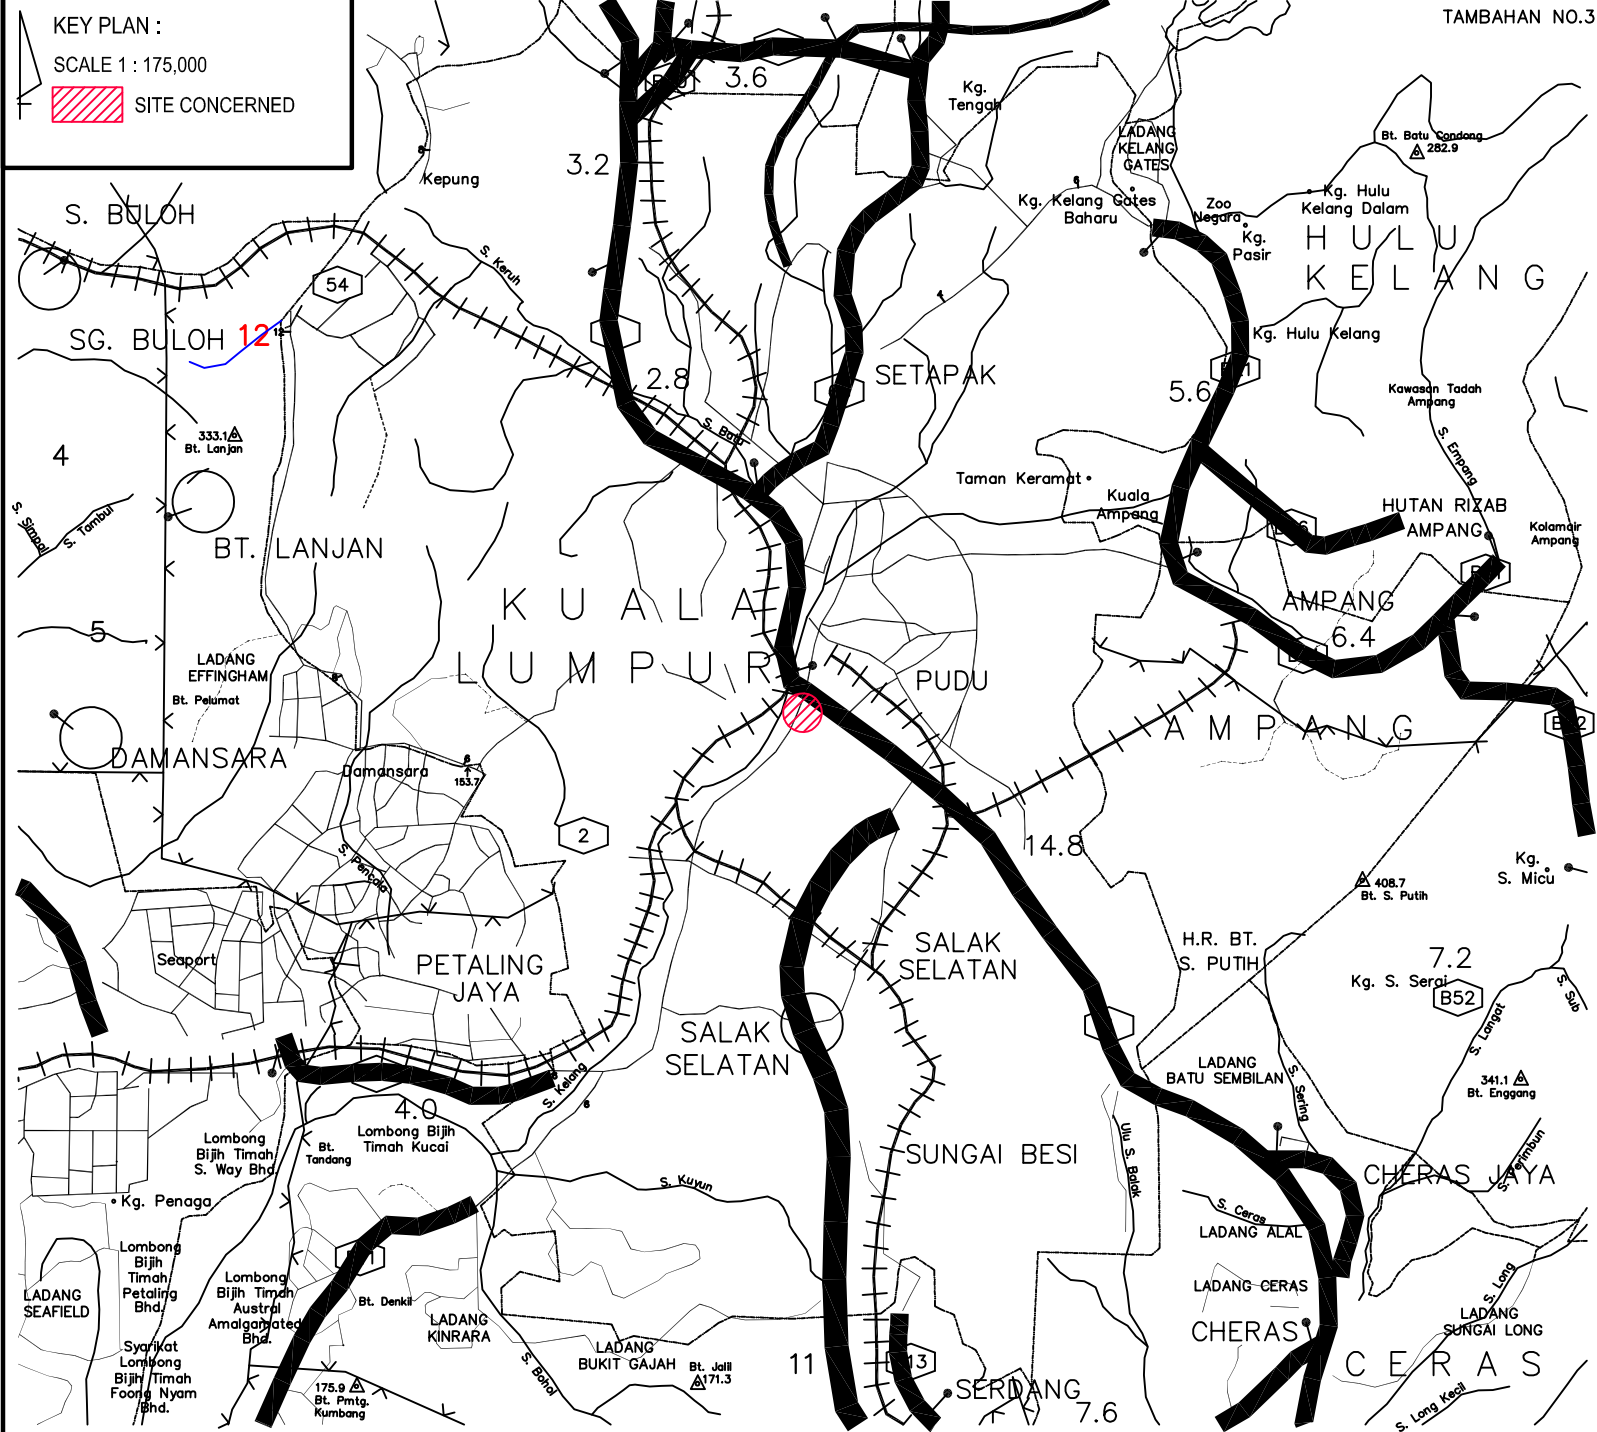


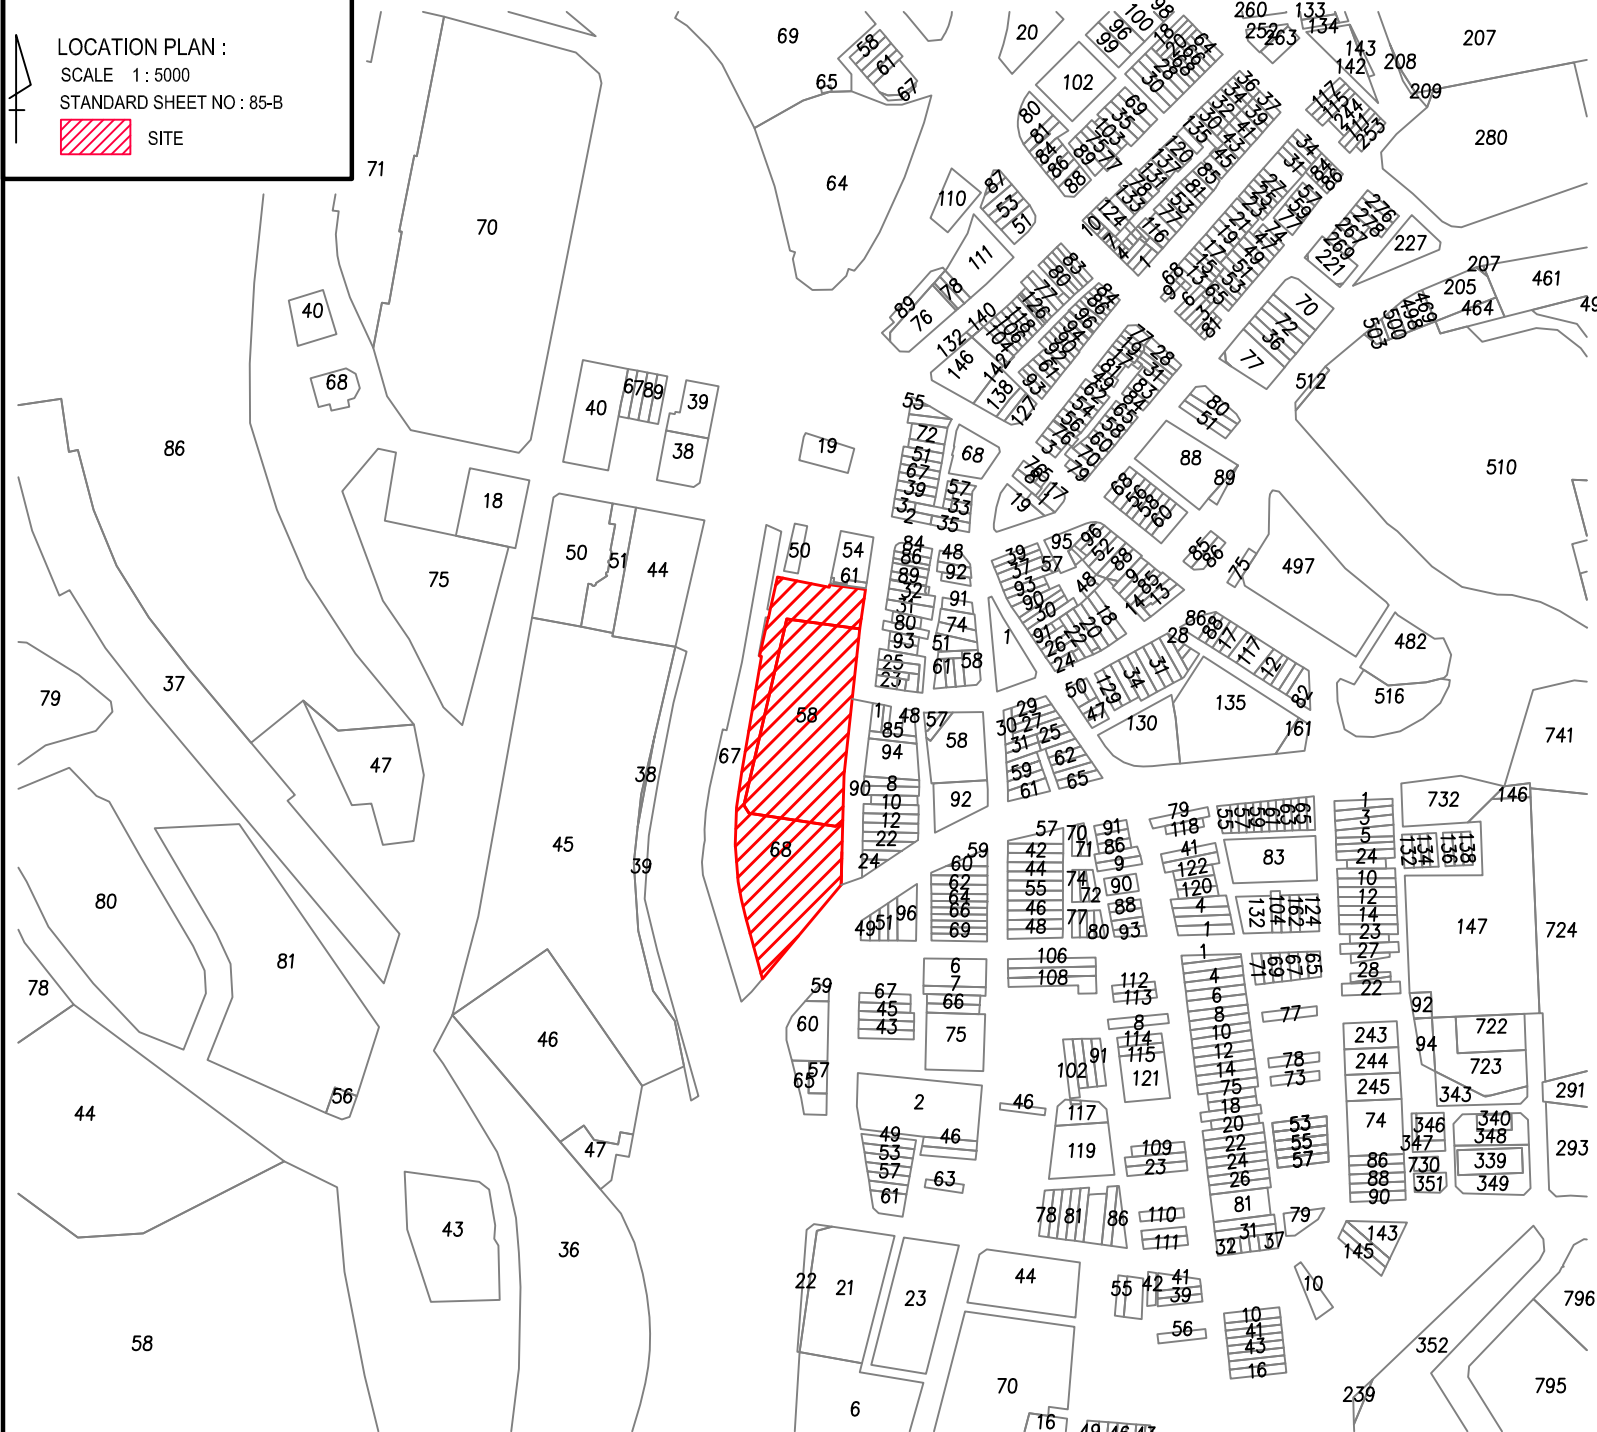

SCALE 1 : 500
STANDARD SHEET NO : 85 - B

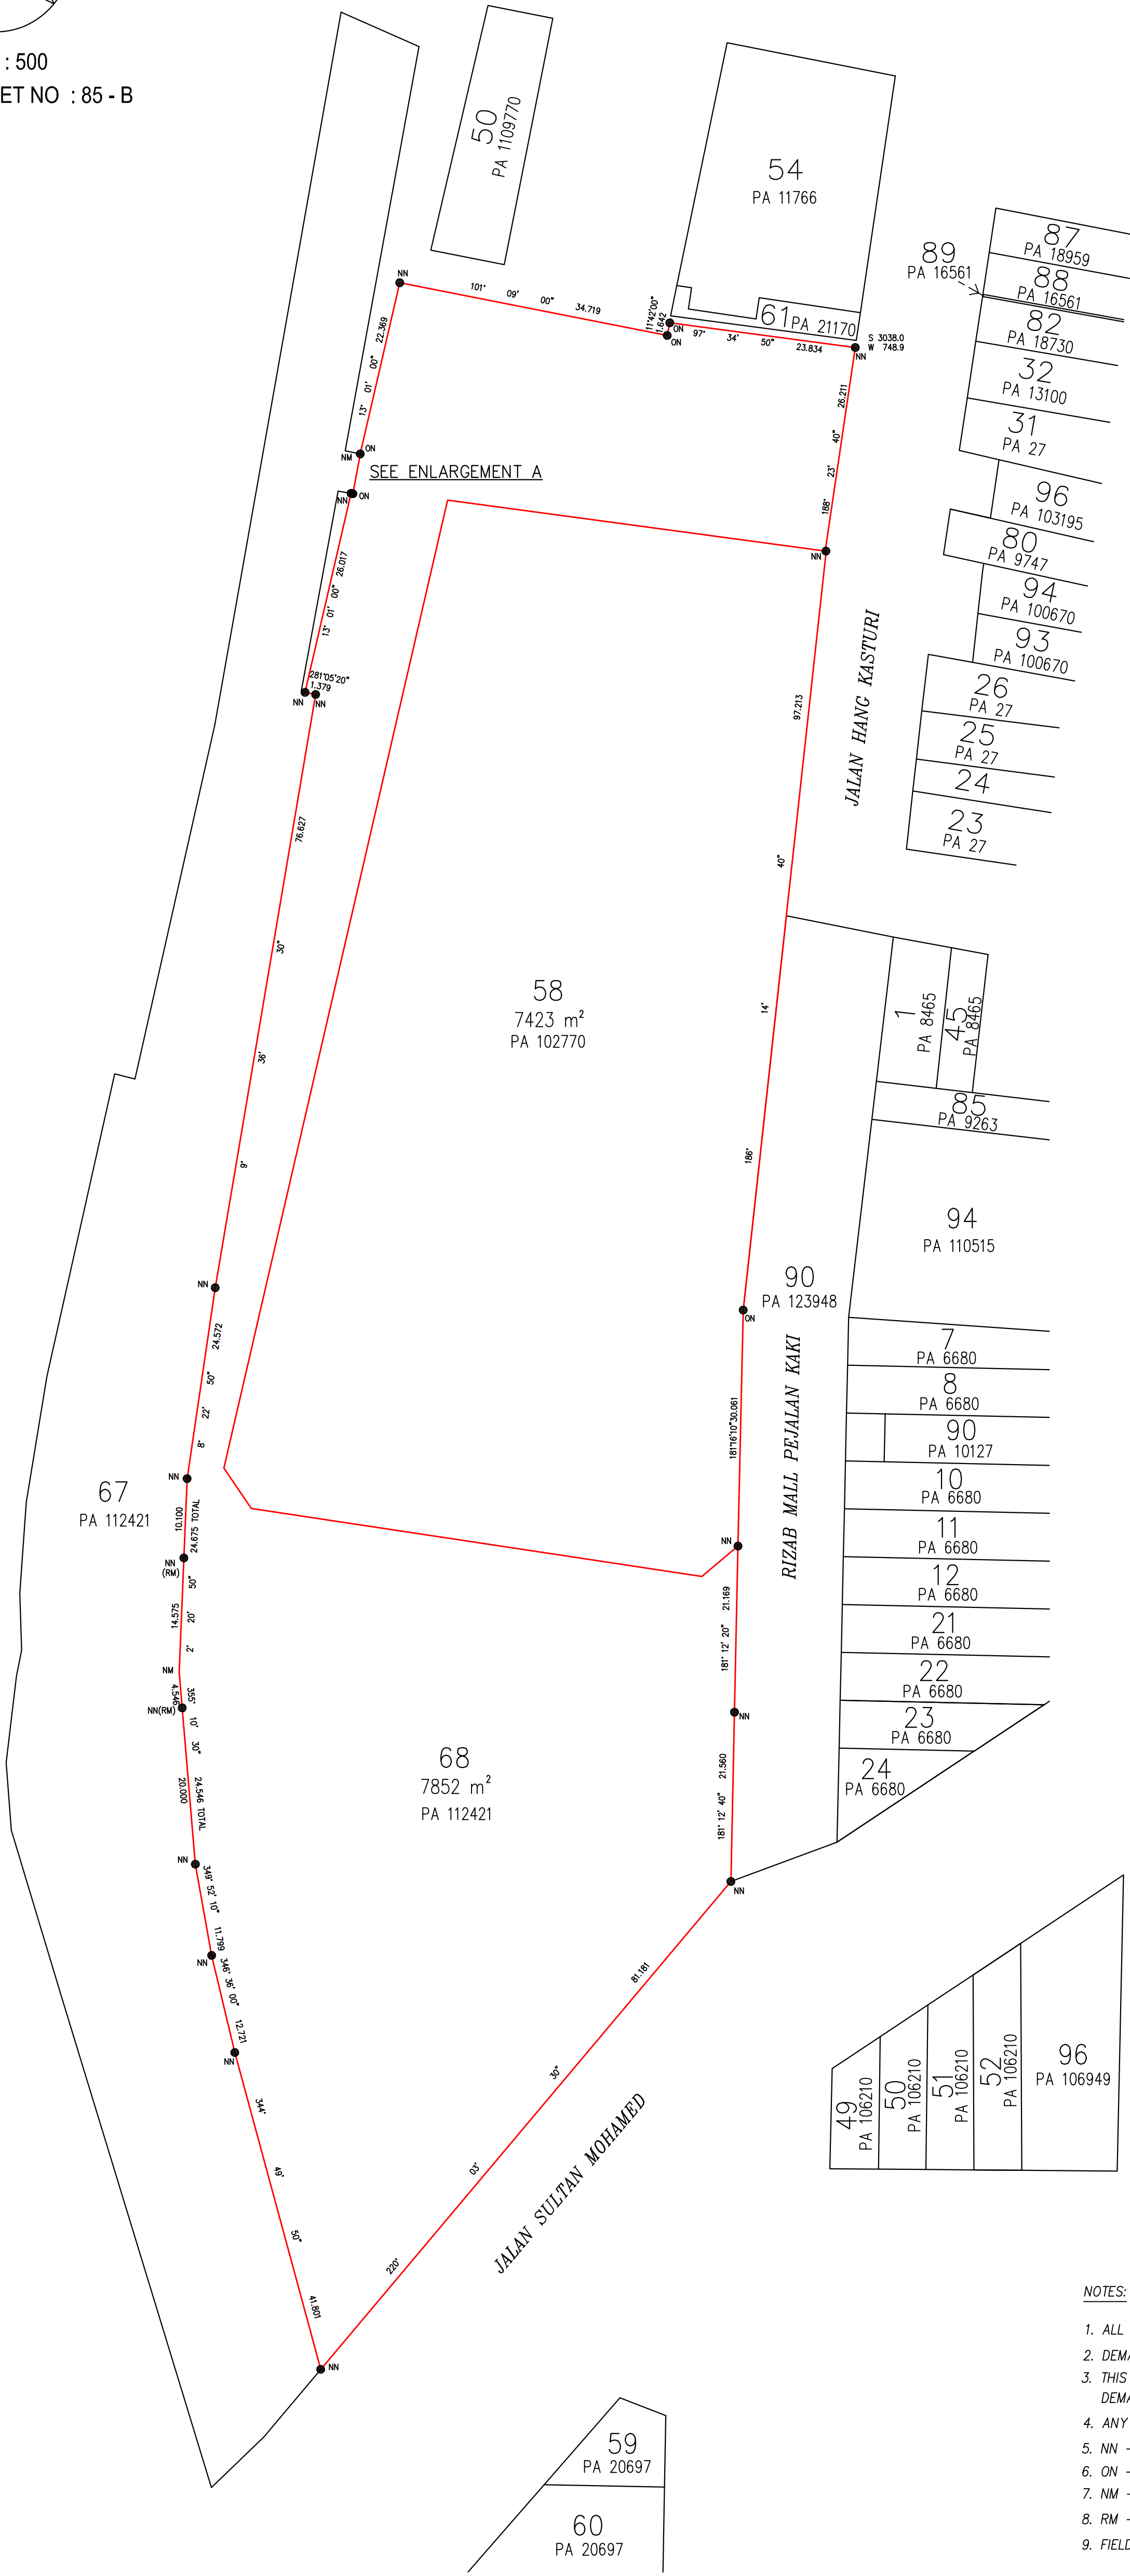

- NOTES:
- ALL MEASUREMENTS ARE SHOWN IN METRES.
 - DEMARCATON SURVEY IS DONE BASED ON CERTIFIED PLANS, NO.: PA 102770 , PA 112421 AND PA 123948.
 - THIS DEMARCATON SURVEY IS NOT A TITLE SURVEY.
DEMARCATON SURVEY VALUES ARE WITHIN THE ACCEPTABLE LIMIT ONLY.
 - ANY DISCREPANCY FOUND IN THIS SURVEY PLAN SHALL BE REFERRED TO AND TO BE VERIFIED BY THE SURVEYOR IN-CHARGE.
 - NN - NEW NAIL
 - ON - OLD NAIL
 - NM - NO MARK
 - RM - REFERENCE MARK
 - FIELD BOOK NO. - 75

BOUNDARY DEMARCATON SURVEY ON LOT 68
AND PART OF LOT 58, SECTION 31
TOWN OF KUALA LUMPUR
WILAYAH PERSEKUTUAN KUALA LUMPUR

LICENSED LAND SURVEYOR :		PREPARED BY : JURUKUR ZENITH Licensed Land Surveyors 于高測量公司 34-2, Jalan Anggerik Vanilla R 31/R, Kota Kemuning, Seksyen 31, 40460 Shah Alam, Selangor, Malaysia. Tel: 012-3961820 / 03-51224388 Fax: 03-51224388 H/P: 012-2805400 Email: jzenith88@gmail.com	
Sr HENG WEI KAIY B. Eng. (Hons.) Geomatics, MRISM, MAALS Land Surveyor Licensed Under Act 458 (Revised 1991)			
SURVEYED BY :	C.Y. FOO	29-8-2016	
DRAWN BY :	C. M. LEE NUR HAZLINA	15-09-2016 15-09-2016	PLAN NO : JZ/12/WP/91/DEM/2
CHECKED BY :	ABDUL MUJIZ W. K. HENG	19-09-2016 20-09-2016	