

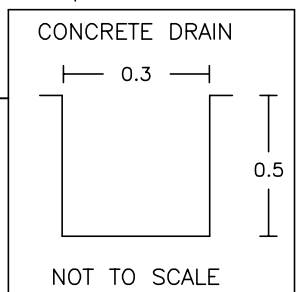
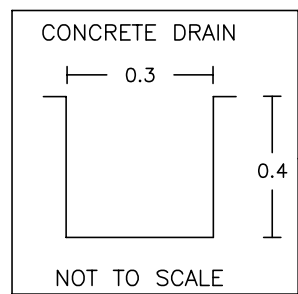
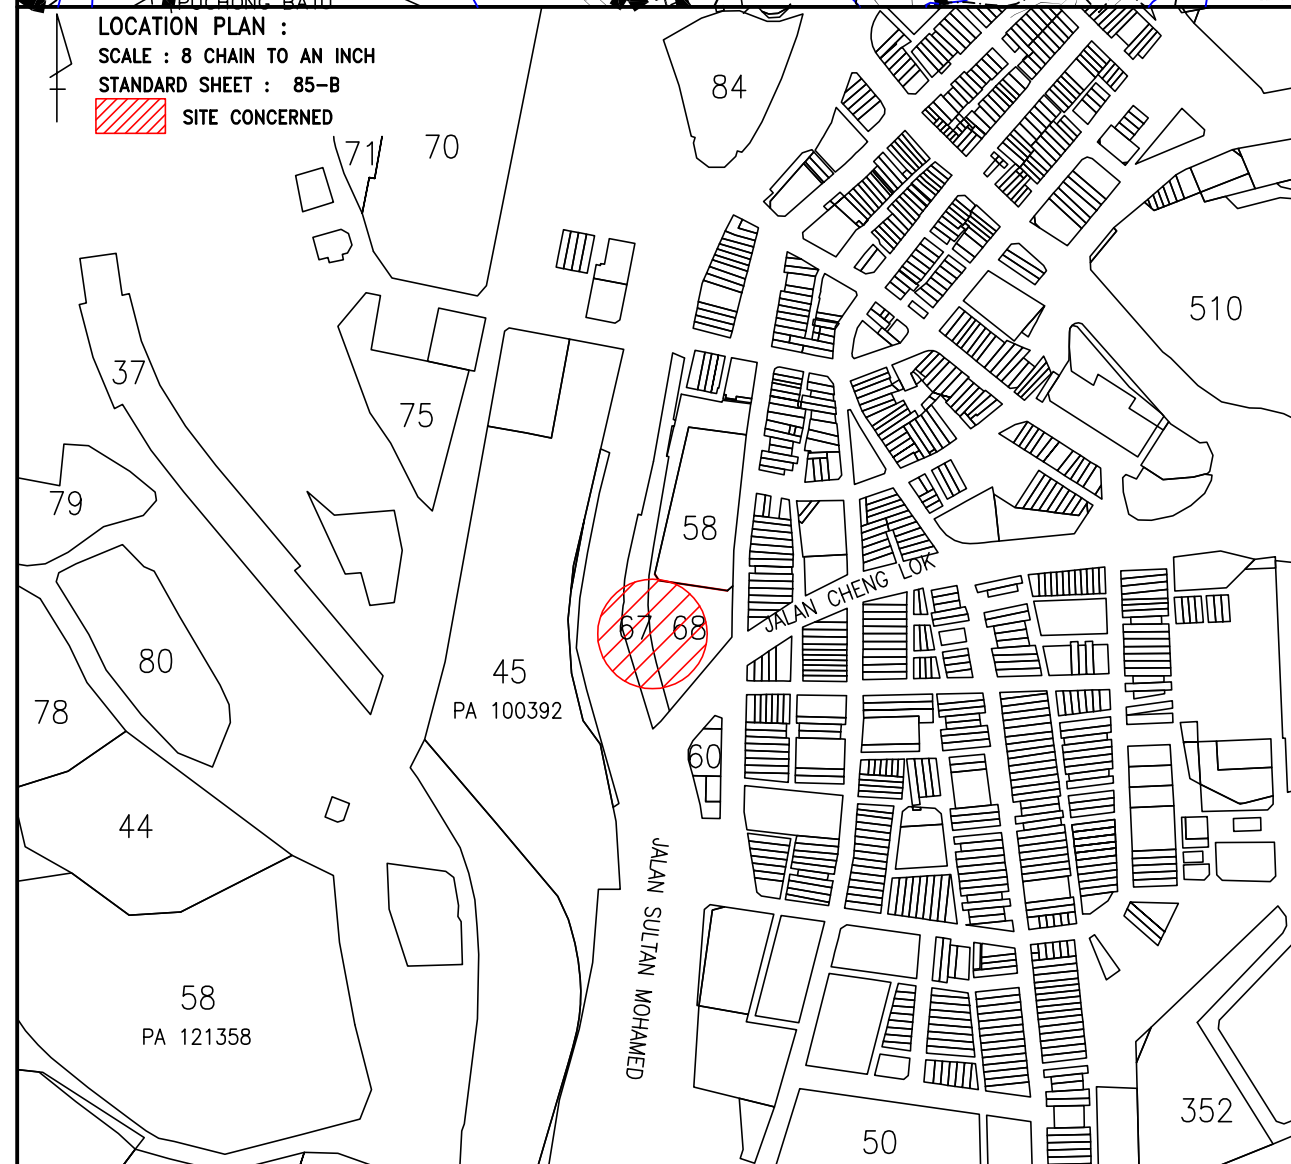
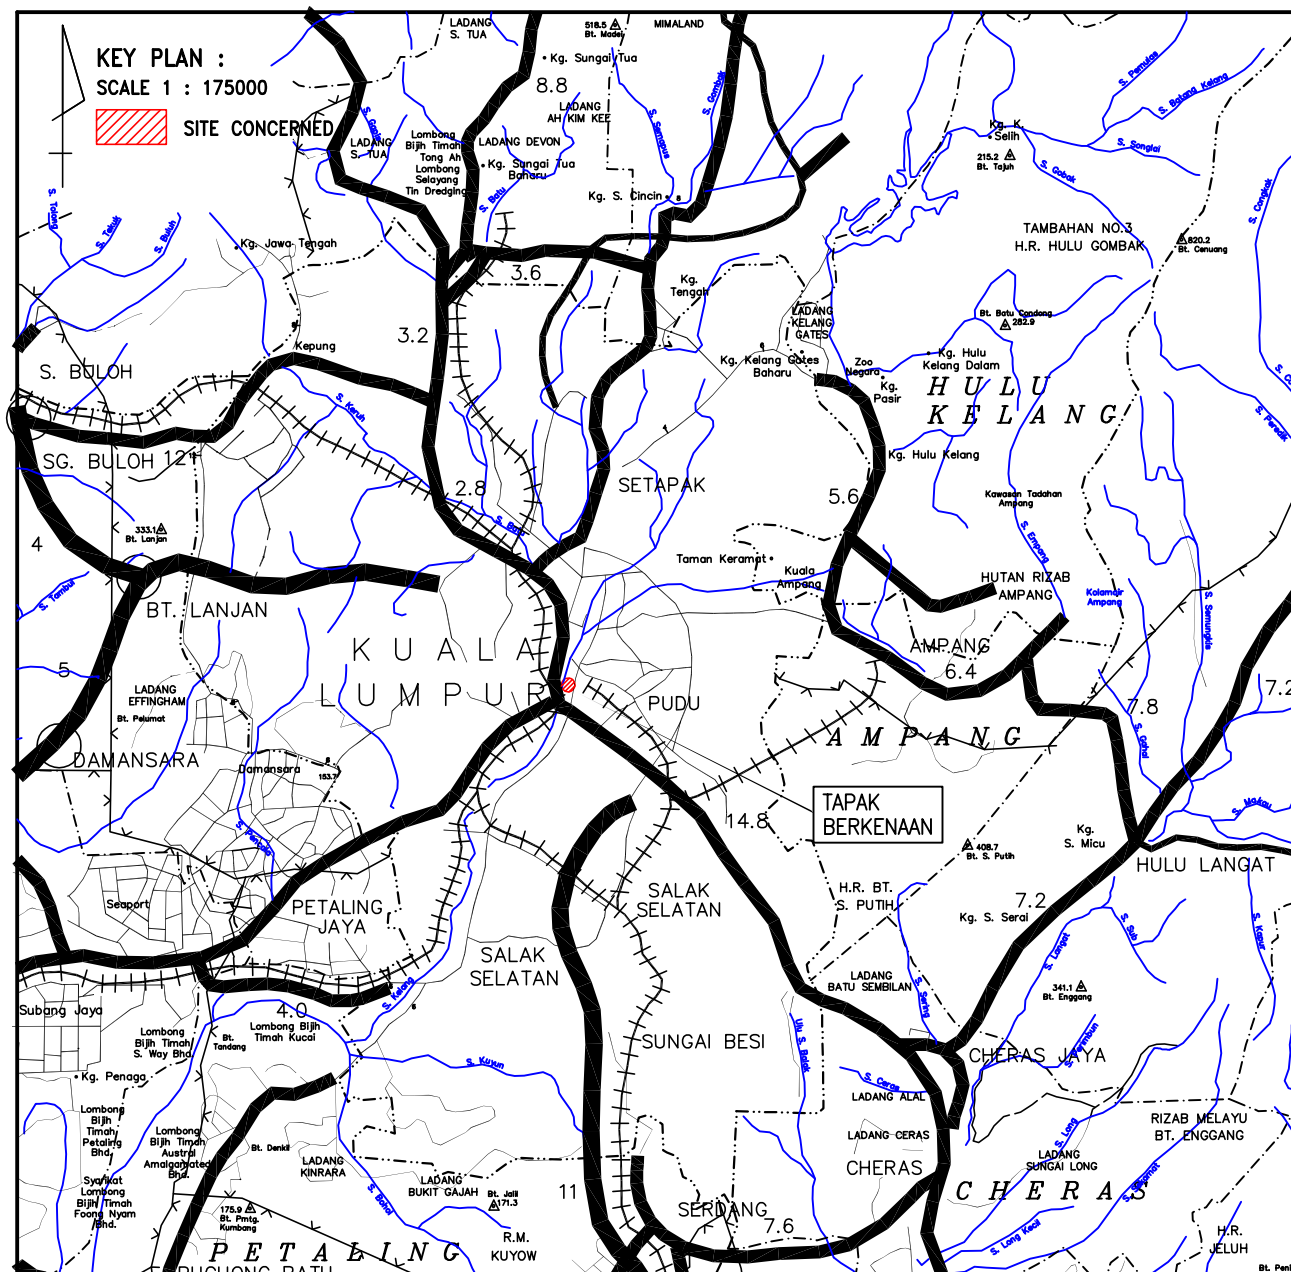


SCALE 1 : 300
STD SHEET : 85-B

S 3120
0.5m

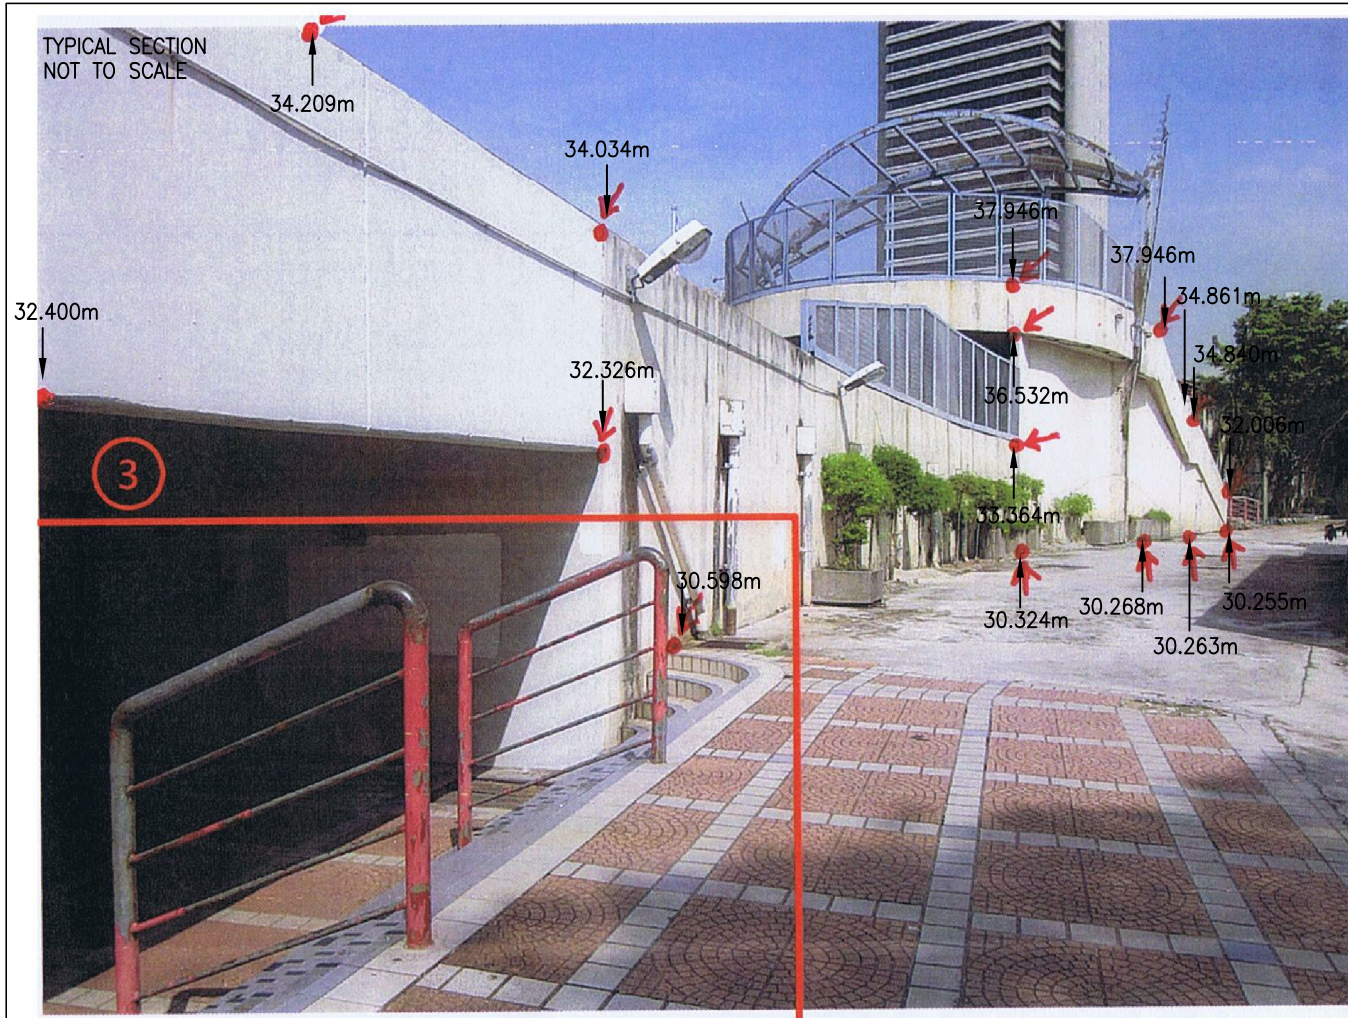

58
CENTRAL MARKET
PA 102770

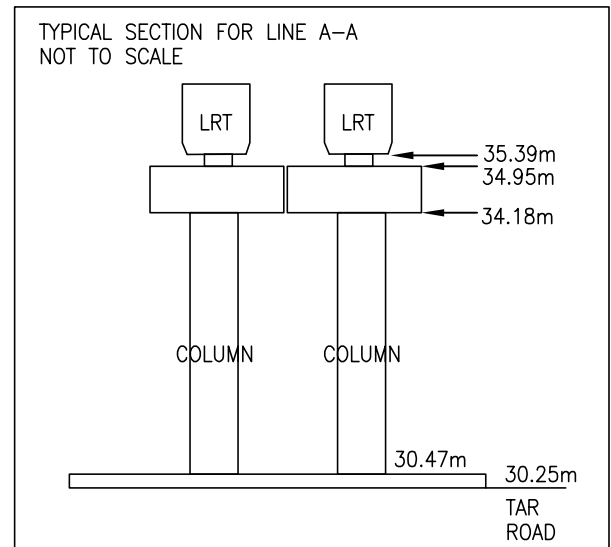

LEGENDS :

- | | |
|----------------------|------------------|
| 1. LP | LAMP POLE |
| 2. PUH | HYDRANT |
| 3. EB | ELECTRIC BOX |
| 4. SUMP | SUMP |
| 5. MH | MANHOLE |
| 6. BV | BOMBA VALVE |
| 7. TREE | TREE |
| 8. CONCRETE DRAIN | CONCRETE DRAIN |
| 9. METALLED ROAD | METALLED ROAD |
| 10. CHAIN LINK FENCE | CHAIN LINK FENCE |
| 11. IRON RAILING | IRON RAILING |
| 12. RETAINING WALL | RETAINING WALL |
| 13. STAIRCASE | STAIRCASE |
| 14. PUI | WATER PIPE |
| 15. SB | SIGNBOARD |
| 16. IL | INVERT LEVEL |
| 17. MH INK | MANHOLE (INK) |
| 18. MH TNB | MANHOLE (TNB) |
| 19. MH DBKL | MANHOLE (DBKL) |
| 20. MHST | SEPTIC TANK |
| 21. MH TIME | MANHOLE (TIME) |
| 22. SL | SOFFIT LEVEL |

NOTES :-

- ALL MEASUREMENTS ARE SHOWN IN METER.
- ALL LEVELS ARE BASED ON TBM KM R2 (RL: 31.467m) OF PLAN, REF. NO.: JK/04/WP/545/G2 OF JURUKUR KEMUNCAK AS PROVIDED BY CLIENT.
- DETAILS SURVEY IS DONE BASED ON CP : 112421
- FIELD BOOK NO. - 15
- TACHY BOOK NO. - 3
- LEVEL BOOK NO. - 3

DETAIL AND SPOT LEVEL SURVEY
ON PART OF LOTS 67 & 68
SEKSYEN 31, BANDAR KUALA LUMPUR
WILAYAH PERSEKUTUAN

LICENSED LAND SURVEYOR :

Sr HENG WEI KAY
B. Eng. (Hons.) Geomatics, MRISM, MAALS
Land Surveyor Licensed Under Act 458 (Revised 1991)

SURVEYED BY : C.Y FOO 12-12-2012

DRAWN BY : Y. C. HO 17-12-2012

CHECKED BY : P. S. LEE 18-12-2012

PREPARED BY :



JURUKUR ZENITH
Licensed Land Surveyors
于高測量公司
No. 61, Jalan Sungai Rengam 32/12,
Sekyen 32, 40460 Shah Alam,
Selangor, Malaysia.
Tel: 03-57408300 Fax: 03-57408301
H/P: 012-2805400
Email: jzenith88@gmail.com

PLAN NO : JZ/12/WP/91/D/1