

APPENDIX G1: (BASEMENT 1)

NOTES:

- 1) TO pick up the Internal wall (points W1, W2, W3, W5 & W6)
- 2) TO pick up the External wall (points W3, W4, W5, W7, W8, W9, W10, W11, W12, W13, W14, W15, W16, W17, W18 & W19)
- 3) TO pick up the portion of Columns C1, C2, C3, C4 & C5.
- 4) TO provide the Reduced Levels of Ground Level & Soffit level of the Beams at points $G1+B1$, $G1'+B1'$, $G2+B2$, $G2'+B2'$, $G3+B3$, $G3'+B3'$, $G4+B4$ & $G4'+B4'$.

7995

7924

5486

7924


4115

4877

3962

5334

7772

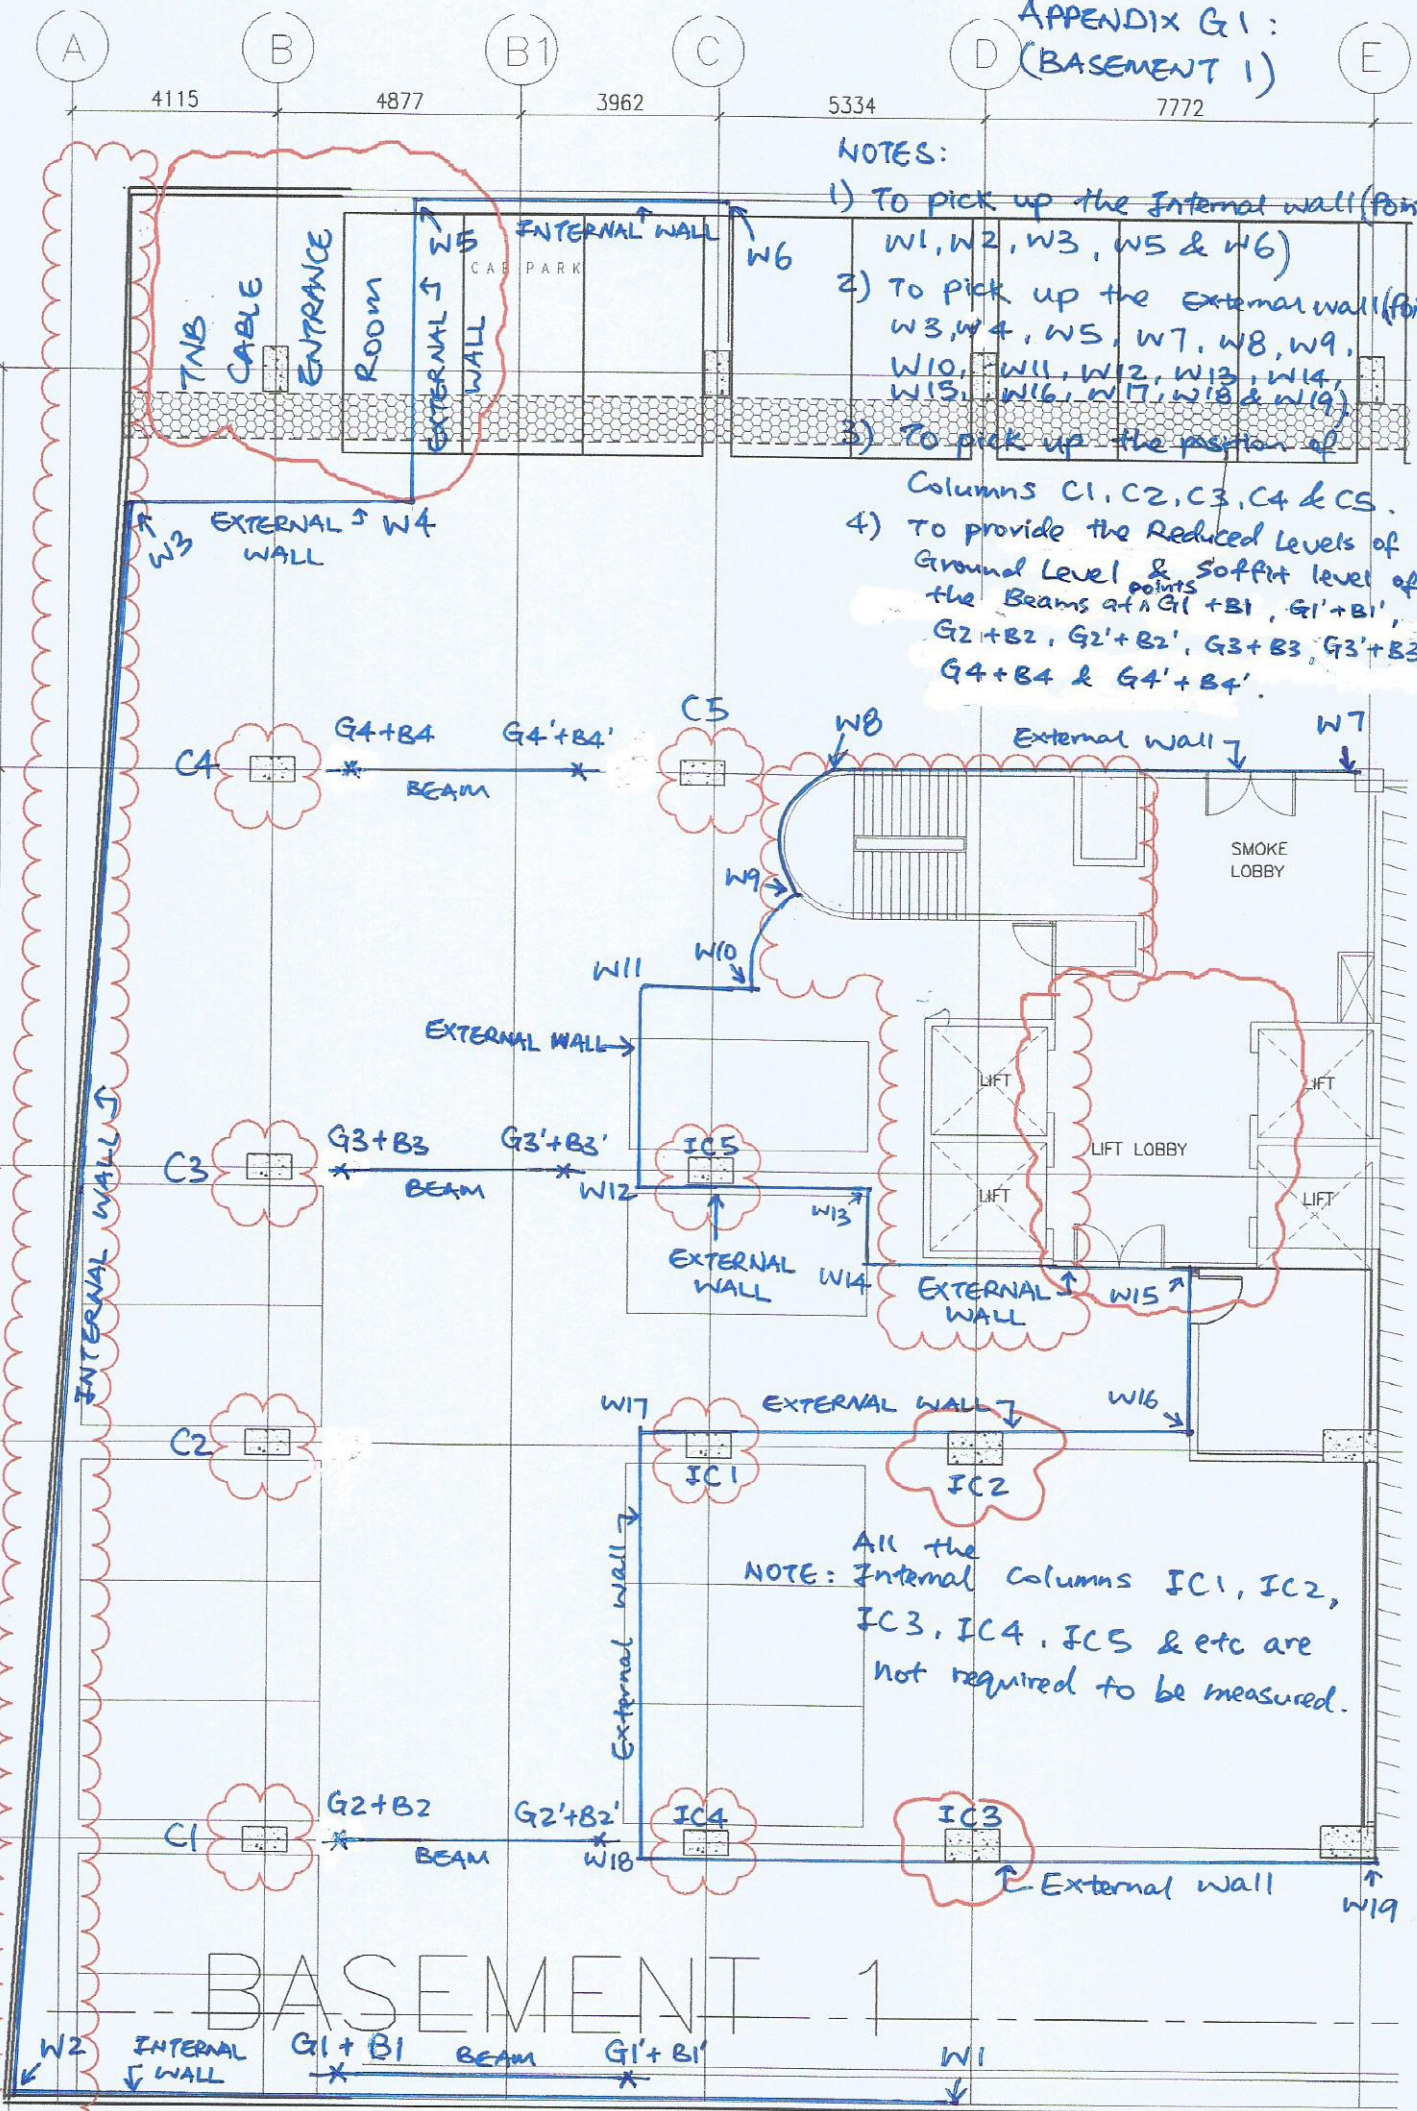

BASEMENT 1