

AND TUNE HOE
WORLD WALKS
JAMES BROWN
SO, B-SIDE (1974)
DOUGH AND KID (1974)

UNCLASSIFIED//FOR OFFICIAL USE ONLY

DATA NO. : 20143100 & 20144100

N30 1 A6 (340340)

CHANNON, J. R. / 1963


NOVA 11 2 10 0313AMCT

SCALE : 1 : 250



APPENDIX A2

DEMARCATION, DETAIL & SPOT LEVEL SURVEY FOR LOT 26911, 26912 & 26913
MUKIM OF SETAPAK, DISTRICT OF KUALA LUMPUR
WILAYAH PERSEKUTUAN KUALA LUMPUR

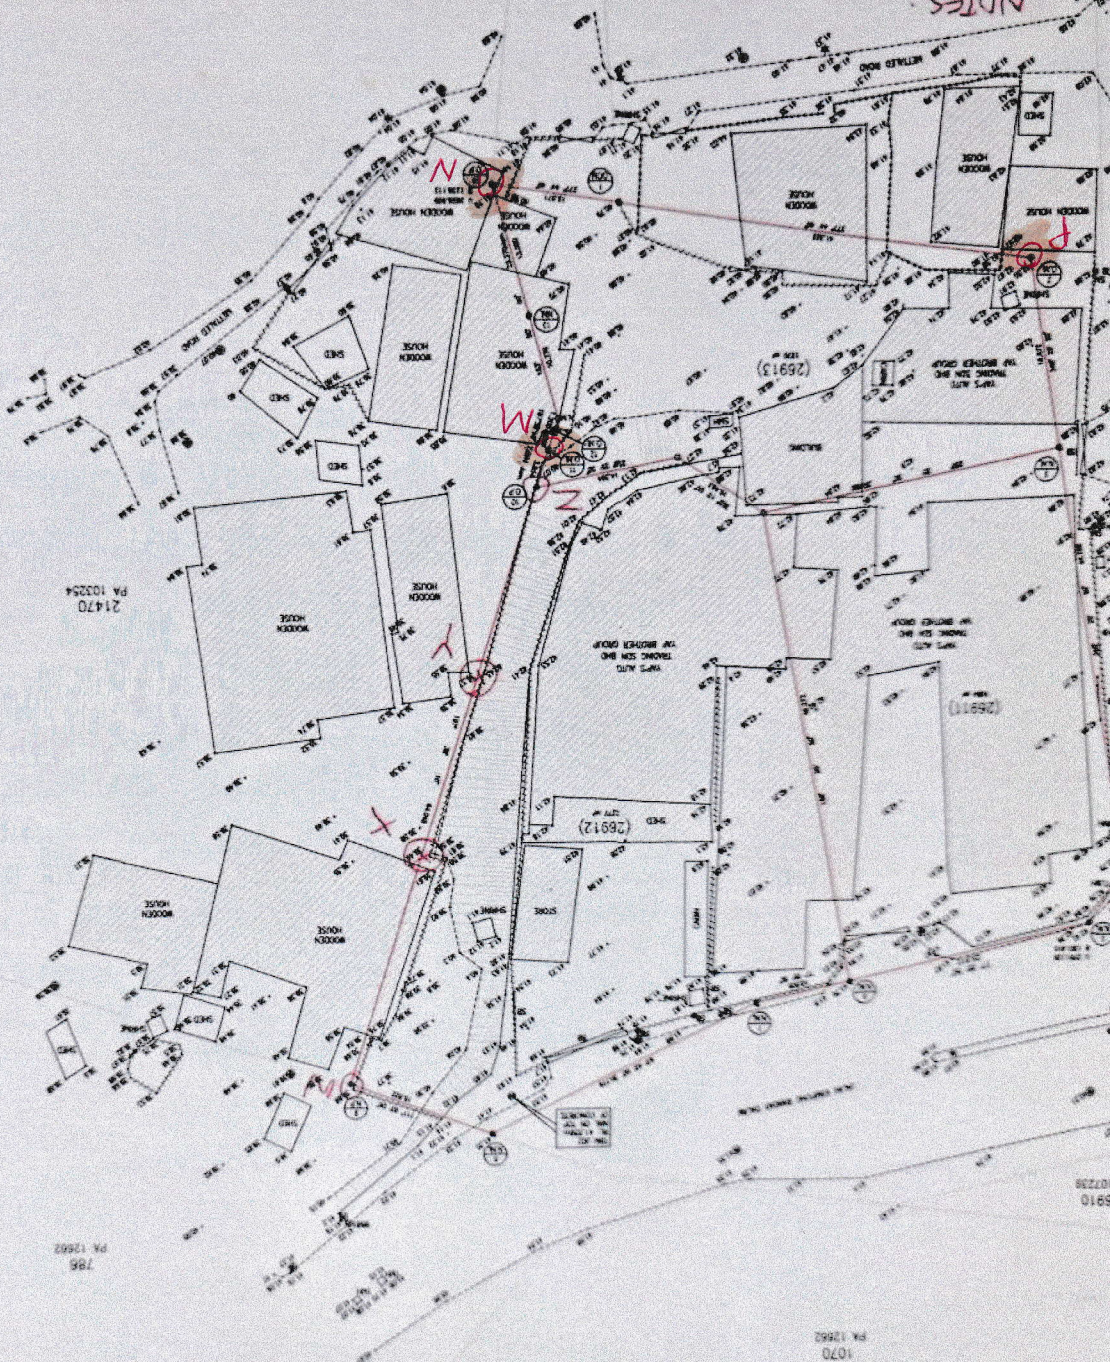

NOTES

5555
A 24879

N & P

1) To demarcate points W & Z on part of lots 26