


No. 64/1 DBKL 10/10	TAJUK PROJEK CADANGAN TAMBAHAN DAN PERUBAHAN KEPADA RUMAH TERES 3 TINGKAT YANG SEDA ADA DI ATAS LOT 110836, (NO.28)JALAN MEDANG SERAI, TAMAN BANDARAYA,BANGSAR, 59100 KUALA LUMPUR UNTUK :- ZHOU XING CHEN & LIONG MUN MENG	BENCANA	LOCATION & SITE PLAN, GROUND & LG1 LG2 LG3 & LG3F FLOOR PLAN, SECTION-A, ELEVATIONS & DIAGRAMMATIC VIEW OF SANITARY LAYOUT	JENIS	TANDATANGAN PERSEK	NO 28, JALAN MEDANG SERAI, TAMAN BANDARAYA, BANGSAR, 59100, KUALA LUMPUR	TANDATANGAN AKTEK	ANCH & P. S. S. No. Persekitaran L.A. N-A/N 16	AKTEK HABITAT	Alpha Infinity Management (09455245-P) Interior Design Architecture Design & Build Contact : +6017 3717889 - Tom Yap Email : H1AlphaInfinity@gmail.com	Tajuk lukisan
Skala 1:100 / 1:200	1:100 / 1:200	1:100 / 1:200	1:100 / 1:200	1:100 / 1:200	1:100 / 1:200	1:100 / 1:200	1:100 / 1:200	1:100 / 1:200	1:100 / 1:200	1:100 / 1:200	1:100 / 1:200
No. 64/1 DBKL 10/10	TAJUK PROJEK CADANGAN TAMBAHAN DAN PERUBAHAN KEPADA RUMAH TERES 3 TINGKAT YANG SEDA ADA DI ATAS LOT 110836, (NO.28)JALAN MEDANG SERAI, TAMAN BANDARAYA,BANGSAR, 59100 KUALA LUMPUR UNTUK :- ZHOU XING CHEN & LIONG MUN MENG	BENCANA	LOCATION & SITE PLAN, GROUND & LG1 LG2 LG3 & LG3F FLOOR PLAN, SECTION-A, ELEVATIONS & DIAGRAMMATIC VIEW OF SANITARY LAYOUT	JENIS	TANDATANGAN PERSEK	NO 28, JALAN MEDANG SERAI, TAMAN BANDARAYA, BANGSAR, 59100, KUALA LUMPUR	TANDATANGAN AKTEK	ANCH & P. S. S. No. Persekitaran L.A. N-A/N 16	AKTEK HABITAT	Alpha Infinity Management (09455245-P) Interior Design Architecture Design & Build Contact : +6017 3717889 - Tom Yap Email : H1AlphaInfinity@gmail.com	Tajuk lukisan

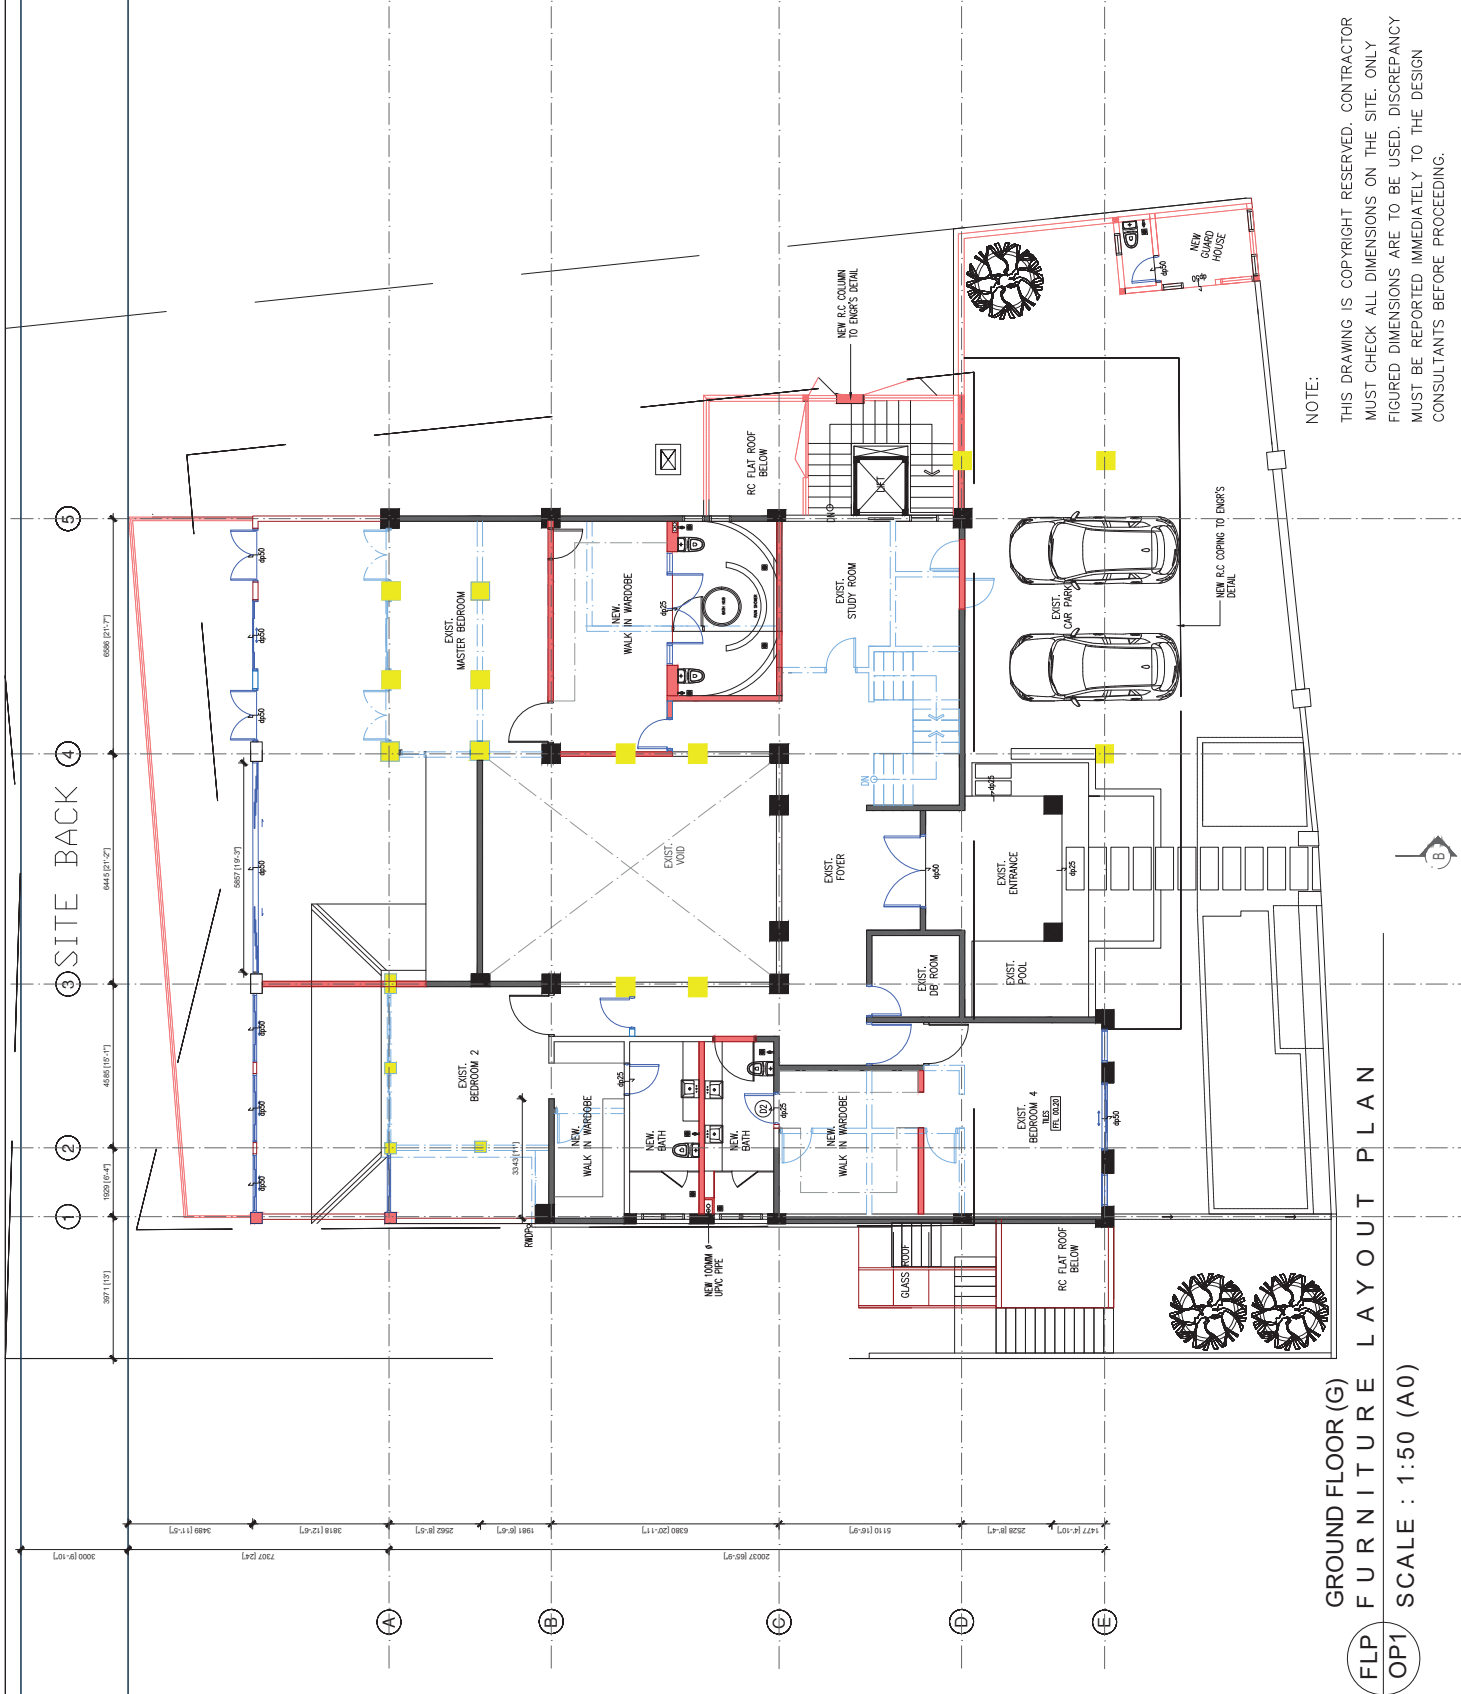

CADANGAN TAMBAHAN DAN PERUBAHAN
KEPADA RUMAH TERES 3 TINGKAT YANG
SEDA ADA DI ATAS LOT 110836,
(NO.28)JALAN MEDANG SERAI,
TAMAN BANDARAYA,BANGSAR,
59100 KUALA LUMPUR
UNTUK :-
ZHOU XING CHEN & LIONG MUN MENG

RENCANA

LOCATION & SITE PLAN, GROUND &
LG1 LG2 LG3 & LG3F FLOOR PLAN,
SECTION-A, ELEVATIONS &
DIAGRAMMATIC VIEW OF SANITARY LAYOUT

JENS

40T 291

TANDATANGANI PEMILK

NO 28,
JALAN MEDANG SERAI,
TAMAN BANDARAYA, BANGSAR,
59100. KUALA LUMPUR

TANDATONG-ANT AKITEK


ARCH o. p. o. n
No. Perdoftoran L A N-A/N 16

AKITEK HABITAS



Alpha Infinity Management (0304525245-P)
 Interior Design | Architecture | Design & Build
 Contact : +6017 3717889 - Tom yap
 Email : HiAlphaInfinity@gmail.com


taluk lukisan	
---------------	--

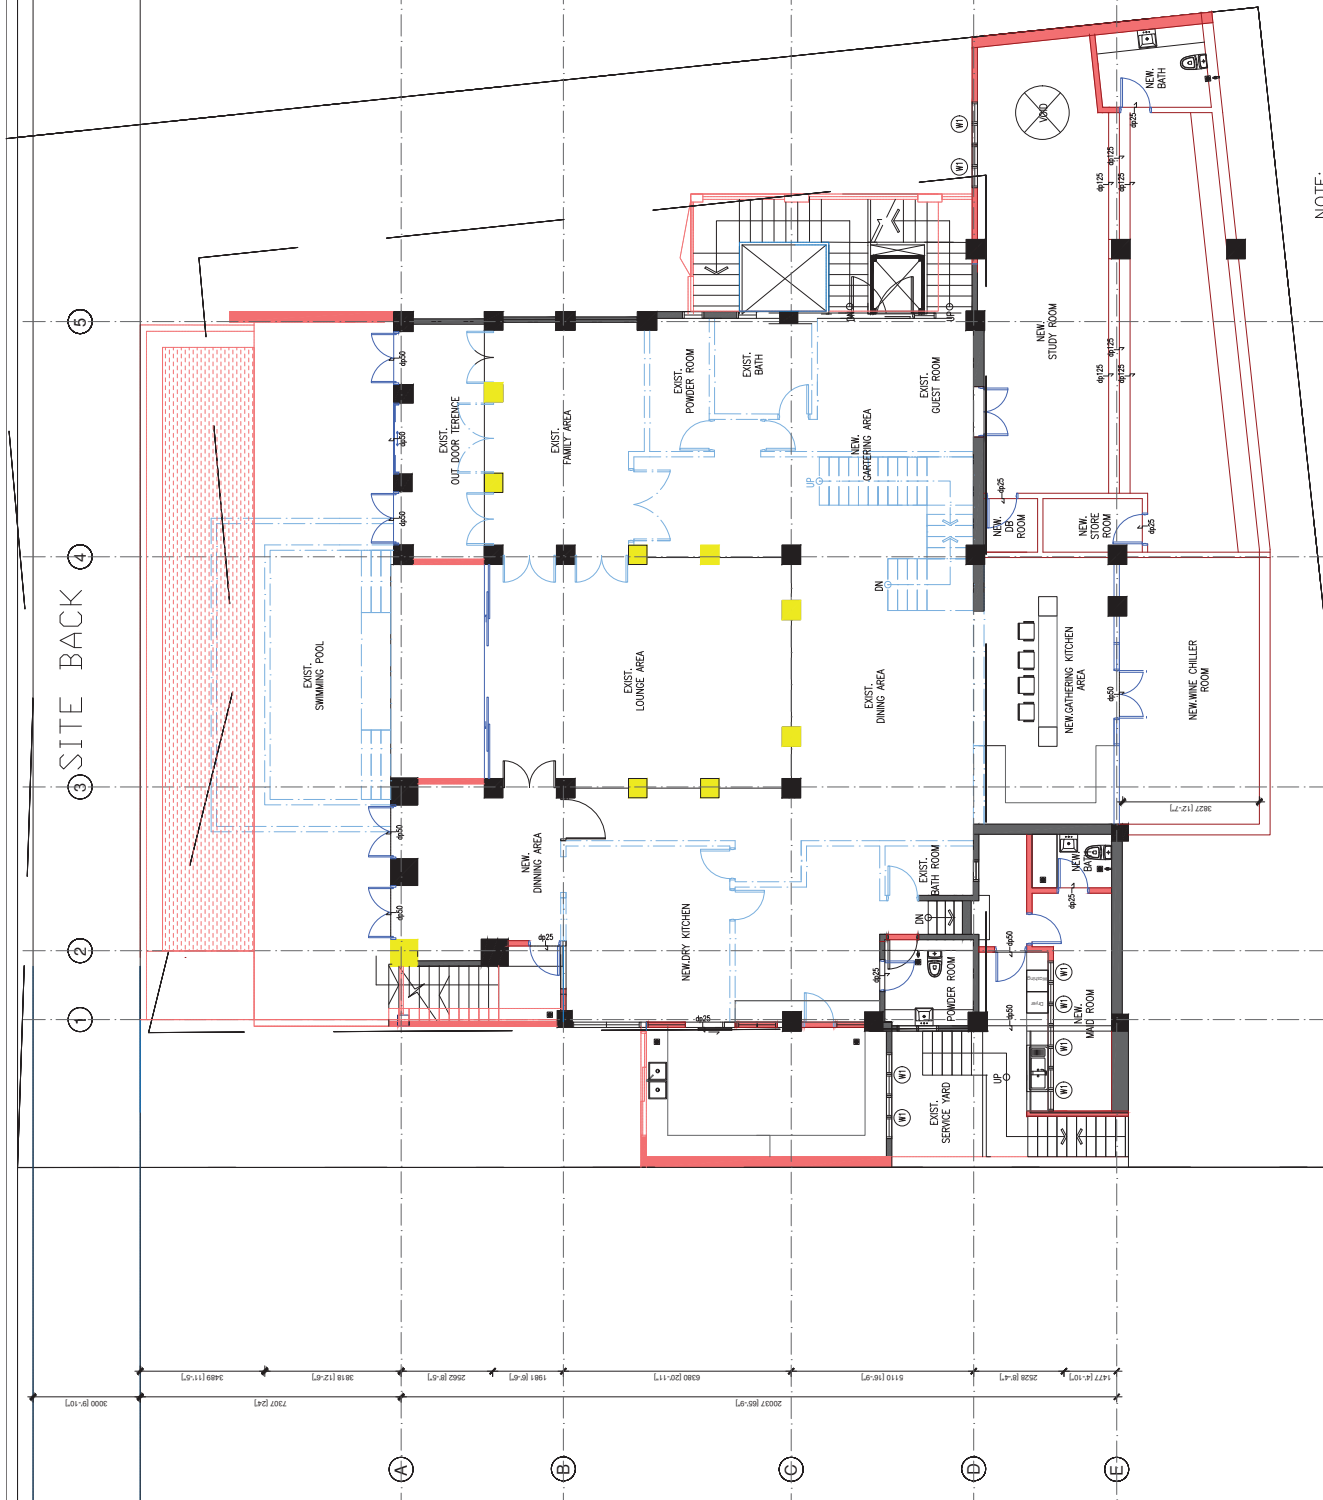[illegible]

NOTE:

THIS DRAWING IS COPYRIGHT RESERVED. CONTRACTOR
MUST CHECK ALL DIMENSIONS ON THE SITE. ONLY
FIGURED DIMENSIONS ARE TO BE USED. DISCREPANCY
MUST BE REPORTED IMMEDIATELY TO THE DESIGN
CONSULTANTS BEFORE PROCEEDING.

LOWER GROUND (LG) FLOOR
FLP FURNITURE LAYOUT PLAN
OP1 SCALE : 1:50 (A0)

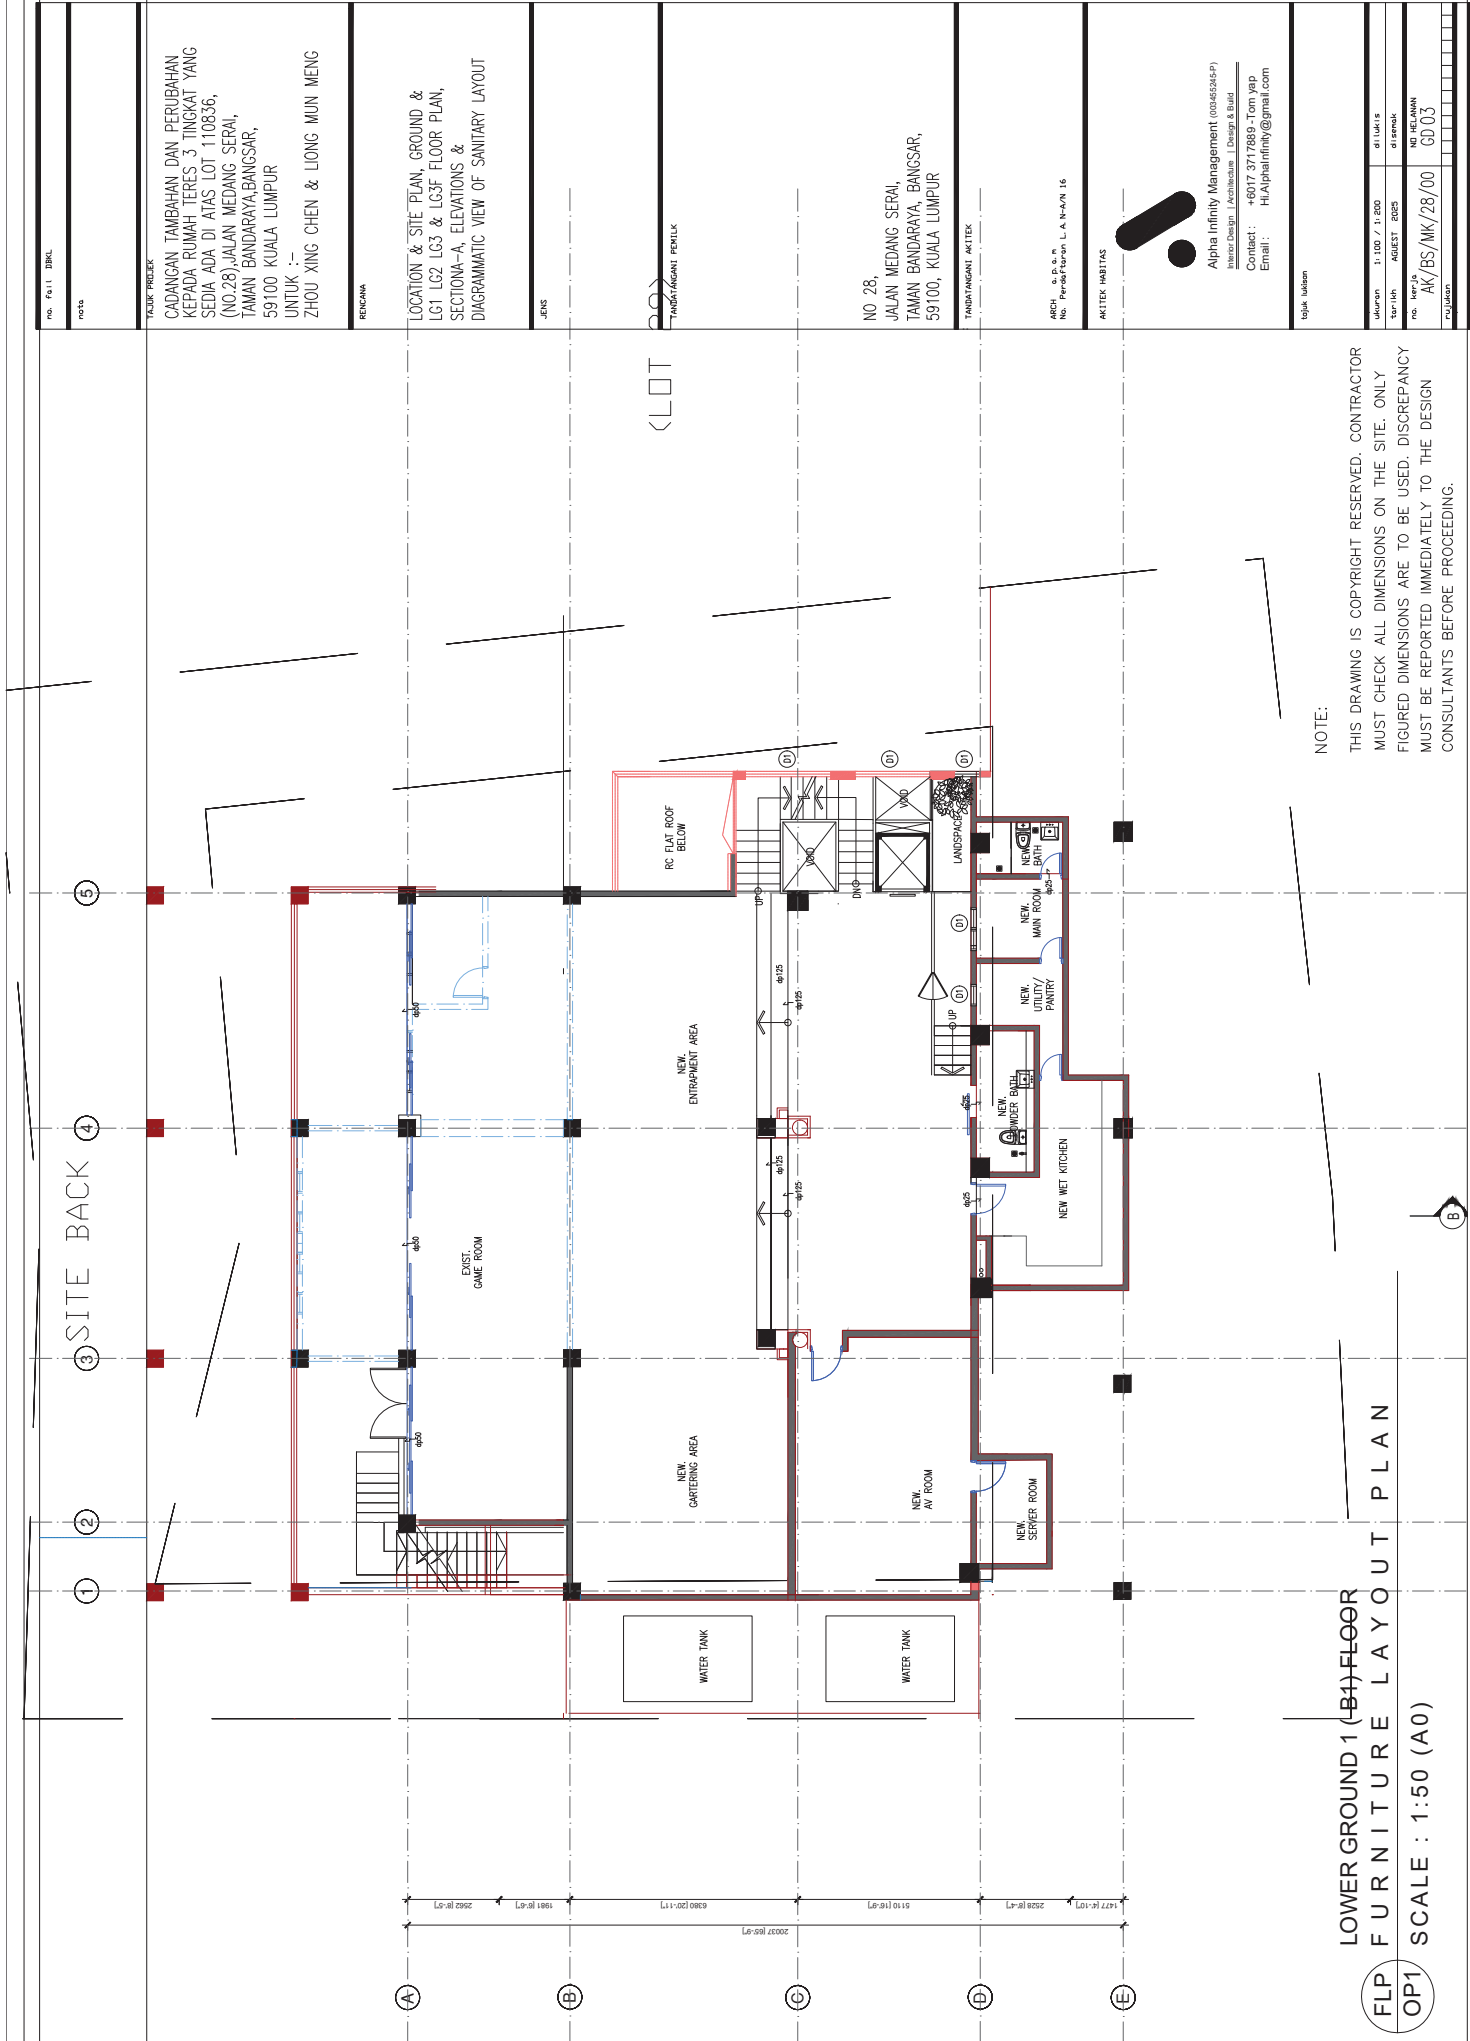

LOWER GROUND 1 (B4) FLOOR
FURNITURE LAYOUT PLAN
SCALE : 1:50 (A0)

FLP
OP1

NOTE:

THIS DRAWING IS COPYRIGHT RESERVED. CONTRACTOR
MUST CHECK ALL DIMENSIONS ON THE SITE. ONLY
FIGURED DIMENSIONS ARE TO BE USED. DISCREPANCY
MUST BE REPORTED IMMEDIATELY TO THE DESIGN
CONSULTANTS BEFORE PROCEEDING.

NO. 64.11.1384L

NOTA

TAJUK PROJEK

CADANGAN TAMBAHAN DAN PERUBAHAN
KEPADA RUMAH TERES 3 TINGKAT YANG
SEDA ADA DI ATAS LOT 110836,
(NO.28),JALAN MEDANG SERAI,
TAMAN BANDARAYA,BANGSAR,
59100 KUALA LUMPUR
UNTUK :-
ZHOU XING CHEN & LIONG MUN MENG

RENCANA

LOCATION & SITE PLAN, GROUND &
LG1 LG2 LG3 & LG3F FLOOR PLAN,
SECTION-A, ELEVATIONS &
DIAGRAMMATIC VIEW OF SANITARY LAYOUT

SKALA

(LOT

TANDATANGAN PESELUK

NO 28,
JALAN MEDANG SERAI,
TAMAN BANDARAYA, BANGSAR,
59100, KUALA LUMPUR

TANDATANGAN AKITEK

ARCH & P.E.M.
No. Pendaftaran L.A. N/A/N 16


AKITEK HABITAS



Alpha Infinity Management (00455245-P)
Interior Design | Architecture | Design & Build
Contact : +6017 377889 -Tom Yap
Email : HAlphaInfinity@gmail.com

Isiuk Isikuan

ukuran	1:100 / 1:200	di lukis	
tarikh	AGUST 2025	di reka	
no. kerja	AK/BS/NK/28/00	no. rekaman	6003
jumlah			

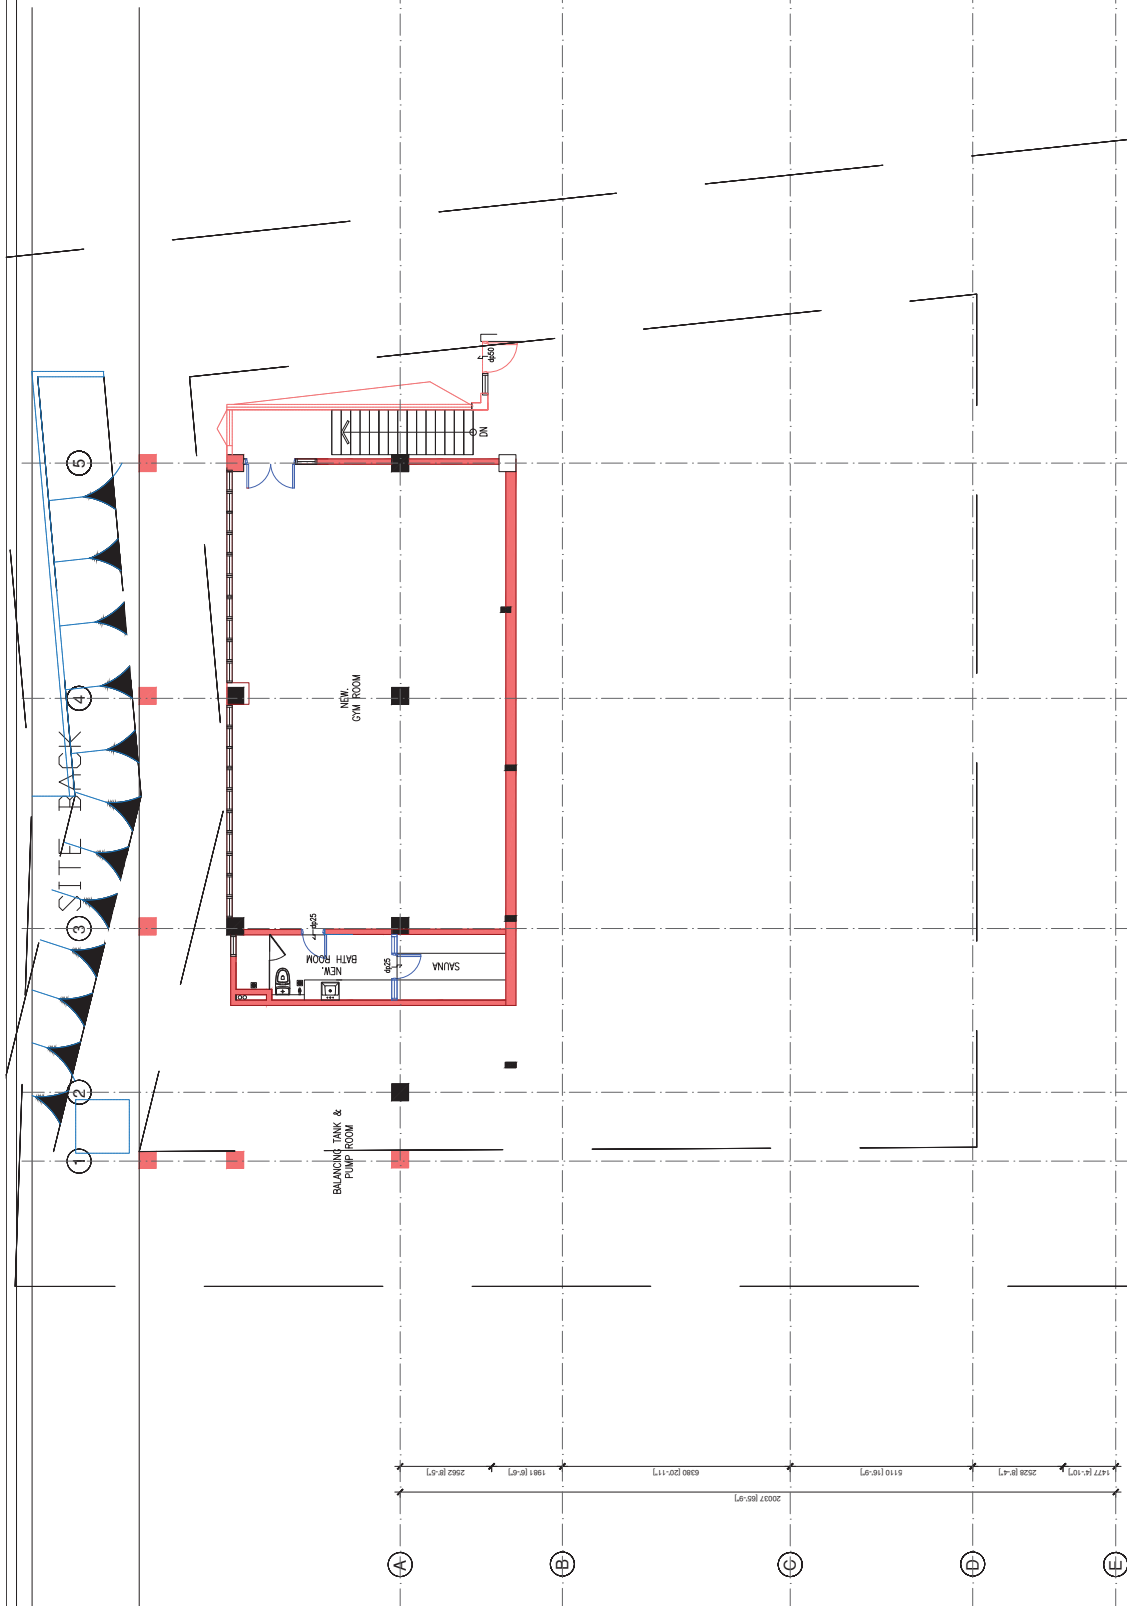

LOWER GROUND 3 (B3) FLOOR
FURNITURE LAYOUT PLAN
FLP
OP1
SCALE : 1:50 (A0)

NOTE:
THIS DRAWING IS COPYRIGHT RESERVED. CONTRACTOR
MUST CHECK ALL DIMENSIONS ON THE SITE. ONLY
FIGURED DIMENSIONS ARE TO BE USED. DISCREPANCY
MUST BE REPORTED IMMEDIATELY TO THE DESIGN
CONSULTANTS BEFORE PROCEEDING.

NO. 021	1984
POTRE	
TALUK PROJEK CADANGAN KEPADA RUI SEDIA ADA (NO.28) JALAN TAMAN BAND 59100 KUALA UNTUK :- ZHOU XING	
RENCANA	
LOCATION & LG1 LG2 LG: LG SECTION-A-A, DIAGRAMMATIC	
JENIS	
TAMBAT TANGKAI PER	
NO 28, JALAN MEDAN TAMAN BAND 59100, KUALA	
TAMBAT TANGKAI PER	
ARCH No.	d. p. e. m. Persekitaran
AKITEK HABITAS	