



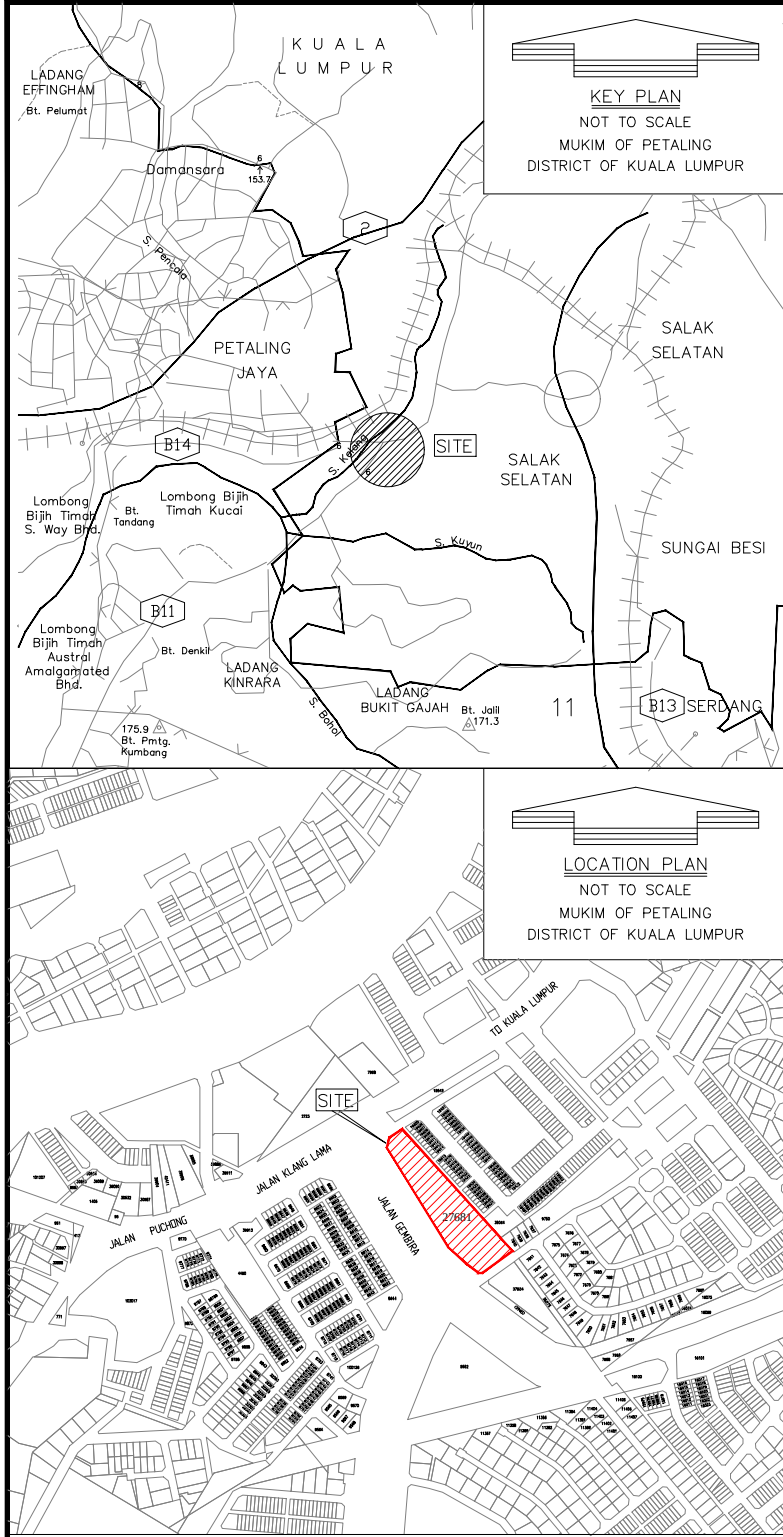

TBM SG/WP/559/2 RL:23.207m
ON OLD NAIL

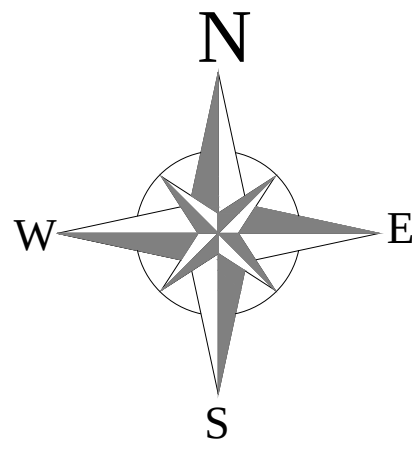

- NOTES & LEGENDS :
1. All the boundary line are based on PA1111554.
 2. All the as-built level are in meters.
 3. All as-built Levels are based on BM W 0114 (RL21.820m), which Located at Petaling Police Station Compound, Along Jalan Genting Klang Lama.

- Boundary line
- TBM TBM location
- 24.74 Original ground level (30 Aug 2023)
- 8.52 Platform level (9 Feb 2026)

DRAWING TITLE :

PERMOHONAN CADANGAN PEMBANGUNAN BERCAMPUR YANG MENGANDUNGI PUSAT MEMBELI-BELAH SERTA PANGSAPURI SERVIS:

A) FASA 1 : PUSAT MEMBELI BELAH 16 TINGKAT YANG MENGANDUNGI:

i) 3 TINGKAT TEMPAT LETAK KERETA DARI ARAS BESMEN 5 HINGGA ARAS BESMEN 3

ii) 2 TINGKAT RUANG PERNIAGAAN DI ARAS BESMEN 2 HINGGA BESMEN 1

iii) 1 TINGKAT RUANG PERNIAGAAN DI ARAS TANAH

iv) 1 TINGKAT TEMPAT LETAK KERETA DAN MOTOSIKAL DI ARAS MEZZANIN

v) 6 TINGKAT TEMPAT LETAK KERETA DAN RUANG PERNIAGAAN DARI ARAS ATAS TANAH HINGGA ARAS 2M

vi) 1 TINGKAT TEMPAT LETAK KERETA, RUANG PERNIAGAAN DAN PANGGUNG WAYANG DI ARAS 3 vii) 3 TINGKAT DEWAN SERBAGUNA, RUANG PERNIAGAAN DAN PANGGUNG WAYANG DARI ARAS 3M HINGGA ARAS 4M

viii) 1 TINGKAT RUANG KEMUDAHAN DAN RUANG PERNIAGAAN DI ARAS 5

ix) 1 TINGKAT RUANG PERNIAGAAN DI ARAS 6

x) 1 TINGKAT RUANG PEJABAT DI ARAS 7

xi) 1 TINGKAT BILIK MEKANIKAL DI ARAS 8

B) FASA 2 : 7 TINGKAT TEMPAT LETAK KERETA DAN MOTOSIKAL DARI ARAS BESMEN 7 HINGGA ARAS BESMEN 1

DI ATAS LOT 27681, JALAN MEGA KECIL, TAMAN OVERSEAS UNION, MUKIM PETALING, DAERAH KUALA LUMPUR, WILAYAH PERSEKUTUAN KUALA LUMPUR.
UNTUK: TETUAN OVERSEAS UNION GARDEN SDN BHD.

SUBSTRUCTURE WORKS (MALL & SERVICE APARTMENTS)

LICENSED LAND SURVEYOR :

JURUUKUR AZNAN
No. 13M, Jalan Kosas 1/2, Taman Kosas
68000 Ampang, Selangor
Tel: 03-4291 0512 Faks: 03-4291 0513

AHMAD AZNAN BIN ZAKARIA
Juruukur Tanah Berlesen berdaftar di bawah
Akta Juruukur Tanah Berlesen 1958 (Akta 458)
No. Pendaftaran: LJT 317

	NAME :	DATE :
SURVEYED BY :	BEN LOK WEN JIE	9 FEB 2026
DRAWN BY :	AHMAD MUJAHID	12 FEB 2026
CHECKED BY :	JACKIE GOH	20 FEB 2026
SCALE :	1:450 (A1 SIZE)	

A1212/LOT27681/A1 ASB/EARTH.VOLUME

DRAWING TITLE :

**AS-BUILT CALCULATION
EARTHWORK QUANTITY**

AS-BUILT DRAWING

Cut = 100.0 % Fill = 0.0 % with 12654.3m2 Cut

Zone	Volume			Area		
Name	Total Cut	Total Fill	Total Volume	Cut Area	Fill Area	Total Area
Boundary1	184,224.1	0.0	184,224.1	12,654.3	0.0	12,654.3