

# JGC 711 USJ Heights.

16/6/2010

Detum Sanipada 2750328 2750328 1 4 76.066 76.066  
 PA Az At.  
 Jm MH

1 2750328 950328 937557 2 937557 3 4 279.779 279.779  
 2  
 3 937557 2737557  
 pt.B

|      |                        |   |         |    |   |         |      |         |
|------|------------------------|---|---------|----|---|---------|------|---------|
| 2-4  | 8 9130                 | 2 | 8 9130  | 9  | 4 | 198.601 | pt.L | 198.601 |
| 2-5  | 10 0606                | 2 | 10 0606 | 5  | 4 | 129.028 | BAL  | 129.028 |
| 2-6  | 925853                 | 2 | 925853  | 6  | 4 | 119.638 | BAL  | 119.638 |
| 2-7  | 11 0812                | 2 | 11 0812 | 7  | 4 | 110.867 | pt.L | 110.867 |
| 2-8  | 911370                 | 2 | 911370  | 8  | 4 | 91.509  | BAL  | 91.509  |
| 2-9  | 12 3707                | 2 | 12 3707 | 9  | 4 | 92.752  | BAL  | 92.752  |
| 2-10 | 19 9115                | 2 | 19 9115 | 10 | 4 | 79.729  | BAL  | 79.729  |
| 2-11 | 18 0920                | 2 | 18 0920 | 11 | 4 | 56.867  | BAL  | 56.867  |
| 2    | 950328 2750328 1931550 | 1 | 1931550 | 12 | 4 | 71.106  |      | 71.106  |

12 1931550 131550

ptx

1 131550 1931550 1982911 12 1982911 13 4 121.981 121.981

12

13 1982911 182911

ptx

12 182911 1982911 1263052 13 1263052 19 4 73.090 73.090

13

19 1263052 3063052

ptx



20 2351280 551280 238559 3 238559 2 Sila Liket m/s 7 R 2  
3  
2 238559 938559

Being  
Terikat.




Demarcation.


|        |          |        |      |
|--------|----------|--------|------|
| 3-B1   | 277 9713 | 17.638 | pk.B |
| 3-B2   | 279 2130 | 19.933 | pk.B |
| 1-B3   | 88 5321  | 10.999 | AB   |
| 1-B7   | 212 5907 | 29.958 | AB   |
| 12-B5  | 11 2300  | 11.800 | AB   |
| 12-B6  | 10 2055  | 10.299 | AB   |
| 12-B7  | 202 1928 | 21.390 | AB   |
| 13-B8  | 15 9910  | 29.578 | AB   |
| 13-B9  | 0 0232   | 9.298  | AB   |
| 13-B10 | 228 9037 | 2.659  | AB   |
| 13-B11 | 132 1918 | 10.009 | AB   |
| 13-B12 | 120 3756 | 52.674 | AB   |
| 15-B13 | 7 3538   | 9.660  | AB   |
| 15-B17 | 169 0036 | 15.599 | AB   |
| 15-B15 | 166 2125 | 21.078 | AB   |

5-6 195 2309 161.627 ✓  
195 2230 161.608 PO  
7091 70.019

8-11 30/7906 113.855 ✓  
30/7810 113.852 10  
750" -0.003

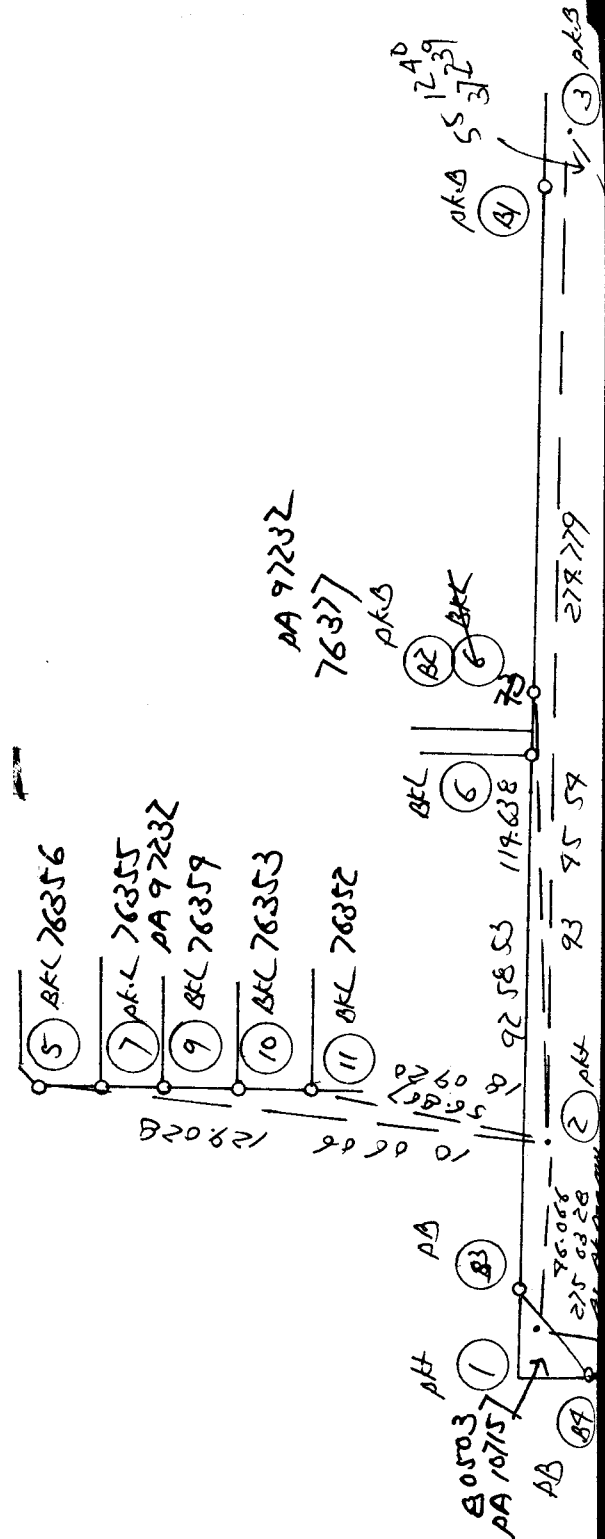

80507  
AA 107157

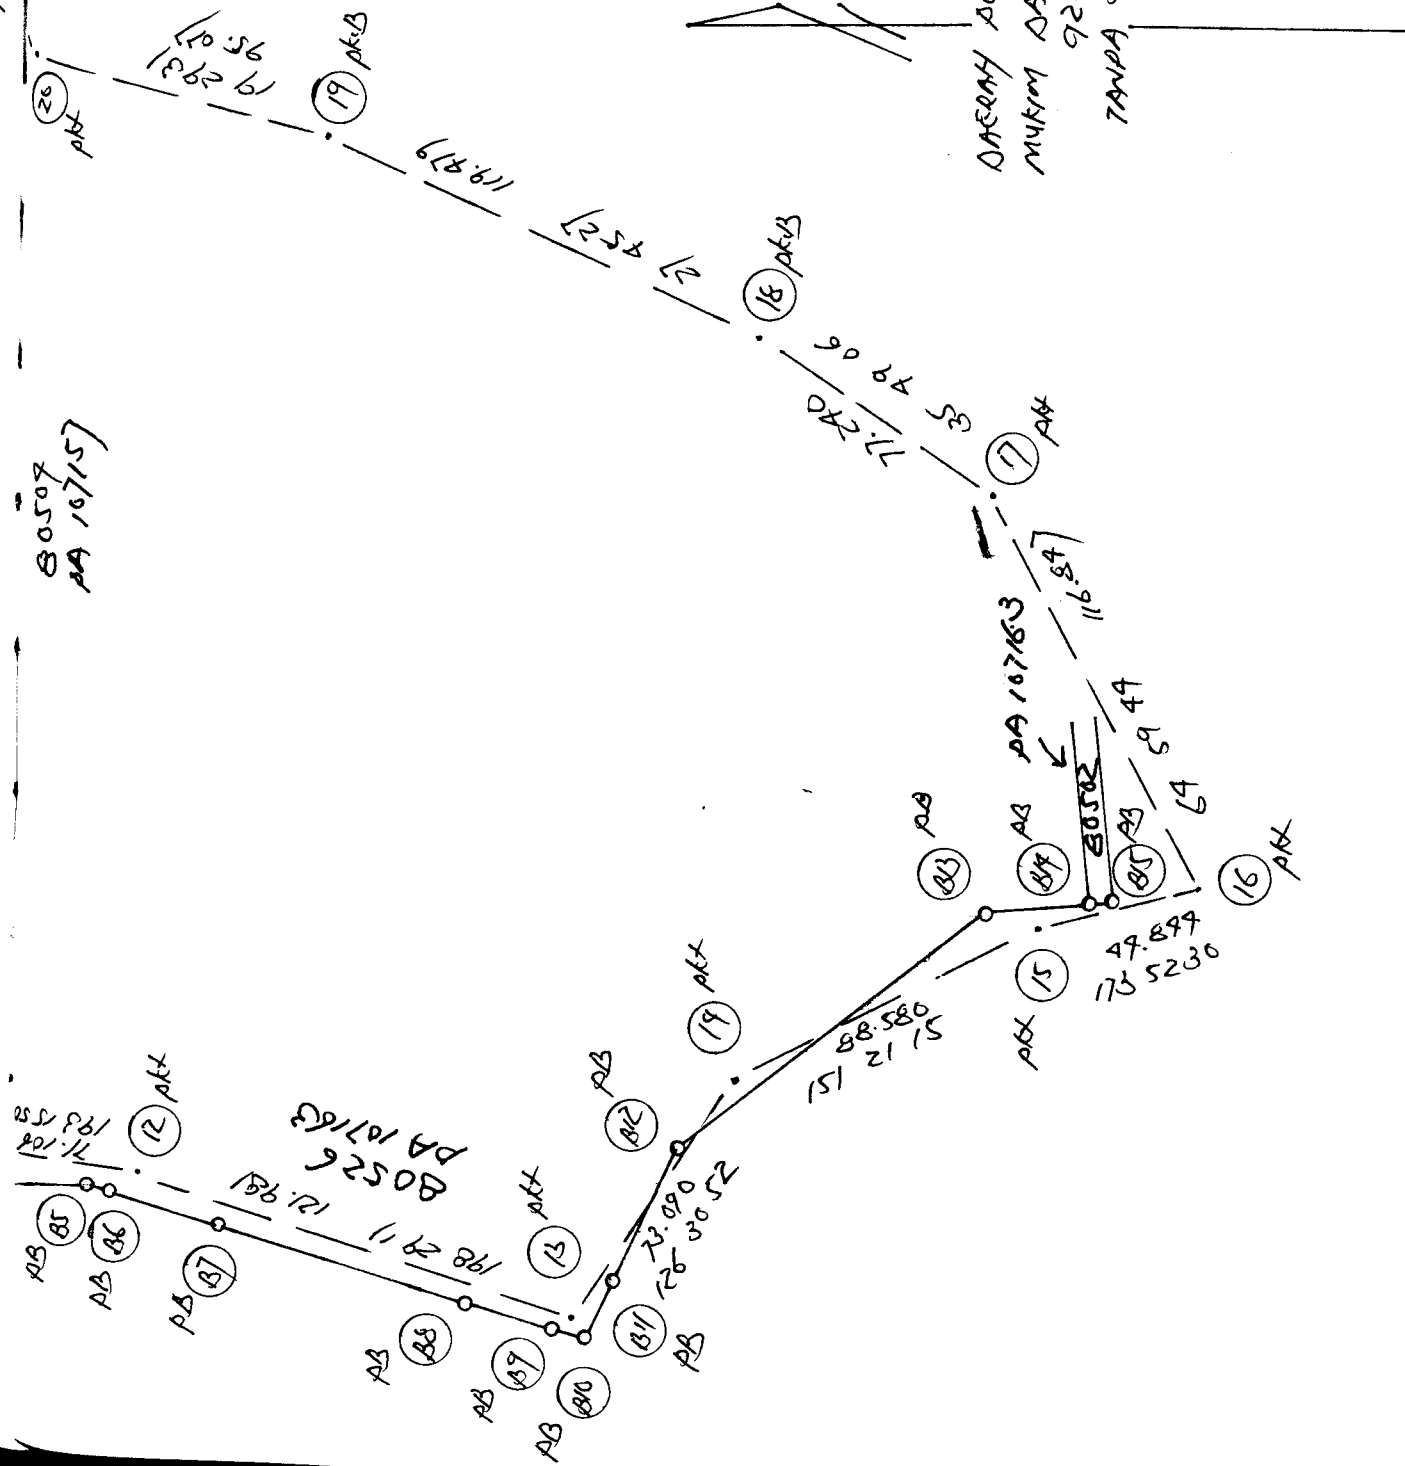

Penilik: JGC411 USJ HEIGHTS Tarikh: 16/06/2010  
 Stn. 2 Koordinat: S12299.916 B15875.197 Selangor  
 T.R. 1 B.K. Ms.  
 Tiodolit Satu bah. aras ufuk:

Waktu Sasaran Ufuk Gelembong Puguk

|      |      |           |  |           |                  |          |
|------|------|-----------|--|-----------|------------------|----------|
|      | T.R. | 270 00 00 |  |           | Waktu purata     | 9 16 30  |
| 9 16 | M.H. | 60 09 04  |  | 60 54 06  | Beza dari U.T. - | 8 00 00  |
| 9 16 | M.H. | 59 32 05  |  | 60 49 38  | U.T.             | 1 16 30  |
| 9 17 | M.H. | 239 29 46 |  | 299 16 30 | Deklinasi        | 23 20 14 |
| 9 17 | M.H. | 240 04 46 |  | 299 22 37 |                  |          |
|      | T.R. | 90 00 00  |  |           |                  |          |

|      |      |           |  |           |                  |          |
|------|------|-----------|--|-----------|------------------|----------|
|      | T.R. | 270 00 00 |  |           | Waktu purata     | 9 18 30  |
| 9 18 | M.H. | 60 04 14  |  | 60 29 38  | Beza dari U.T. - | 8 00 00  |
| 9 18 | M.H. | 59 27 11  |  | 60 26 11  | U.T.             | 1 18 30  |
| 9 19 | M.H. | 239 24 52 |  | 299 39 54 | Deklinasi        | 23 20 14 |
| 9 19 | M.H. | 240 00 04 |  | 299 45 45 |                  |          |
|      | T.R. | 90 00 00  |  |           |                  |          |

|                         | Set 1     | Set 2     |
|-------------------------|-----------|-----------|
| Sudut pugak             | 29 13 51  | 29 37 28  |
| Pembetulan              | - 0 01 26 | - 0 01 25 |
| Altitud                 | 29 12 25  | 29 36 03  |
| Jarak kutub             | 66 39 46  | 66 39 46  |
| Latitud                 | 3 03 46   | 3 03 46   |
| Azimut M.H. yang dikira | 64 52 33  | 64 47 42  |
| Purata ke M.H.          | 59 48 55  | 59 44 05  |
| Selisih:                | 5 03 38   | 5 03 37   |
| Purata ke T.R.          | 270 00 00 | 270 00 00 |
| Azimuth T.R. sebenar    | 275 03 38 | 275 03 37 |
| Pembetulan aras         | + 0 00 00 | + 0 00 00 |
| Tirusan                 | - 0 00 10 | - 0 00 10 |
| Bering grid T.R.        | 275 03 28 | 275 03 27 |
| Purata bering grid T.R. |           | 275 03 28 |

Tarikh ..... Aras .....  
Dibuat untuk .....  
Daripada ..... Ke .....

| Pandangan Belakang | Pandangan Antara | Pandangan Hadapan | Naik   | Turun | Aras Yang Dilaras | Jarak | Catilan |
|--------------------|------------------|-------------------|--------|-------|-------------------|-------|---------|
| 1.324              | (4.38)           |                   |        |       | 22.978            | 23    |         |
| 1.391              | (8.57)           | 3.037             | (9.96) |       |                   | 901   |         |
| 3.184              | (10.95)          | 0.086             | (0.28) |       |                   |       |         |
| 3.903              | (12.24)          | 4.328             | (1.08) |       |                   |       |         |
| 3.139              | (10.30)          | 0.283             | (0.96) |       |                   |       |         |
| 0.925              |                  | 0.925             | (3.08) |       | 30.786            | 11541 |         |
|                    | 1.503            | (4.83)            |        |       | 30.168            | 112   |         |
| 11.866             |                  | 6.112             |        |       |                   |       |         |
| 3.938              | (12.92)          |                   |        |       | 30.786            | 11061 |         |
| 3.780              | (12.90)          | 0.523             | (1.72) |       |                   |       |         |
| 2.017              | (6.62)           | 0.374             | (1.23) |       | 38.916            | 1167  |         |
|                    |                  | 0.688             | (2.19) |       |                   |       |         |
| 9.735              |                  | 1.565             |        |       |                   |       |         |

24

.....Ke

| Pandangan Belakang | Pandangan Antara | Pandangan Hadapan | Naik     | Turun | Aras Yang Dilaras | Jarak   | Catitan            |
|--------------------|------------------|-------------------|----------|-------|-------------------|---------|--------------------|
| 0.519              | (11.70)          |                   |          |       | 38.916            |         |                    |
| 0.080              | (10.26)          | 3.167             | (110.39) |       |                   |         |                    |
| 0.086              | (10.28)          | 3.710             | (111.19) |       |                   |         |                    |
| 0.305              | (1.00)           | 2.325             | (17.63)  |       |                   |         |                    |
| 0.055              | (10.18)          | 1.985             | (16.51)  |       |                   |         |                    |
| 0.017              | (10.06)          | 2.209             | (17.23)  |       |                   |         |                    |
| 1.773              | (14.83)          | 3.078             | (110.10) |       |                   |         |                    |
|                    | 1.649            | (15.4)            |          |       |                   | 72M 541 | RC: 23.633         |
|                    |                  | 1.687             | (15.53)  |       | 23.595            | 412     | RC: 23.595         |
| 2.535              |                  | 17.856            |          |       |                   |         | BM 81134 RC: 6.995 |