


JRS80996 Petronas SKUE.

26/12/09

|   |         |           |          |   |         |   |   |         |         |
|---|---------|-----------|----------|---|---------|---|---|---------|---------|
|   | Datum   | Corrupted | 2895957  | 2 | 2895357 | 1 | 4 | 52.737  | 52.737  |
|   | AA      |           | M- 5'57" |   | AJ At.  |   |   |         |         |
|   |         |           |          |   | Agg m4  |   |   |         |         |
| 1 | 2895957 | 895957    | 172011   | 2 | 171919  | 3 | 4 | 78.786  | 78.786  |
| 2 |         |           | M- 5'57" |   |         |   |   |         |         |
| 3 | 172011  | 1072011   |          |   |         |   |   |         |         |
|   |         | BKL       |          |   |         |   |   |         |         |
| 1 | Septi   | Di Atas   | 1692855  | 2 | 1692058 | 7 | 4 | 51.896  | 51.896  |
| 2 |         |           | M- 5'57" |   |         |   |   |         |         |
| 7 | 1692855 | 3792855   |          |   |         |   |   |         |         |
|   |         | BKL       |          |   |         |   |   |         |         |
| 1 | Septi   | Di Atas   | 772937   | 2 | 772370  | 5 | 4 | 172.327 | 172.327 |
| 2 |         |           | M- 5'57" |   |         |   |   |         |         |
| 5 | 772937  | 2572937   |          |   |         |   |   |         |         |
|   |         | pt. B     |          |   |         |   |   |         |         |
| 2 | 2572937 | 772937    | 2279133  | 5 | 2273536 | 6 | 4 | 61.822  | 61.822  |
| 5 |         |           | M- 5'57" |   |         |   |   |         |         |
| 6 | 2279133 | 779133    |          |   |         |   |   |         |         |
|   |         | pt. B     |          |   |         |   |   |         |         |

|     |     |      |        |        |
|-----|-----|------|--------|--------|
| 1-4 | 129 | 1735 | 80.775 | N      |
|     | 129 | 1350 | 80.503 | 10     |
|     |     |      | +75'   | -0.028 |

JAKRAY SEPANG.  
MUKIM DENGKIL  
1010  
TANDA SKALA

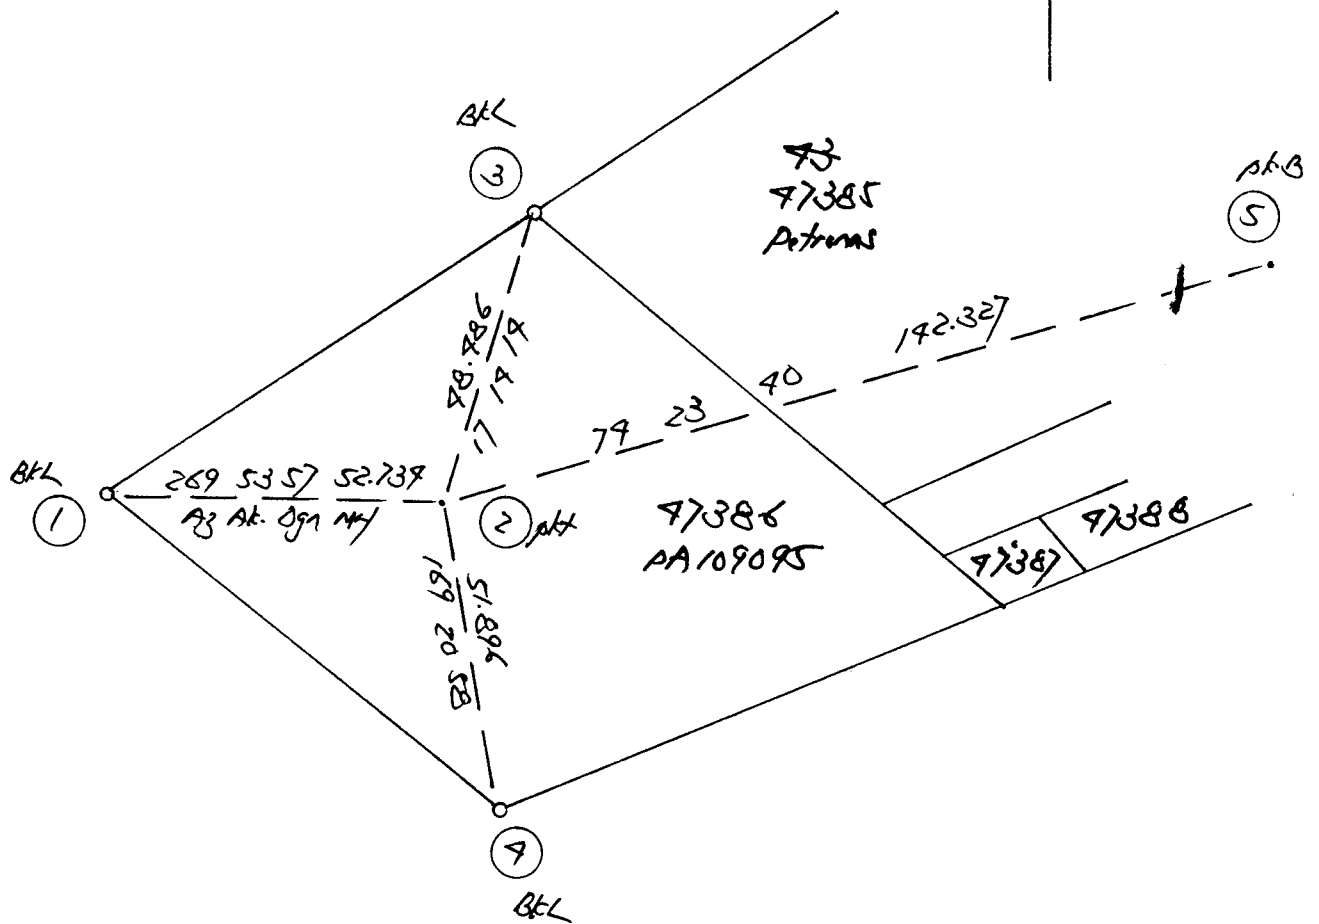

BUKTI PENGUKURAN BAKI AZIMUT

Penilik: JRS80946 Petronas SKVE Tarikh: 30/12/2009  
Stn. 2 Koordinat: S22214.751 B3225.252 Selangor  
T.R. 1 B.K. Ms.  
Tiodolit Satu bah. aras ufuk:

| Waktu | Sasaran | Ufuk      | Gelembong | Puguk                    |
|-------|---------|-----------|-----------|--------------------------|
|       | T.R.    | 269 57 41 |           |                          |
| 8 08  | M.H.    | 114 40 59 | 78 34 48  | Waktu purata 8 08 30     |
| 8 08  | M.H.    | 114 08 15 | 78 31 24  | Beza dari U.T. - 8 00 00 |
| 8 09  | M.H.    | 294 09 17 | 281 37 40 | U.T. 0 08 30             |
| 8 09  | M.H.    | 294 43 15 | 281 42 02 | Deklinasi - 23 10 17     |
|       | T.R.    | 89 57 41  |           |                          |
|       |         |           |           |                          |
|       | T.R.    | 269 57 41 |           |                          |
| 8 10  | M.H.    | 114 45 00 | 78 08 28  | Waktu purata 8 10 30     |
| 8 10  | M.H.    | 114 12 17 | 78 03 15  | Beza dari U.T. - 8 00 00 |
| 8 11  | M.H.    | 294 13 05 | 282 03 22 | U.T. 0 10 30             |
| 8 11  | M.H.    | 294 47 06 | 282 07 15 | Deklinasi - 23 10 17     |
|       | T.R.    | 89 57 41  |           |                          |

|                         | Set 1     | Set 2     |
|-------------------------|-----------|-----------|
| Sudut pugak             | 11 33 23  | 11 59 44  |
| Pembetulan              | - 0 04 05 | - 0 03 55 |
| Altitud                 | 11 29 18  | 11 55 49  |
| Jarak kutub             | 113 10 17 | 113 10 17 |
| Latitud                 | 2 58 24   | 2 58 24   |
| Azimut M.H. yang dikira | 114 22 11 | 114 26 12 |
| Purata ke M.H.          | 114 25 27 | 114 29 22 |
| Selisih:                | - 0 03 16 | - 0 03 10 |
| Purata ke T.R.          | 269 57 41 | 269 57 41 |
| Azimuth T.R. sebenar    | 269 54 25 | 269 54 31 |
| Pembetulan aras         | + 0 00 00 | + 0 00 00 |
| Tirusan                 | - 0 00 31 | - 0 00 31 |
| Bering grid T.R.        | 269 53 54 | 269 54 00 |
| Purata bering grid T.R. | 269 53 57 |           |

Tarikh . . . . . Aras

Dibuat untuk . . . . .

Daripada . . . . .

Ke . . . . .

| Pandangan Belakang | Pandangan Antara | Pandangan Hadapan | Naik | Turun | Aras Yang Dilaras | Jarak | Catitan |
|--------------------|------------------|-------------------|------|-------|-------------------|-------|---------|
| 3.466 (11.37)      |                  |                   |      |       | 70.683            | 78m   | 70.683m |
| 2.267 (7.94)       | 1.691 (5.39)     | 0.557 (1.83)      |      |       | 73.592            | FS    |         |
| 3.386 (11.11)      | 1.754 (5.78)     |                   |      |       | 74.105            | FL    |         |
| 1.895 (6.05)       | 0.771 (2.53)     |                   |      |       | 76.120            |       |         |
|                    | 1.566 (5.14)     |                   |      |       | 76.999            | FL    |         |
| 10.964             |                  | 76.78             |      |       |                   |       |         |

All the heights based on BM 82036