

TRJ 80952 Kemesch Heights.

Datum Danipada		72 5130 2		72 7640 1		4		75.086		75.086	
PA		M- 4'50" p.k.B		PL							
2-3	703627		2	703137	3	4		33.293	PL		33.293
2-4	795653		2	795203	4	4		13.806	pk.L		13.806
2-5	734217	M- 4'50"	2	733727	5	4		11.730	PL		11.730
2-6	691002		2	690512	6	4		10.206	PL		10.206
2-7	615021		2	614531	7	4		19.006	PL		19.006
2-8	622020		2	621530	8	4		17.959	PL		17.959
2-9	785033		2	784543	9	4		55.842	PL		55.842
1	72 5130 252 5130	257 7730	2	257 3940	10	4		71.979			71.979
2		M- 4'50"									
10	257 7730 77 7730										
	pk.B										
1	Seperti Di Atas	109 0949	2	109 0501	11	4		80.501			80.501
2		ct 2		A3 Ak.							
11	109 0949 229 0949	M- 4'50"		Sgn M4							
	pk.B										
2	229 0949 109 0949	228 5603	11	228 5117	12	4		42.770			42.770
11		ct 4									
12	228 5603 78 5603	M- 4'50"									
	pk.B										
11-13	220 3828		11	220 3828	13	4		31.803	PL		31.803
11-14	195 3919	M- 4'	11	195 3928	14	4		17.658	pk.L		17.658
11-15	198 1508	M- 4'50"	11	198 1022	15	4		15.121	pk.L		15.121
11-16	355 2119		11	355 1633	16	4		9.009	pk.L		9.009

Bapak-bapak

11 785603 2285603 2991738 12 2991259 17 4 72.597 72.597
 12 04 6
 17 2991738 691738 M-9'50"
 pkt
 12 691738 2991738 2672725 17 2672299 18 4 127.563 127.563
 17 04 9
 18 2672725 872725 M-9'50"
 pkt
 17 872725 2672725 3320259 18 3315820 19 4 38.866 38.866
 18 04 11
 19 3320259 1520259 M-9'50"
 pkt
 18 1520259 3320259 695582 19 695105 10 4 75.779 75.779
 19 04 13
 10 695582 2995582 M-9'50"
 19 2995582 695582 778915 10 773980 2 Sila Glat m/s 15 R 7
 10 04 15
 2 778915 2578915 M-9'50"

Bring 10-2 Sibaca 778915

Sipatut 779 778930

Tikar 17

-15" utk 7 sh

Pembetulan

2.19" pmta.




DAERAH GOMBAK
MUKIM UKU KELANG.
78B
TANDA SKALA


4-13 192 07 99 68.977 N
192 09 31 68.989 00

-1 22' -0.007

4-16 108 39 51 65.950 N
108 41 01 65.969 00

-1 10' -0.019

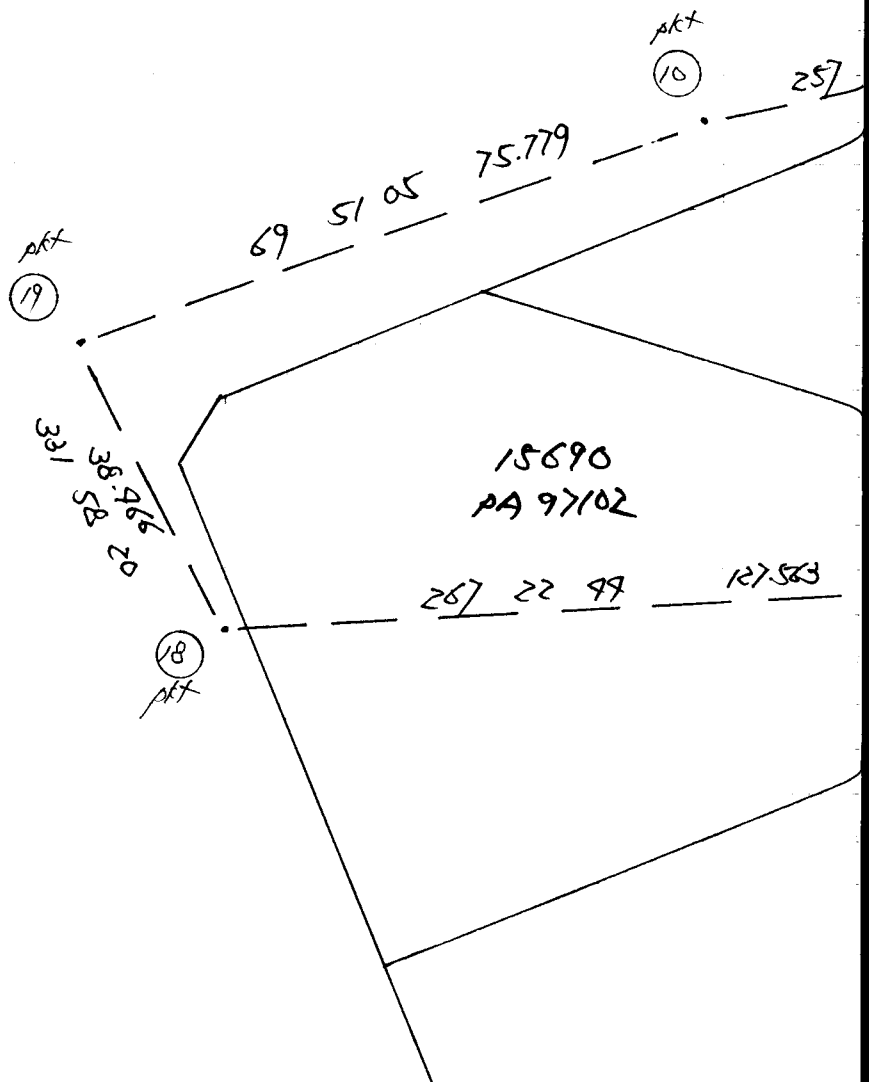

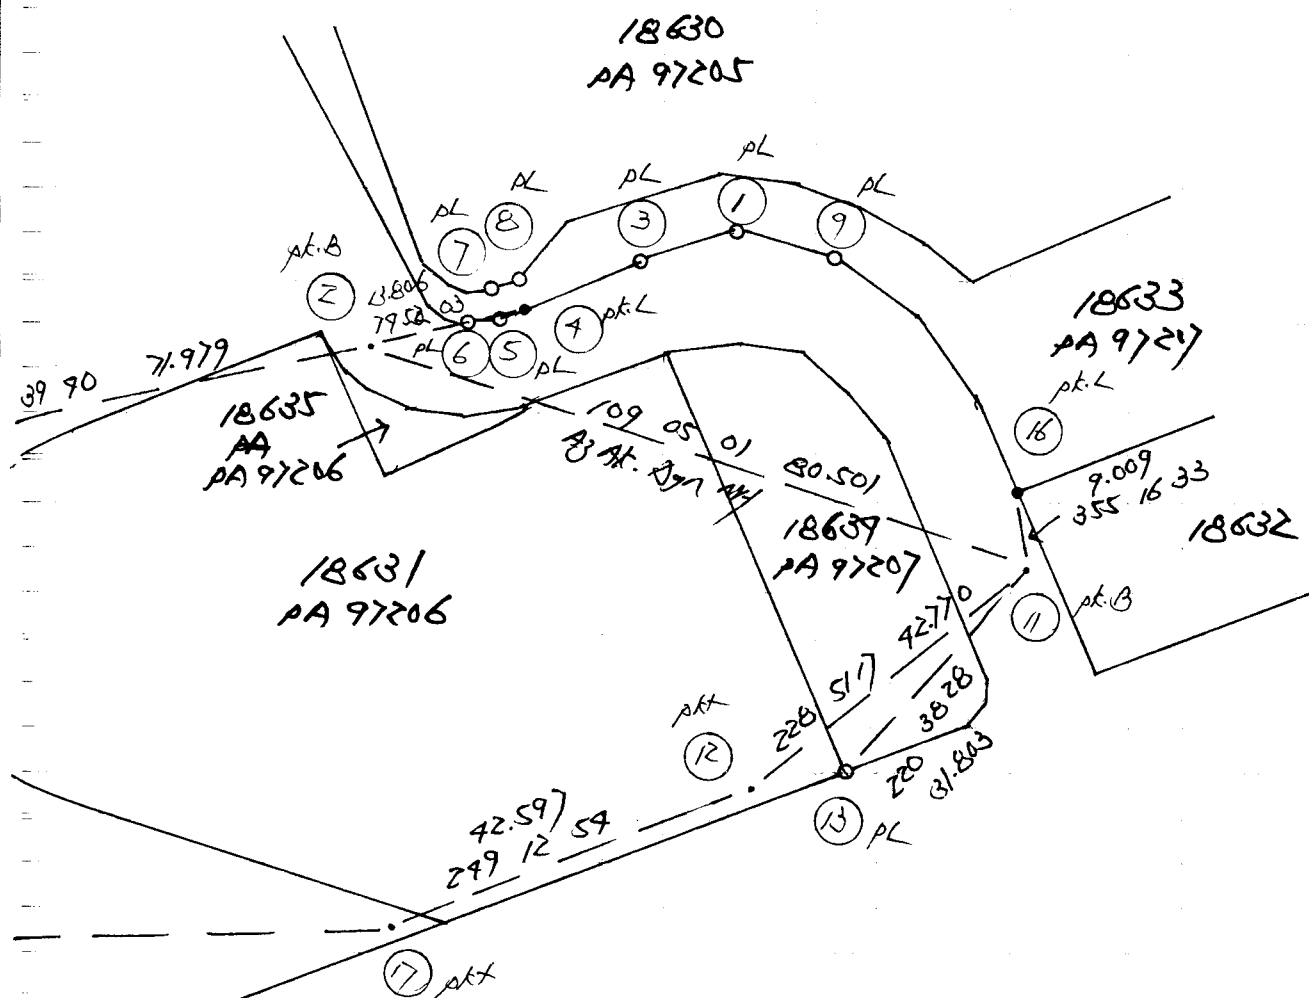

CERAPAN MATAHARI BAGI AZIMUT

Lokasi _____ Hari _____ Waktu _____ Bulan _____ Tahun _____
 Stasiun _____ No. _____ Koordinat _____

Penilik: JRS80952 Kemeseh Heights Tarikh: 05/01/2009

Stn. Koordinat: U4743.473 T6886.628 Selangor

T.R. B.K. Ms.

Tiodolit Satu bah. aras ufuk:

Waktu	Sasaran	Ufuk	Gelembong	Puguk
	T.R.	289 09 43		
10 26	M.H.	124 26 27	48 55 59	Waktu purata 10 26 30
10 26	M.H.	123 46 42	48 53 34	Beza dari U.T. - 8 00 00
10 27	M.H.	303 49 22	311 12 31	U.T. 2 26 30
10 27	M.H.	304 35 38	311 19 12	Deklinasi - 22 36 33
	T.R.	109 09 43		
	T.R.	289 09 43		
10 27	M.H.	124 42 08	48 32 57	Waktu purata 10 27 30
10 27	M.H.	124 01 50	48 30 43	Beza dari U.T. - 8 00 00
10 28	M.H.	304 04 13	311 35 05	U.T. 2 27 30
10 28	M.H.	304 51 31	311 42 10	Deklinasi - 22 36 33
	T.R.	109 09 43		

	Set 1	Set 2
Sudut pugak	41 10 33	41 33 24
Pembetulan	- 0 00 54	- 0 00 53
Altitud	41 09 39	41 32 31
Jarak kutub	112 36 33	112 36 33
Latitud	3 13 01	3 13 01
Azimut M.H. yang dikira	124 05 46	124 21 00
Purata ke M.H.	124 09 32	124 24 55
Selisih:	- 0 03 46	- 0 03 55
Purata ke T.R.	289 09 43	289 09 43
Azimuth T.R. sebenar	289 05 57	289 05 48
Pembetulan aras	+ 0 00 00	+ 0 00 00
Tirusan	- 0 00 52	- 0 00 52
Bering grid T.R.	289 05 05	289 04 56

Purata bering grid T.R. 289 05 01

27

Ke

Pandangan Belakang	Pandangan Antara	Pandangan Hadapan	Naik	Turun	Aras Yang Dilaras	Jarak	Catitan
1.630 (5.35)	1.657 (5.48)				77.571	78m x 1630	
	1.138 (3.72)				77.314	PL (56)	
	0.799 (2.62)				77.037	PL (45)	RL: 77.837m 7800.0
	0.773 (2.58)				78.198	PKL (59)	
	1.878 (5.16)				77.093	MY	
						PL	