



JRS 80968 Jln Melor 3, Kajang.

Satun Airipada 2327930 2 2327930 1 4 121.615 ^{13/1/10} 121.615
 pt-L pt-L
 (104 kum) (104 kum)

1 2327930 527930 2327930 2 2327930 6 4 32707 32707
 2
 6 2327930 527930

pt-L
 1 Seperti Ji Aka 2753207 2 2753207 51 4 25.189 25.189
 2
 51 2753207 2753207
 pt-B

2-52 3305300	2 3305300 52	4	8.096	pt-L <	8.096
6-53 2835358	6 2835358 53	4	10.058	pt-L <	10.058
51-57 2837605	25/2837605 57	4	70.373	pt-L	70.373
51-55 3133200	51 3133200 55	4	32.965	PL	32.965
2-56 2552651	2 2552651 56	4	20.536	PL	20.536

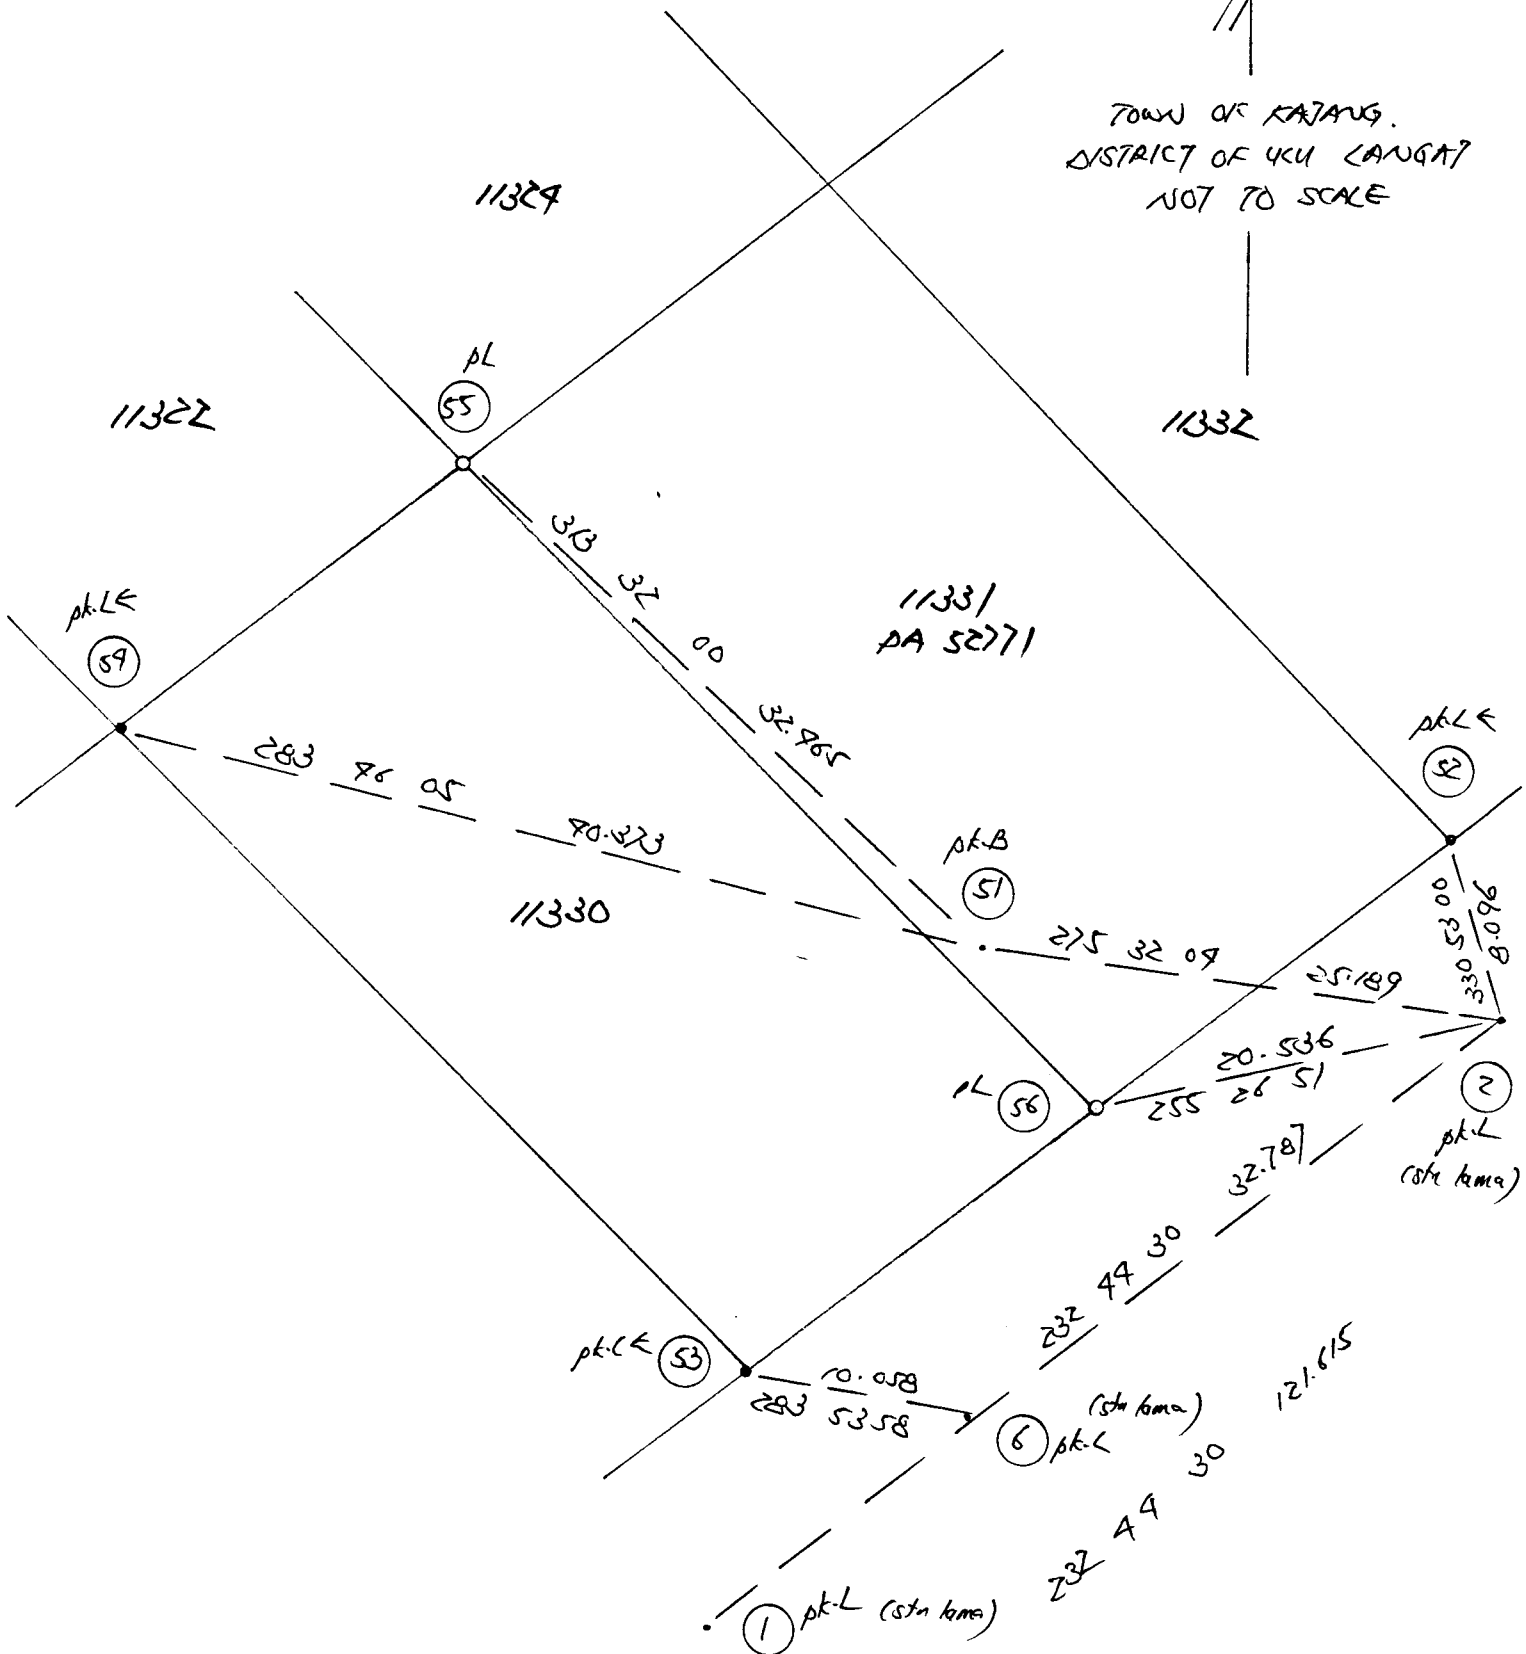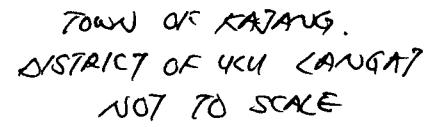

T/A Mkr 3 Kijang

Aras

Dibuat untuk

32

Daripada

TR 40908

Lot 11331

Ke

Pandangan Belakang	Pandangan Antara	Pandangan Hadapan	Naik	Turun	Aras Yang Dilaras	Jarak	Catitan
1.553	15.10				32.986	15.39 (15.51)	
	1.59	15.22			32.908	78m	RC: 32.908m BM 8/1907
	2.183	17.16			31.816	150	
	2.195	17.03			31.859	52m W.C.	
		0.975	13.20		33.029	12	