

JRS 8/188 KIP.

No. Lail

Rajab d. maka

No. Lail		Rajab d. maka							
No. Lail		Rajab d. maka							
Jatim Daripada		1203558	2	1203558	1	4	177.282	177.282	
PA		pkB		A3 Ak.		pk.L			
				Dgn M4					
2-3/	119 2307	299 2307	2	299 2307	3	4	12.896	pk.L	12.896
2-4	300 5726	120 5726	2	300 5726	7	4	61.555	pk.L	61.555
2-5	303 0321		2	303 0321	5	4	7.273	pk.L	7.273
1	120 3558	300 3558	21/3737	2	21/3737	6	4	65.890	65.890
2	6	21/3737	31/3737						
		pk.B							
1	Septi Di Atas	315 5303	2	315 5303	7	4	57.793		57.793
2	7	315 5303	135 5303						
		pk.H							
2	135 5303	315 5303	310 7113	7	310 7113	8	4	73.355	73.355
7	8	310 7113	130 7113						
		pk.H							
7	130 7113	310 7113	217 1058	8	217 1058	9	4	69.969	69.969
8	9	217 1058	317 1058						
		pk.H							
7	Septi Di Atas	300 0927	8	300 0927	10	4	96.659		96.659
8	10	300 0927	120 0927						
		pk.H							

15 20/1702 21/1702 27/5859 17 27/5859 18 4 38.352 38.352

17

18 27/5859 20/5859

pkh

17 20/5859 27/5859 1153206 18 1153206 19 4 21.032 21.032

18

19 1153206 2953206

pkh

17 Seperti Di Atas 21516 18 21516 20 4 73.883 73.883

18

9 20 21516 1821516

pkh

18 1821516 21516 371100 20 371100 20 4 69.970 69.970

9 20

9 8 371100 271100

9 20 271100 371100 1307113 8 1307113 7 Sila Lihat m/s 23 R5

8

7 1307113 3107113

Beriny 8-7 Dibaca 1307113

Seperti itu Dibaca 1307113


Tikarai Ni/


Pembetulan Ni/

DAERAH GOMBAK
 BANGKAR KEPONG.
 77C
 TANPA SKALA

16-19	30 73 18	103.522	N
	30 73 00	103.571	PO
	718"	-0.019	

16-5	765003	195.879	N
	765010	195.878	PO
	-7"	+0.001	

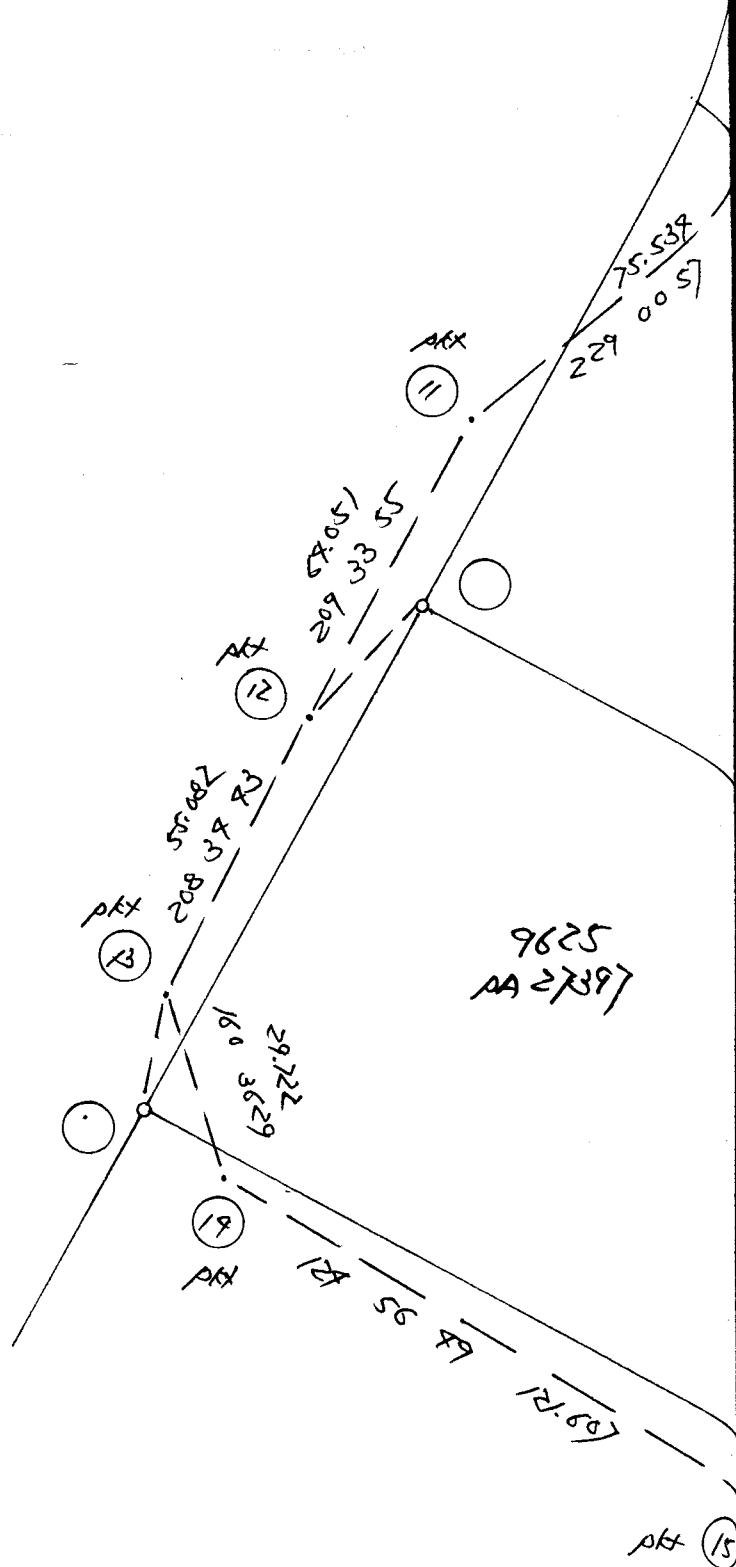

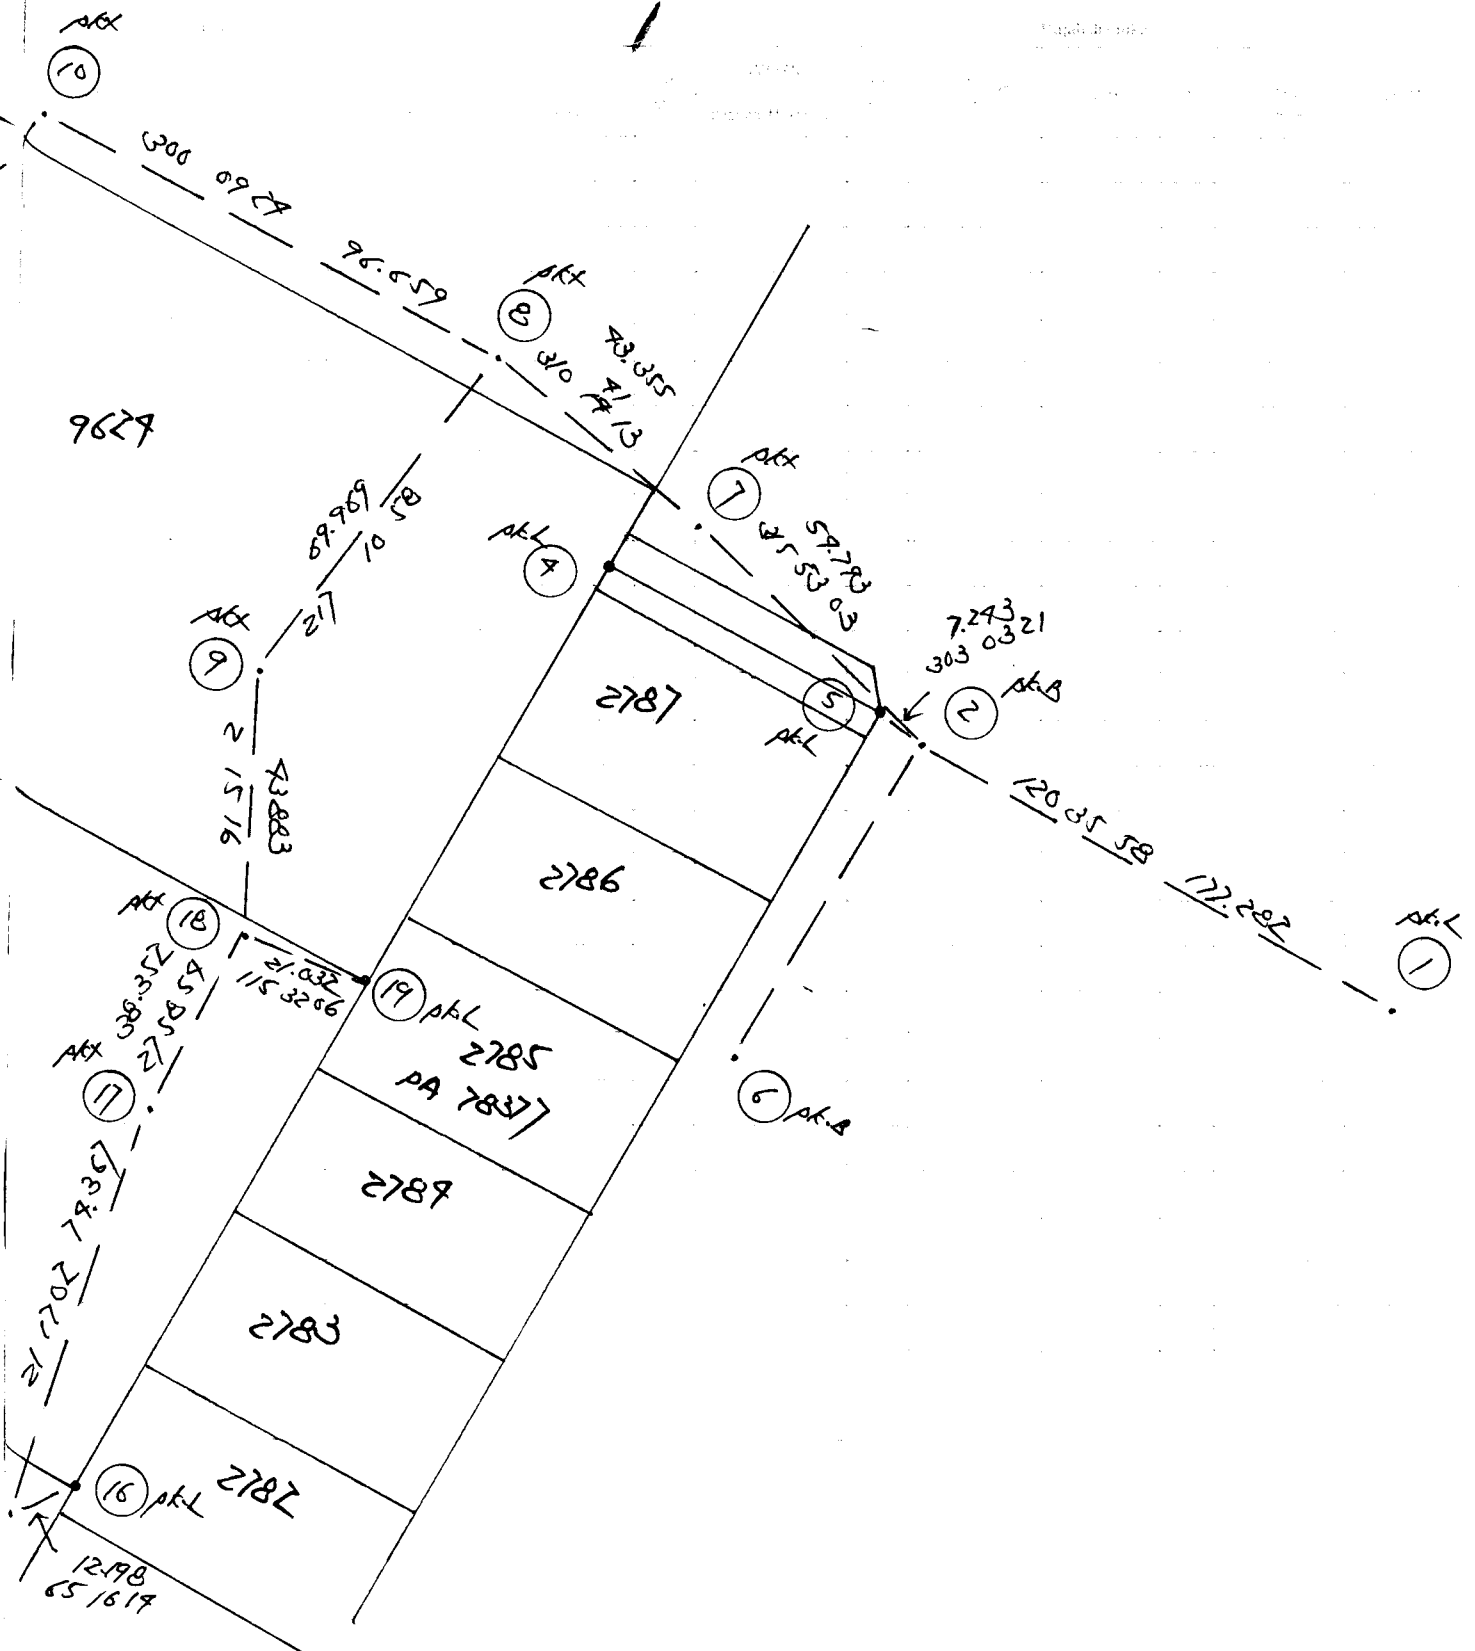

Penilik: JRS81188 KIP Tarikh: 20/06/2010
 Stn. 2 Koordinat: U3458 B10848 Selangor
 T.R. 1 B.K. Ms.
 Tiodolit Satu bah. aras ufuk:

Waktu	Sasaran	Ufuk	Gelembong	Puguk		
	T.R.	135 00 00				
8 12	M.H.	81 17 35		75 34 50	Waktu purata	8 12 30
8 12	M.H.	80 44 42		75 27 34	Beza dari U.T. -	8 00 00
8 13	M.H.	260 43 52		284 37 52	U.T.	0 12 30
8 13	M.H.	261 16 15		284 42 38	Deklinasi	23 25 52
	T.R.	315 00 00				
	T.R.	135 00 00				
8 14	M.H.	81 16 16		75 09 10	Waktu purata	8 14 30
8 14	M.H.	80 43 25		75 04 27	Beza dari U.T. -	8 00 00
8 15	M.H.	260 42 37		285 01 52	U.T.	0 14 30
8 15	M.H.	261 15 07		285 05 34	Deklinasi	23 25 52
	T.R.	315 00 00				

	Set 1	Set 2
Sudut pugak	14 34 32	14 58 27
Pembetulan	- 0 03 12	- 0 03 07
Altitud	14 31 20	14 55 20
Jarak kutub	66 34 08	66 34 08
Latitud	3 12 20	3 12 20
Azimut M.H. yang dikira	66 36 54	66 35 38
Purata ke M.H.	81 00 36	80 59 21
Selisih:	- 14 23 42	- 14 23 43
Purata ke T.R.	135 00 00	135 00 00
Azimuth T.R. sebenar	120 36 18	120 36 17
Pembetulan aras	+ 0 00 00	+ 0 00 00
Tirusan	- 0 00 20	- 0 00 20
Bering grid T.R.	120 35 58	120 35 57
Purata bering grid T.R.		120 35 58

Tarikh 07/08/1996

Aras

Dibuat untuk

22

Daripada K/P

Ke

Pandangan Belakang	Pandangan Antara	Pandangan Hadapan	Naik	Turun	Aras Yang Dilaras	Jarak	Catitan
1.283	(19.21)				74.595	78M H2 / 78M F1/229	RL: 74.595
1.524	(15.00)	1.388	(18.55)				BMP2109
1.506	(14.98)	1.531	(15.02)				
7.303		0.770	(2.53)		75.219	78M F1/230 / Adu Hydrant.	
		0.689					Di hadapan Rumah Kibang 299, Jln KPA3
0.992	(13.25)				75.219	78M F1/230	
	1.564	(15.13)			74.647	F2	
	1.452	(14.76)			74.759	78M F1/231 Adu Jkt L	
2.554	(18.39)	0.771	(2.53)		75.440	q	
3.398	(11.14)	0.349	(1.18)		77.649		
	1.234	(14.05)			79.813	78M F1/232 Adu Lingky	
3.554	(11.66)	4.161	(10.53)		80.886		
2.712	(18.90)	0.000 (0.98)			84.140		
	0.835	(2.87)			85.977		
		1.051	(3.45)		85.891		
N.214		2.632					
						R1/318	
						78M F1/233 concrete pipe.	