

No. Fail JRS 80252

Rajah di muka

[illegible]

[illegible]

No. Fail

Stesen

Penyilang Kiri

BEARING / SUDUT

Penyilang Kanan

Perata

Dari

GARISAN

Bearing Muklumat

Ke

Stn. Sudut Pukak
(±)


Rajah di muka

Jarak

Suhu

Jarak
Antara
Tupang


Jarak Muklumat

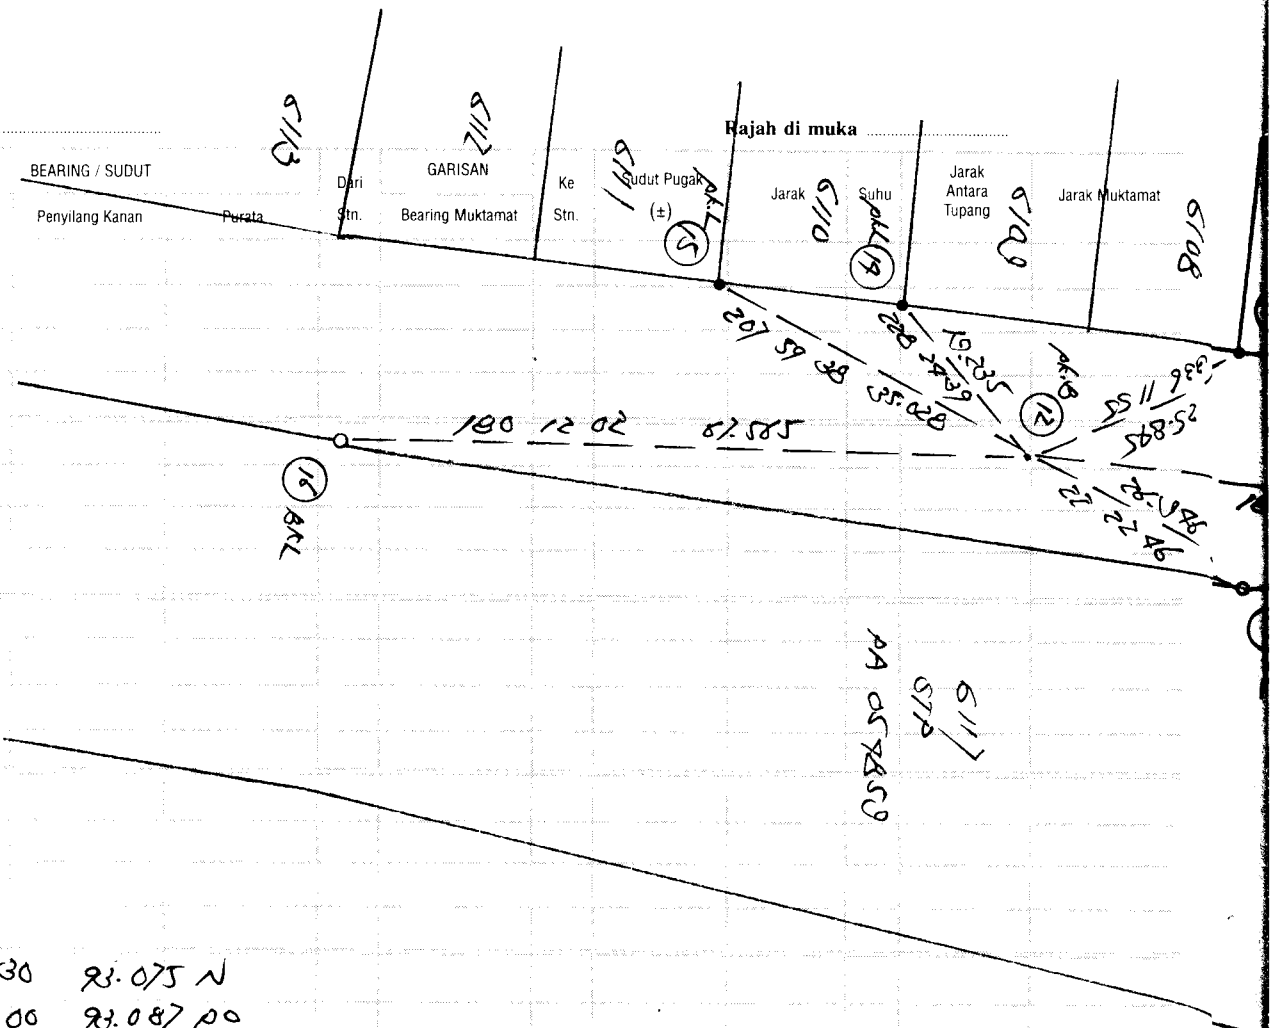

16-20 186 28 30 23.075 N
 186 30 00 23.087 PO
 - 1 30' -0.012

18-16 186 22 21 176.792 N
 186 27 17 176.792 PO
 - 1 53' N

18-17 235 19 22 5.969 N
 235 19 30 5.971 PO
 - 8' -0.007

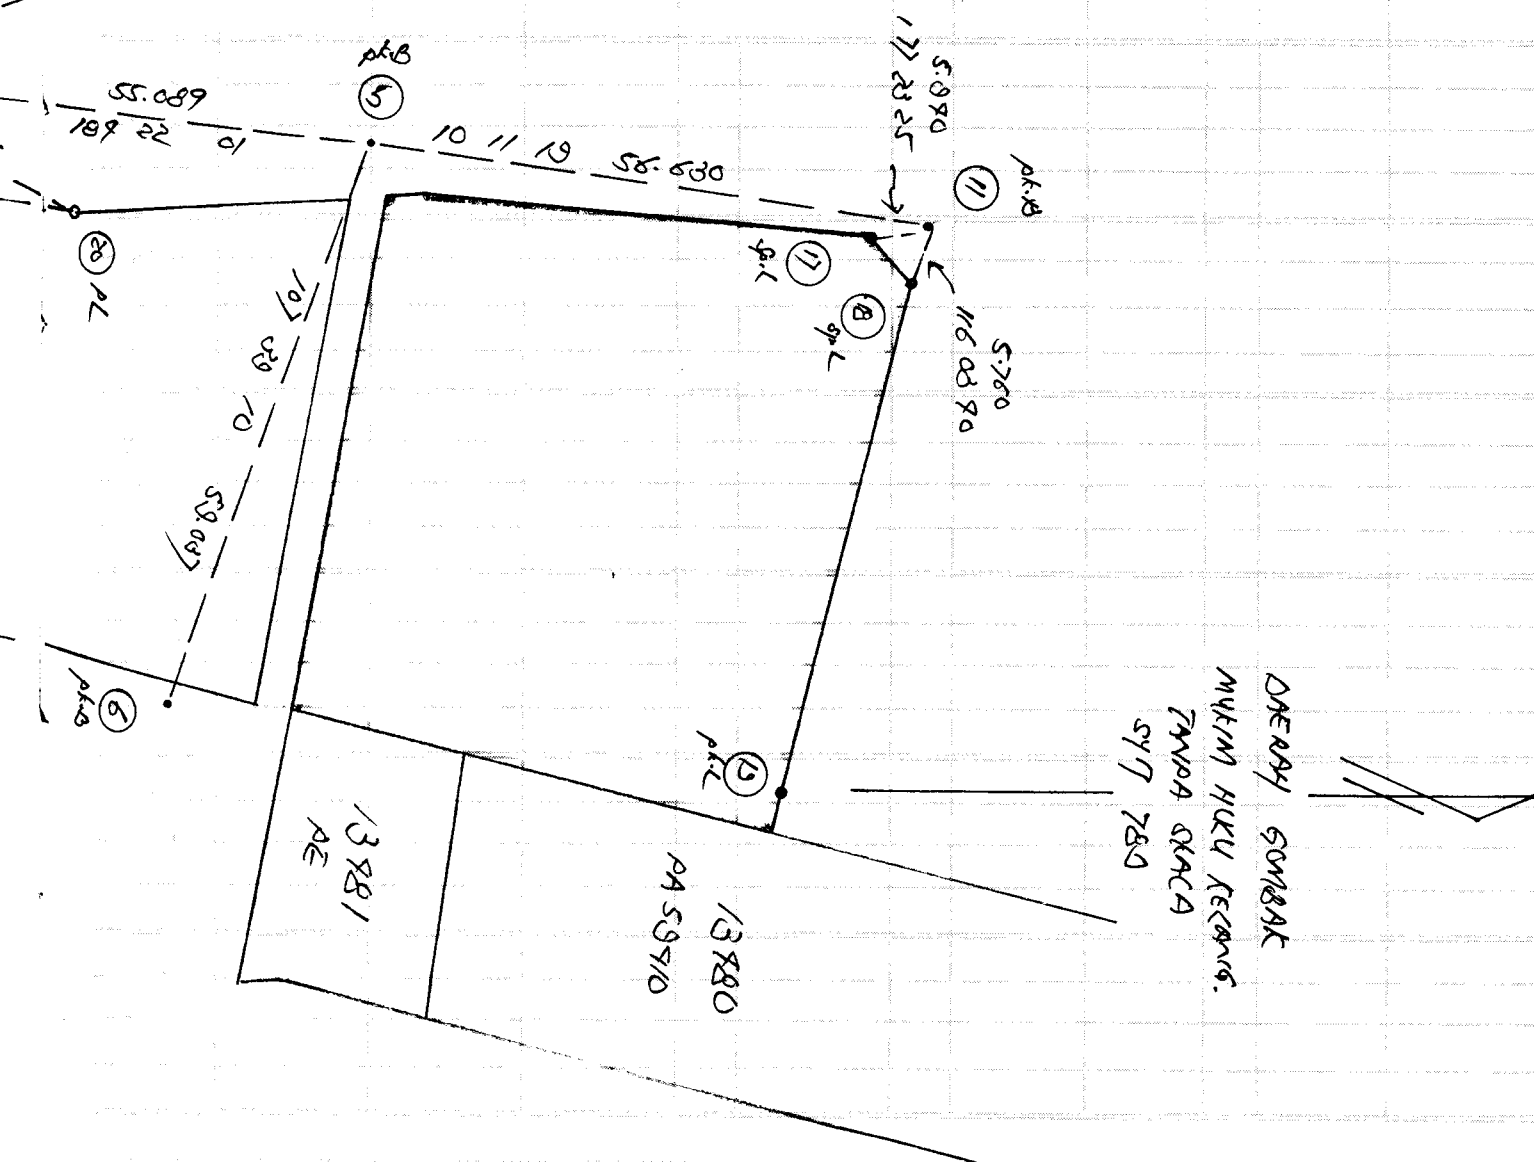[illegible]

CERAPAN MATAHARI BAGI AZIMUT

Penilik Foo Che Yang Hari Tova Tarikh 12/9/07 Bulan 12/9/07 Tahun 12/9/07

Stesen 1 T.R. 2 B.K. Ms. Tiodolait (Jenis) I Bah. Aras Ufuk - a

Formula: Kosain AZIMUT = $\frac{\text{Kos } P - \text{Sain } \phi \text{ Sain } \alpha}{\text{Kos } \phi \text{ Kos } \alpha}$ TR 80252 Kg Asir. PE. Khamis

Pembetulan Aras = $\frac{2}{8} (\pm R - \pm L)$ tenjen α

Waktu		Ufuk			Gelem-bong		Pugak			Bila waktu jam tangan tidak dalam lingkungan 3 minit daripada waktu piawai: Hitung waktu umum.			W.U. - 12 ^J + W.T.K. - G. Bujur - E					
J	m	P.Ki	T.R.			Ki	Ka					J	m	12 ^J	00 ^m			
				93	00	00												
				81	52	53		57	07	57								
				81	17	38		57	09	36								
		P.Ka		261	17	22		303	09	71								
				261	52	25		303	09	71								
Purata ①		T.R.																
J	m																	
928								33	00	27								
		Purata Ke matahari		81	33	35		1	17									
		Purata Ke TR						32	59	13								
J	m	P.Ki	T.R.															
				81	52	11		56	43	08								
				81	13	07		56	37	29								
		P.Ka		261	13	16		303	30	73								
				261	51	23		303	37	19								
Purata ②		T.R.																
J	m																	
928								33	28	51								
		Purata Ke matahari		81	32	36		1	39									
		Purata Ke TR						33	25	12								
Kordinat Origin U/B		55961			m		Kordinat Origin T/B		27759			m		Purata Bg. Gerid T.R.		93 22 51		
Stesen U/B		2016			m		Stesen T/B		7696			m		Ditilik oleh		12/9/07 M + 80° 22' 51"		
Jumlah/Sel.		53095			m		Jumlah/Sel.		28855			m		Dihitung oleh		19/11		
Jumlah/Sel. x 0.03256 ±		-0			29		16		Sel. G. Bujur - Jum. Sel.		x 0.03246 ±		15' 37"		Tarikh			
G. Lintang Origin U		3			78		79		Sel. G. Bujur x Sain G. Lintang -									
G. Lintang Stesen U		3			11		33		T (-) / B (+) Tirusan		-		52'					

P.Ki. - Penyilang Kiri
P.Ka. - Penyilang Kanan

T.R. - Tanda Rujuk
Sel. - Selisih

W.U. - Waktu Umum
W.T.K. - Waktu Tempatan Ketara

Tarikh

22.11.80

Aras

Dibuat untuk

22


Daripada

Basir Bangpa/ku

Ke

4101 ☐ K 805 Antabangpa no 3

Pandangan Belakang	Pandangan Antara	Pandangan Hadapan	Naik	Turun	Aras Yang Dilaras	Jarak	Catitan
0.360 (11.8)	0.550 (11.80)				90.796	→ 78M F11K	78M F11K nail on top of con. drain.
0.085 (10.28)	0.678 (12.23)	0.435 (12.58)			190.606	→ F11	F11
0.199 (10.65)	2.395 (12.86)	3.735 (12.25)			187.321	→ AS	9
0.777 (11.8)	1.638 (15.3)	3.798 (12.96)			186.728	→ 78M F11K	nail on top of samp.
0.016 (10.05)	1.711 (14.63)	3.806 (12.99)			80.072	→ R6	
2.551	1.798 (14.91)	3.075 (10.69)			78.878	→ F7	
		19.797			73.651	→ R10	

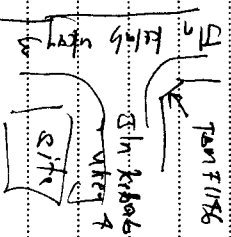

Tarikh Aras

Dibuat untuk

Daripada

Ke

Pandangan Belakang	Pandangan Antara	Pandangan Hadapan	Naik	Turun	Aras Yang Dilaras	Jarak	Catitan
1.792					73.569		F10
1.619	(530)	2.136	(7.01)				
1.798	(9,75)	1.691	(5.55)				
1.828	(6.00)	1.650	(5.91)				
3.719	(1238)	0.210	(0.69)				
1.650	(591)	0.399	(1.13)				
		0.659	(2.16)		78.686		78M F1028 nylon top of culvert. RC: 78.686 (49 pwh) 78.80438.
11.812		6.69					1807 m/s 9 BM W0096 Masjid mekanti