

JRS 81729 Bkt Sordang 5

No. Fail


Rajah di muka

Jenis	BEARING / SUDUT			Dari Stn	GARISAN	Ke Stn	Sudut Pukak (°)	Jarak	Sudut	Jarak Antara Bang	Jarak Mukamat
	Penyulang Kiri	Penyulang Kanan	Purata								
	Datum Daripada			2	257/1599	1	4	119.116	28/9/201		119.116
					pkB Aj Ak. BKL Dgn M4 pKL						
1	257 27	27 27	330 592	2	330 592	3	4	90.991			90.991
2					pkB						
3	330 592	150 592									
					pkB						
2-5	322 1353			2	322 1353	5	4	87.680	pkL		87.680
2-6	328 9658			2	328 9658	6	4	12.733	pkL		12.733
2-7	335 1951			2	335 1951	7	4	91.972	BKL		91.972
2-8	96 9925			2	96 9925	8	4	108.599	BL		108.599
1	27 1599	27 1599	150 9299	2	150 9299	9	4	51.929			51.929
2											
9	150 9299	330 9299									
					pkL						
2	330 9299	150 9299	105 0120	9	105 0120	10	4	85.622			85.622
9											
10	105 0120	285 0120									
					pkL						
10-11	159 0909			10	159 0909	11	4	130.597	BL		130.597
10-12	125 2219			10	125 2219	12	4	206.862	PL		206.862

DAERAH PETALING.
MUKIM PETALING.

Rajah di muka

TAUAPA STAGA

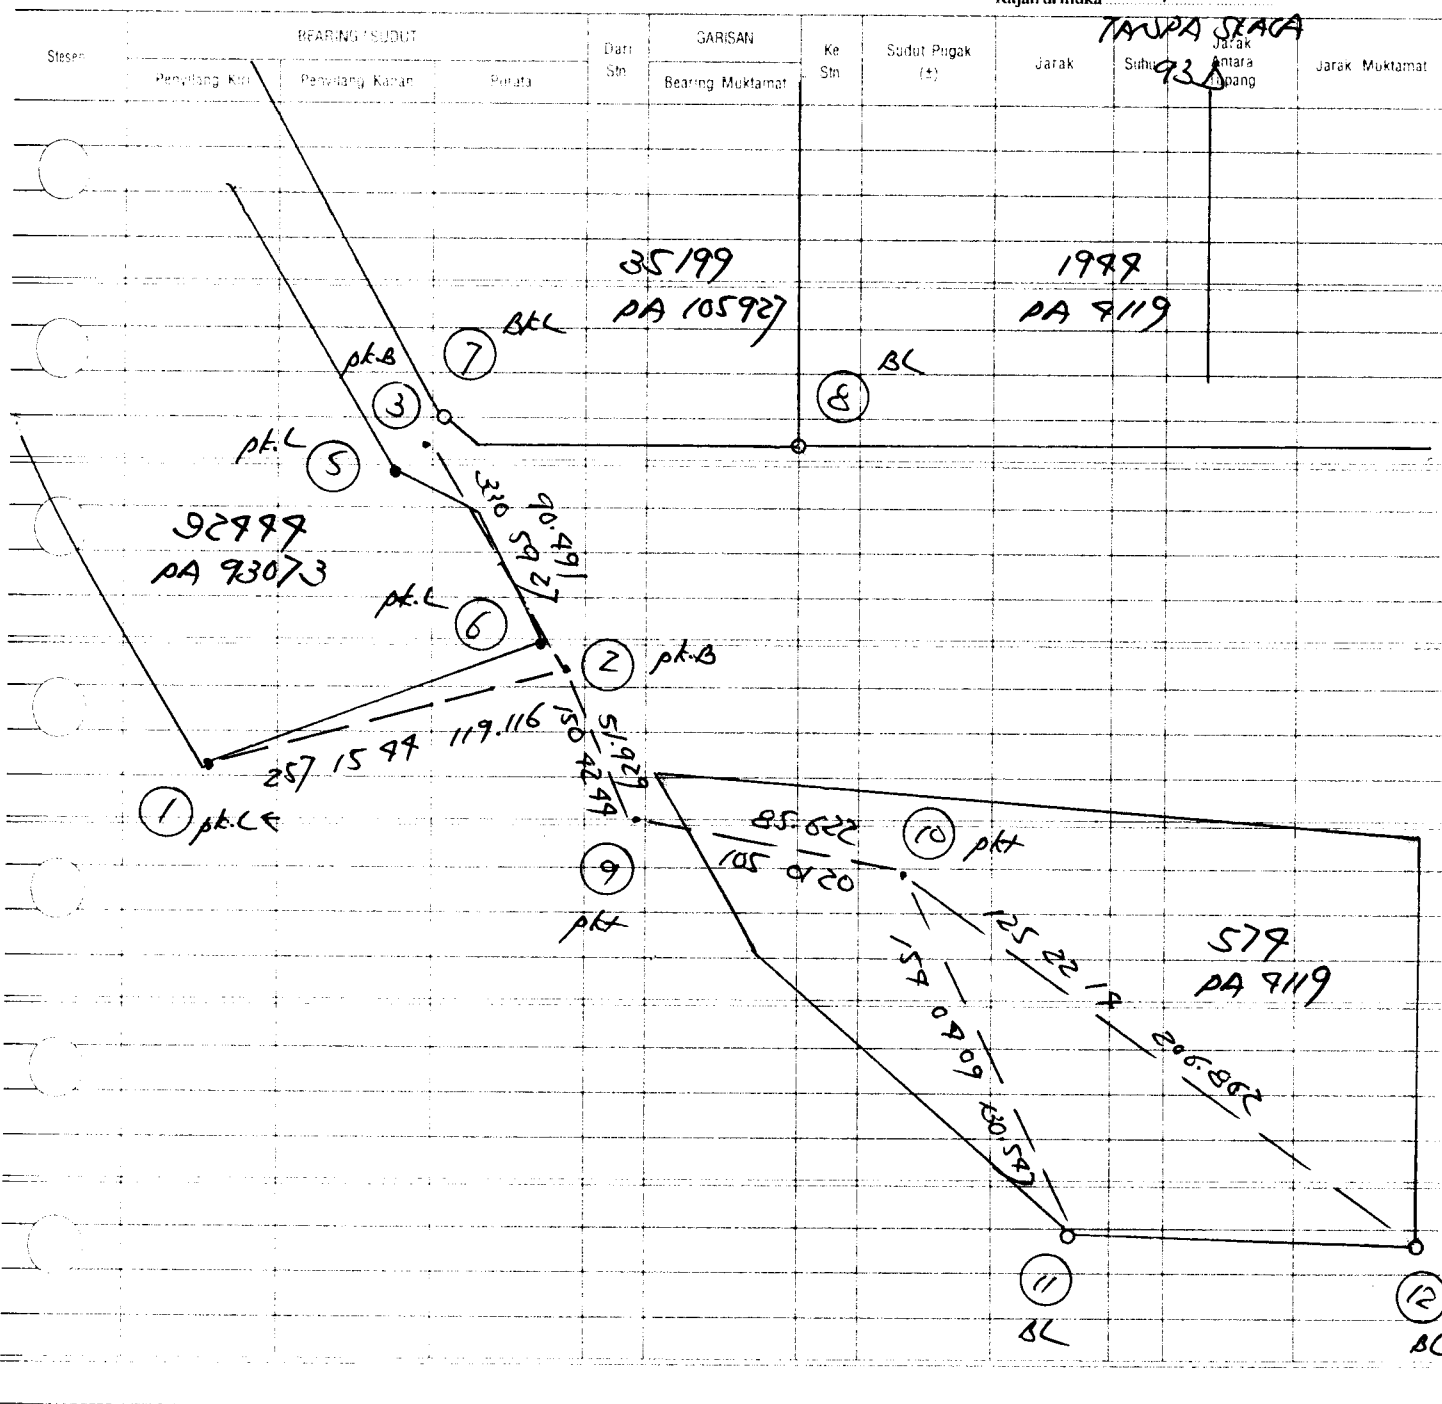

Tarikh

8th July 5

Aras

Dibuat untuk

35

Daripada

GRS 8/78

Ke

Pandangan Belakang	Pandangan Antara	Pandangan Hadapan	Naik	Turun	Aras Yang Dilaras	Jarak	Catitan
--------------------	------------------	-------------------	------	-------	-------------------	-------	---------

1.12 (370)

2883 (8.67)

1.859 (6.10)

0.657

1.600

(2.16)

60.198

58.632

60.618

60.877

78M GRS2

F100

F1002

78M F198 (1988) axi long. ang.

RC: 60.198M

Am: 85339 RC: 72.083M

GRS/0092/SE411/12

(Gndn) ur 2660