

Jesa Aman
JRS 81730

No. Fail

Rajah di muka

Stesen	BEARING - SUDUT			Dari Sta	GARISAN		Ke Stn	Sudut Pagar (°)	Jarak	Sudut	Jarak Antara pipang
	Pembiang Kiri	Pembiang Kanan	Purata		Bearing Muktamad						
	Datum Daripada			2	132 33 39	1	4	105.501			
				pk.B	Aj A.L.	pk.B					
					Ag 114						
	1	132 33 39	312 33 39	219 25 01	2	219 25 01	3	4	116.533		
	2										
	3	219 25 01	39 25 01								
		BKL									
2	1-4	100 21 90		1	100 21 90	4	4	97.705		pk.B	
	1-5	100 49 51		1	100 49 51	5	4	53.997		pk.B	
											78M/1995
	2	312 33 39	132 33 39	129 29 25	1	129 29 25	6	4	167.757		
	1										
	6	129 29 25	309 29 25								
		pk.B									
	1	309 29 25	0129 29 25	39 23 31	6	39 23 31	7	4	162.117		
	6										
	7	39 23 31	219 23 31								
		pk.B									
10	7-8	112 39 43		7	112 39 43	8	4	9.809		AL	
	7-9	117 35 33		7	117 35 33	9	4	73.255		AL	
	7-10	117 43 28		7	117 43 28	10	4	117.522		AL	


Amoraticum.

5-9 117 5656 68.706 ✓
 117 5500 68.717 PO
 71 568 -0.01/

8-10 117 569 112.673 ~
117 5736 112.699 00
+2' 11" -0.021

B-3 280 9392 382.912 ✓
280 9250 382.931 00

152 -0.019

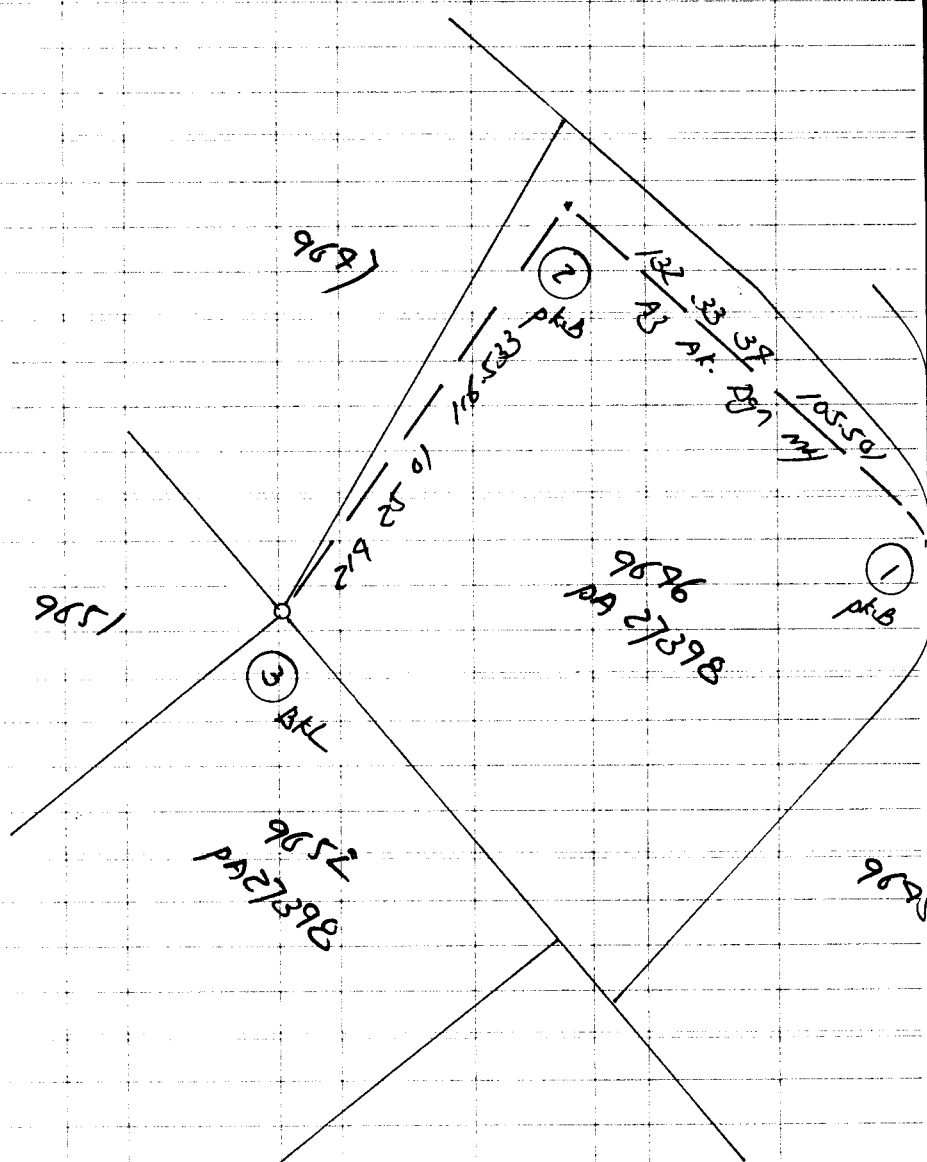


No. Lail

DAERAH GOMBAK

BANDAR SYUGA/ BUKIT

JARAK
TANDA SKALA
Muktamat

Rajah di muka

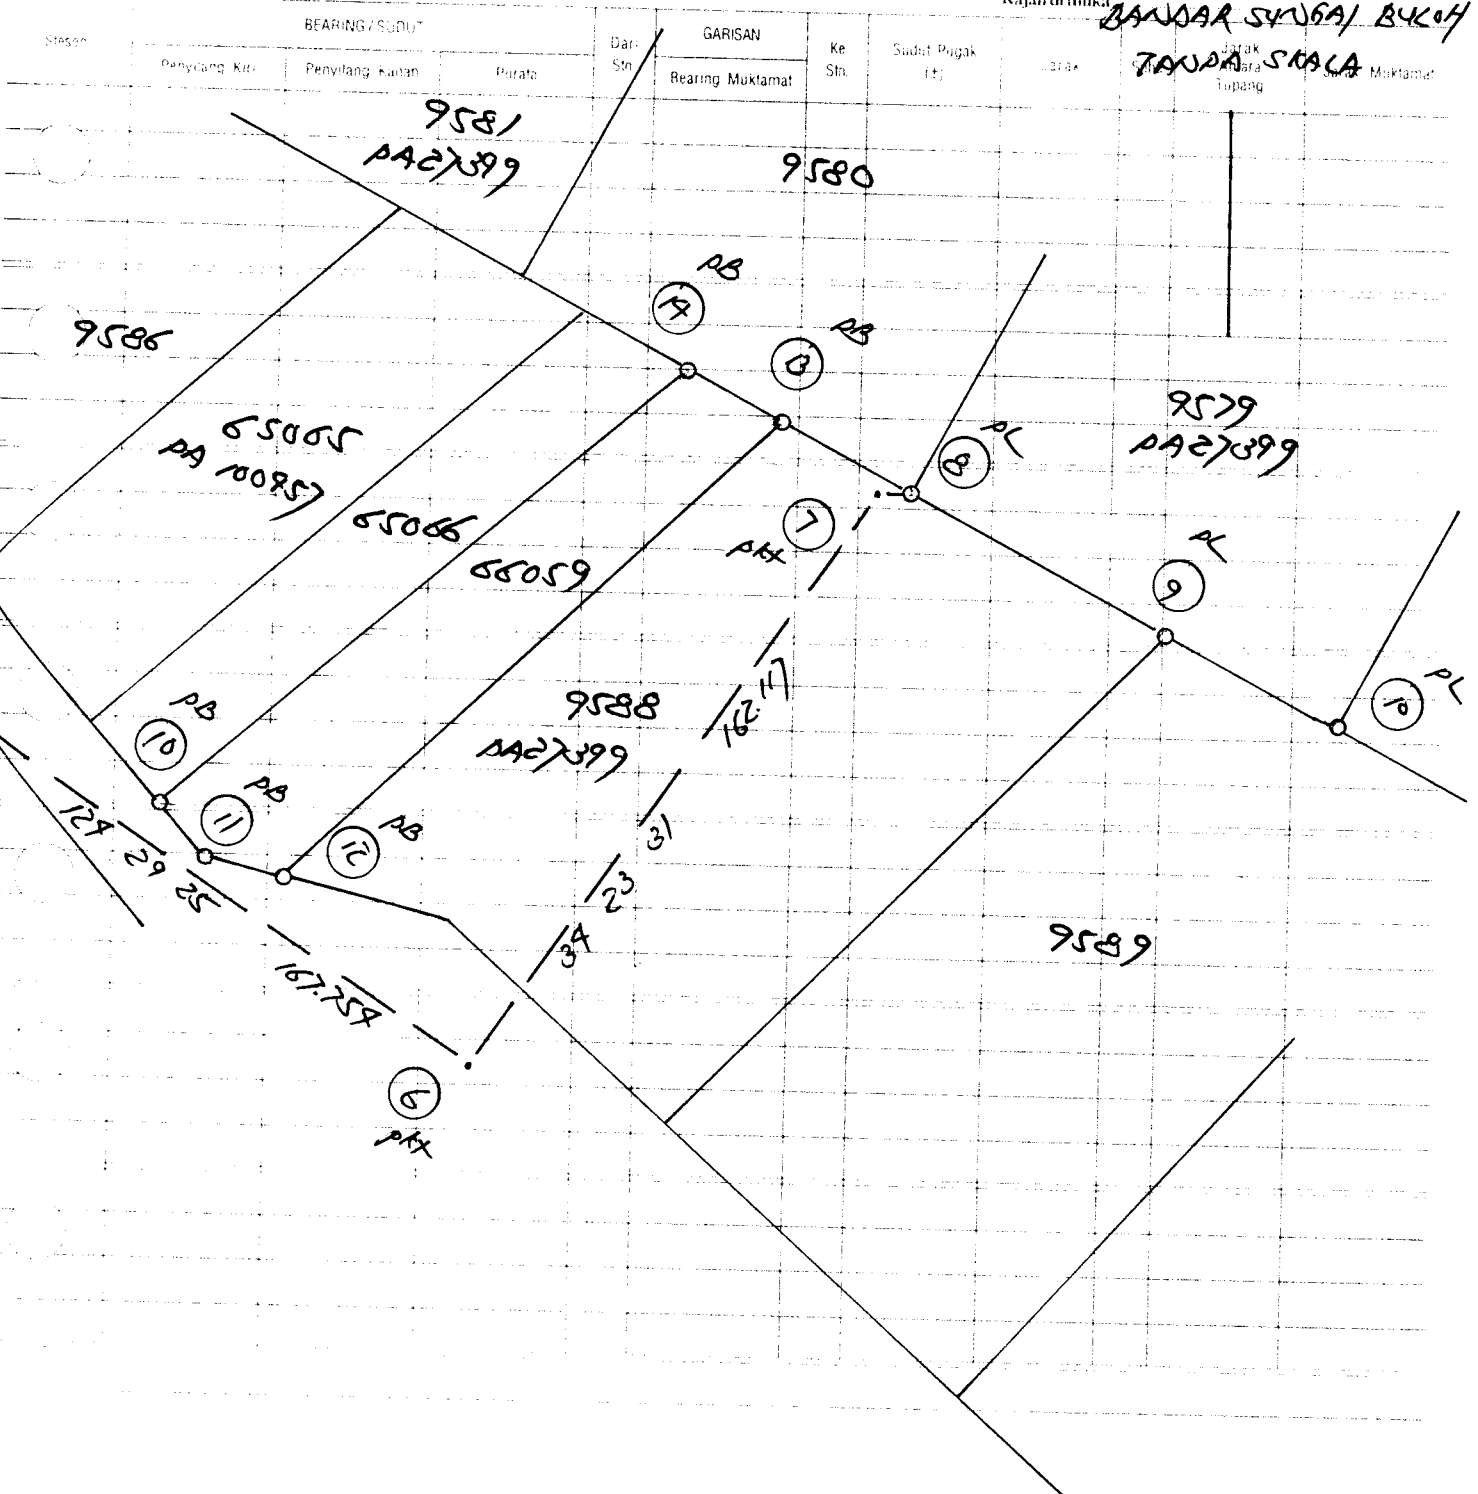

Tarikh *Dua Amay* Aras
 Daripada *785 0130*

Dibuat untuk
 Ke
 36

Pandangan Belakang	Pandangan Antara	Pandangan Hadapan	Naik	Turun	Aras Yang Dilaras	Jarak	Catitan
2.695	(18.68)				56.558 1426 78m 480	426 56.558	All the lights bored on BM 00055 RC 57.028
2.997 (19.83)		0.538	(1.77)				
3.289 (10.79)		0.586	(1.92)				
1.615 (15.30)		1.859	(6.14)				
1.085 (13.56)		1.179	(3.85)				
1.045 (13.33)		2.407	(7.90)				
1.576 (15.17)		1.572	(5.16)				
2.683 (18.80)		0.978	(3.21)				
3.168 (10.09)		0.151	(0.50)				
1.657 (15.99)		1.355	(4.95)				
21.730 /		0.606	(1.99)		67.062 F1009		
11.226							
1.79							
0.606 (1.99)					62.062 F1009		
0.163 (10.58)		2.503	(8.21)		65.165		
2.295 (17.53)		2.988	(8.16)		62.880		
	1.702	(15.58)			63.933 F1003		
	0.990	(3.25)			64.145 F1		
		2.696	(8.68)		62.969 - BM F1945		
3.069		7.637					

BM F1945 Nail on top of Sump-