


DAERAH KUALA SELANGOR
MUKIM HAJUNG. PERMATANG.
TANPA SKALA

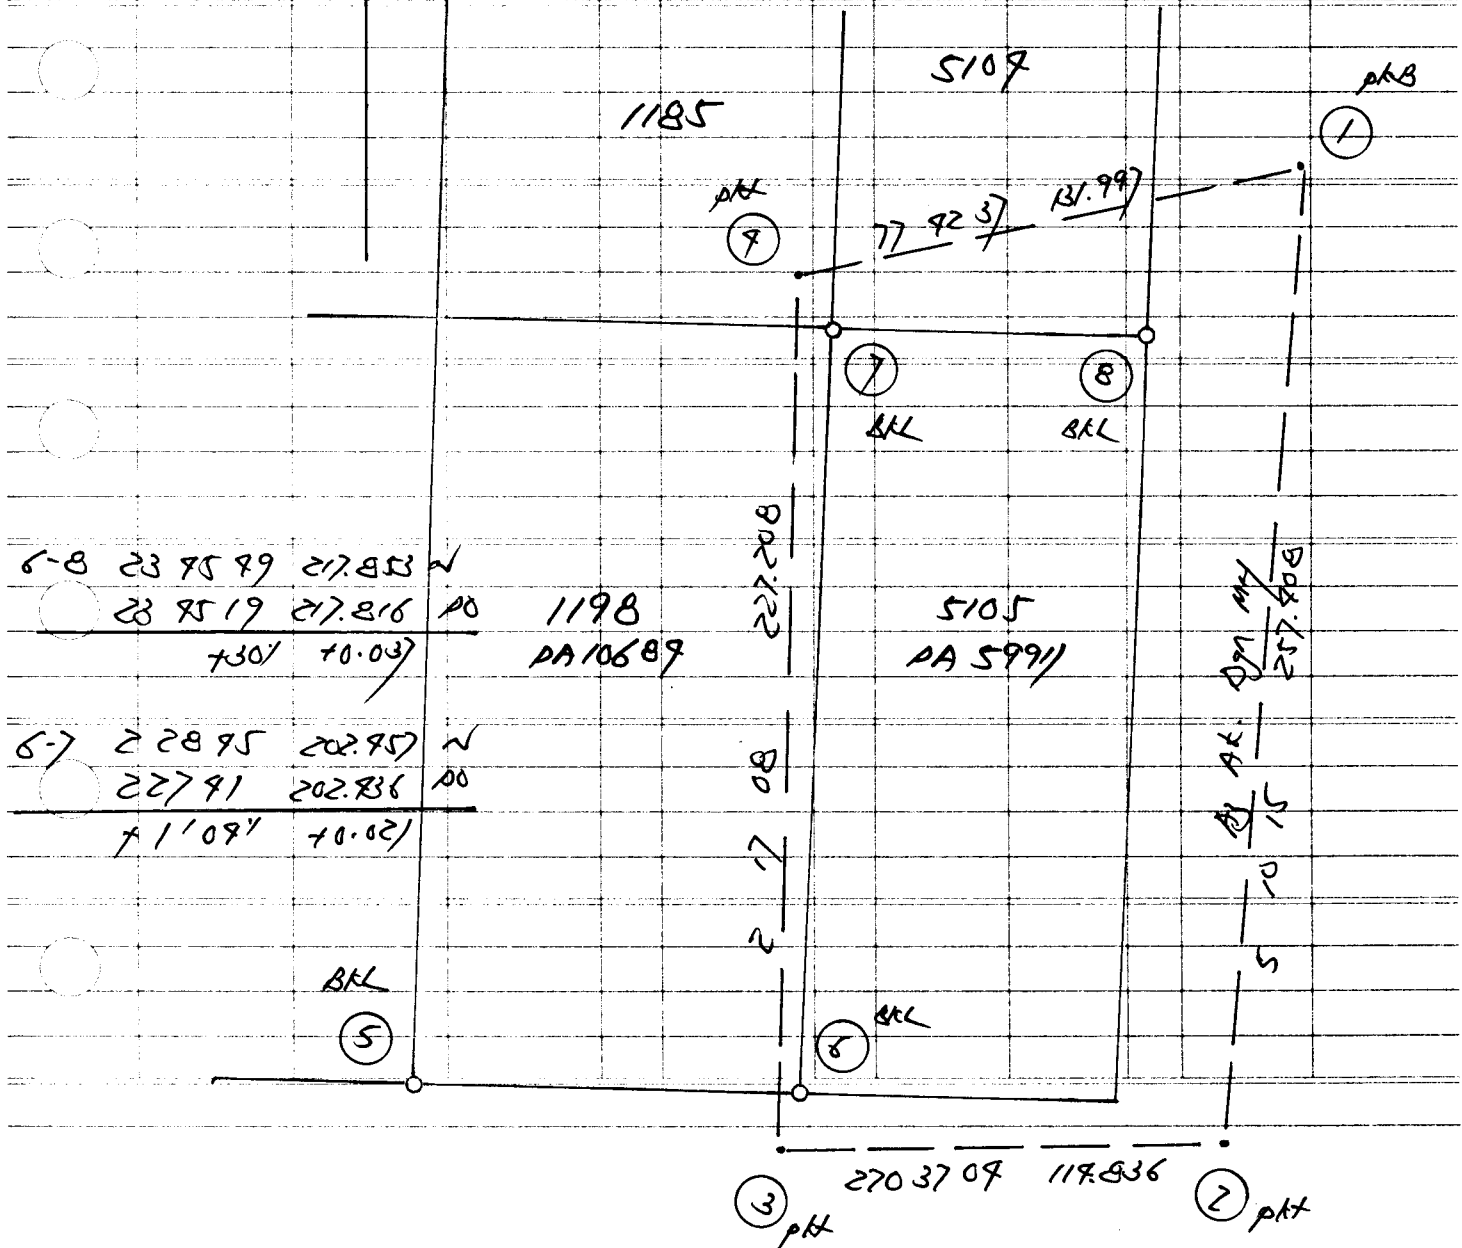


Tarikh *7 May* Aras

Dibuat untuk

Daripada *0725 81945*

Ke

Pandangan Belakang	Pandangan Antara	Pandangan Hadapan	Naik	Turun	Aras Yang Dilaras	Jarak	Catitan
<i>1.868</i>	<i>(6.13)</i>				<i>3.692</i>	<i>BM 88266</i>	<i>bandar / tepi S/S dari sen titimay</i>
<i>1.550</i>	<i>(5.09)</i>	<i>1.795</i>	<i>(12.91)</i>				
<i>1.750</i>	<i>(4.78)</i>	<i>1.783</i>	<i>(12.87)</i>				
		<i>1.796</i>					
<i>1.502</i>	<i>(12.83)</i>	<i>1.765</i>	<i>(12.81)</i>				
<i>1.523</i>	<i>(5.00)</i>	<i>1.333</i>	<i>(12.35)</i>				
<i>1.550</i>	<i>(5.09)</i>	<i>1.792</i>					
<i>1.790</i>	<i>(4.72)</i>	<i>1.523</i>	<i>(12.99)</i>				
<i>1.517</i>	<i>(12.98)</i>	<i>1.535</i>	<i>(5.08)</i>				
<i>1.717</i>	<i>(12.65)</i>	<i>1.783</i>	<i>(12.86)</i>				
<i>1.279</i>	<i>(12.10)</i>	<i>1.590</i>	<i>(5.22)</i>				
<i>1.823</i>	<i>(5.98)</i>	<i>1.785</i>	<i>(12.87)</i>				
		<i>0.727</i>	<i>(3.09)</i>				
<i>15.366</i>		<i>12.319</i>				<i>78M 82149</i>	<i>Aras Colvert.</i>
<i>0.653</i>	<i>(2.12)</i>						
<i>1.488</i>		<i>1.280</i>	<i>(12.20)</i>			<i>78M 82149</i>	
<i>1.388</i>	<i>(12.56)</i>						
<i>1.229</i>	<i>(12.03)</i>	<i>1.750</i>	<i>(12.76)</i>				
		<i>1.792</i>	<i>(12.73)</i>			<i>9A</i>	
<i>3.270</i>		<i>4.172</i>					

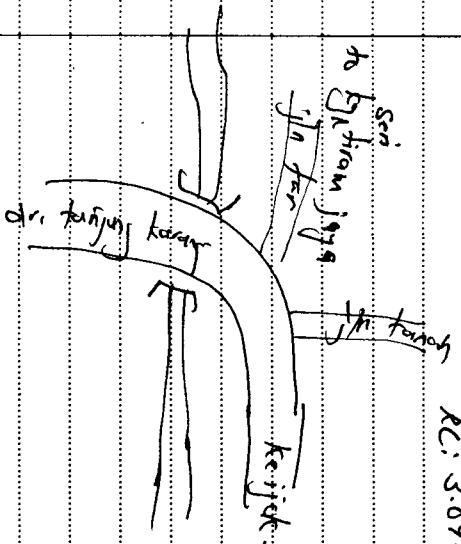

Tarikh Aras

Dibuat untuk

34

Daripada

Ke

Pandangan Belakang	Pandangan Antara	Pandangan Hadapan	Naik	Turun	Aras Yang Dilaras	Jarak	Calitan
1/363	(1997)				3.837	PA	
1/932	(1970)	1.500	(1992)				
1/917	(1965)	1.806	(1961)				
9212'		1.953	(1977)		3.690	F1	
		9359'					
1/965	(1989)				3.690	F1	F2/5/ Ahs Dly
1/966	(1989)	1.268	(1915)		3.891	A3	
	1.597	1.529			3.760	78m F8/50 Ahs Calicut	
		2.084	(1689)		3.273	F2	
2981		3.348					