

No. Fail

JRS 82036 Kemensah Heights Lot 13235

Rajah di muka

Stesen	BEARING - SUDUT			Dari Stn	GARISAN		Ke Stn	Sudut Pukak (°)	Jarak	Sudut Antara Stesen	Jarak Muktamat
	Penyilang Kiri	Penyilang Kanan	Purata		Bearing Muktamat						
	Datum	Daripada		2	278 1953	1	4	75.789			75.789
				pk.B		pk.B					
1	278 1953	98 1953	171 5138	2	171 5138	3	4	87.108			87.108
2											
3	171 5138	351 5138									
				pk.B							
1-4	21 2959			1	21 2959	7	4	71.109			71.109
1-5	27 5931			1	27 5931	5	4	73.377			73.377
1-6	39 2158			1	39 2158	6	4	8.609			8.609
1-7	76 2502			1	76 2502	7	4	8.279			8.279
1-8	108 3879			1	108 3879	8	4	30.399			30.399
2-9	359 9105			2	359 9105	9	4	38.803			38.803
2-10	6 3809			2	6 3809	10	4	87.715			87.715
2-11	1028 93			2	1028 93	11	4	92.606			92.606
2	351 5138	171 5138	271 9232	3	271 9232	12	4	67.675			67.675
3											
12	271 9232	91 9232									
				pk.T							
3-13	295 2398			3	295 2398	13	4	11.898	BKL		11.898
3-19	206 1358			3	206 1358	19	4	25.926	BKL		25.926
12-15	72 1555			12	72 1555	15	4	3.337	BKL		3.337
12-16	172 9600			12	172 9600	16	4	27.796	BKL		27.796

No. Fail

BEARING / SUDUT

GARISAN

Stesen

Penyilang

Penyilang Kanan

Purata

Dar

Stn

Bearing Mukamat

Ke

Stn

Sudut

Rajah

Rajah di muka

Jarak

Suhu

Jarak


Antara

Pupang

Jarak

Muktamat

DAERAH PETALING.
MUKIM BUKIT RAJA
TAJAPA SKACA

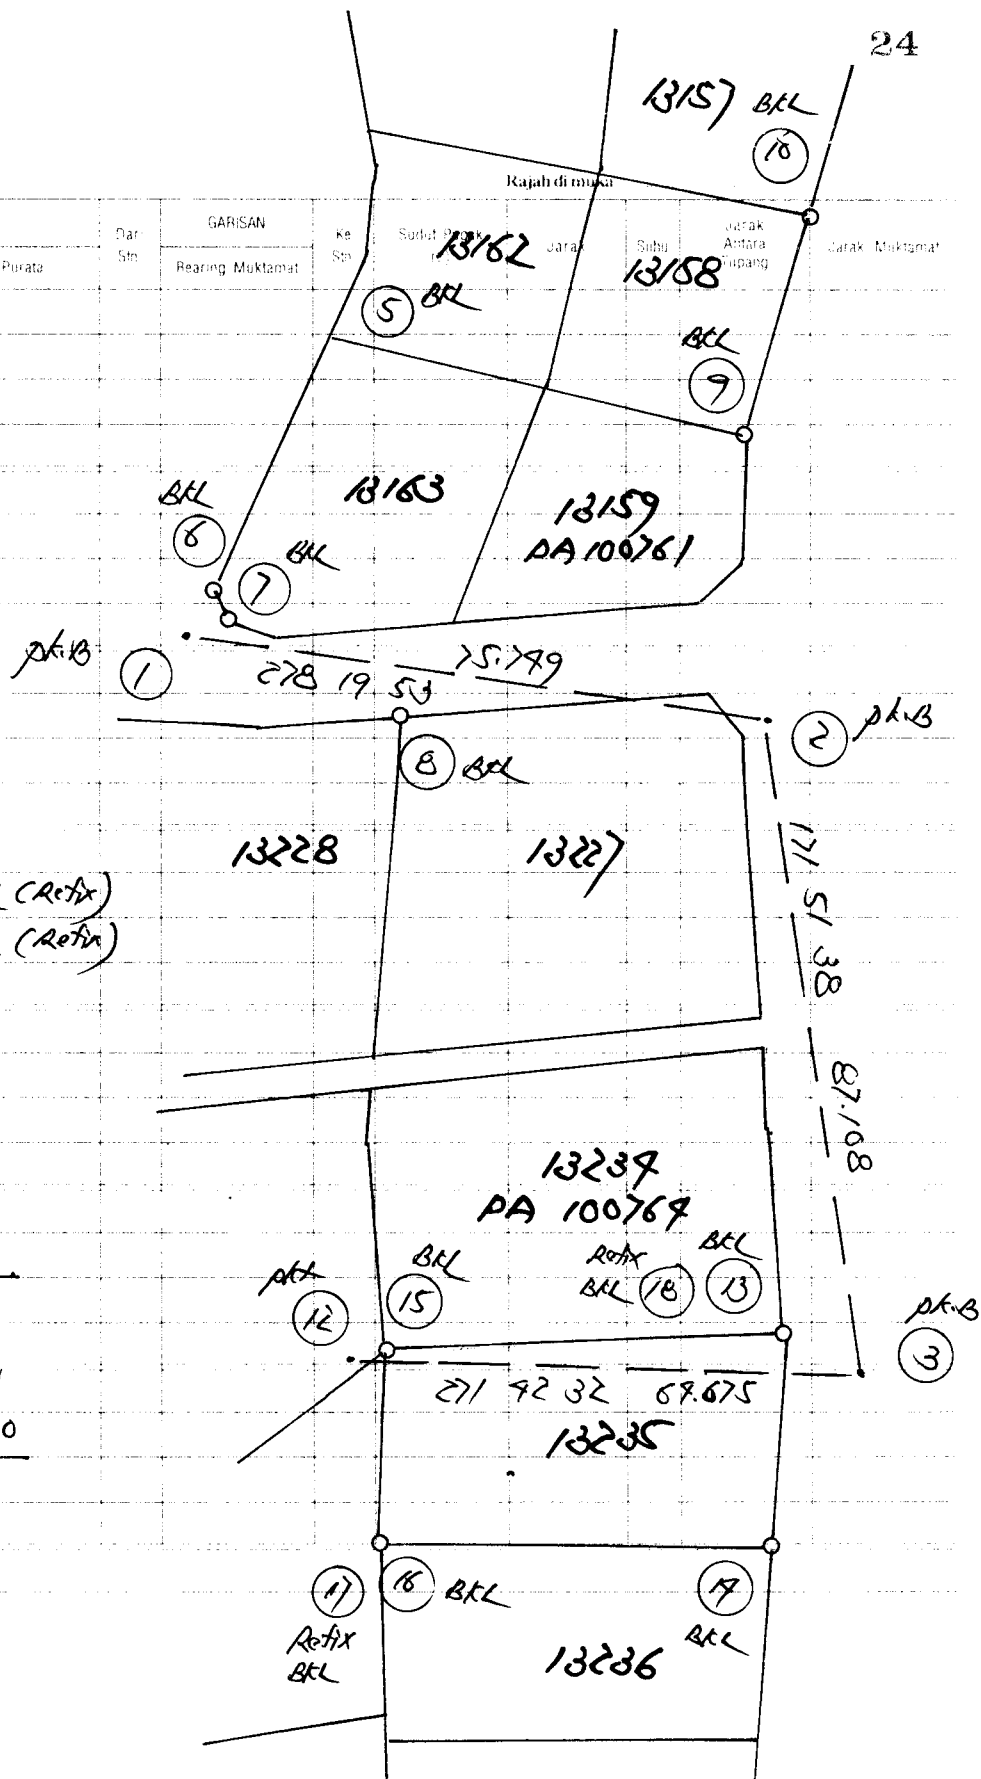

Tarikh *Kyong High*

Aras

Dibuat untuk

Daripada

TRJ 82036

Ke

Pandangan Belakang	Pandangan Antara	Pandangan Hadapan	Naik	Turun	Aras Yang Dilaras	Jarak	Catitan
1.384	(12.58)	(12.56)			29.879	TRM 12214 (F1001) / F23	
	1.390	(12.59)			29.873	TRM 12215	
	0.729	(12.59)			30.534	TRM 12216 Ats Hyland	
1.738	(15.78)	1.904	(14.61)		29.859		
2.913	(17.92)	0.227	(10.75)		31.370	F50	
		0.208	(10.68)		33.575	TRM 48	RL: 33.575
5.535		1.839					M/S 37

*All the height based on
BM 130298*