


1-4 129 1735 80.975 ✓
129 1850 80.503 10
+95" -0.028

JAGRAY SEPANG.
MUKIM BENGKIL
1010
TANPA SKALA

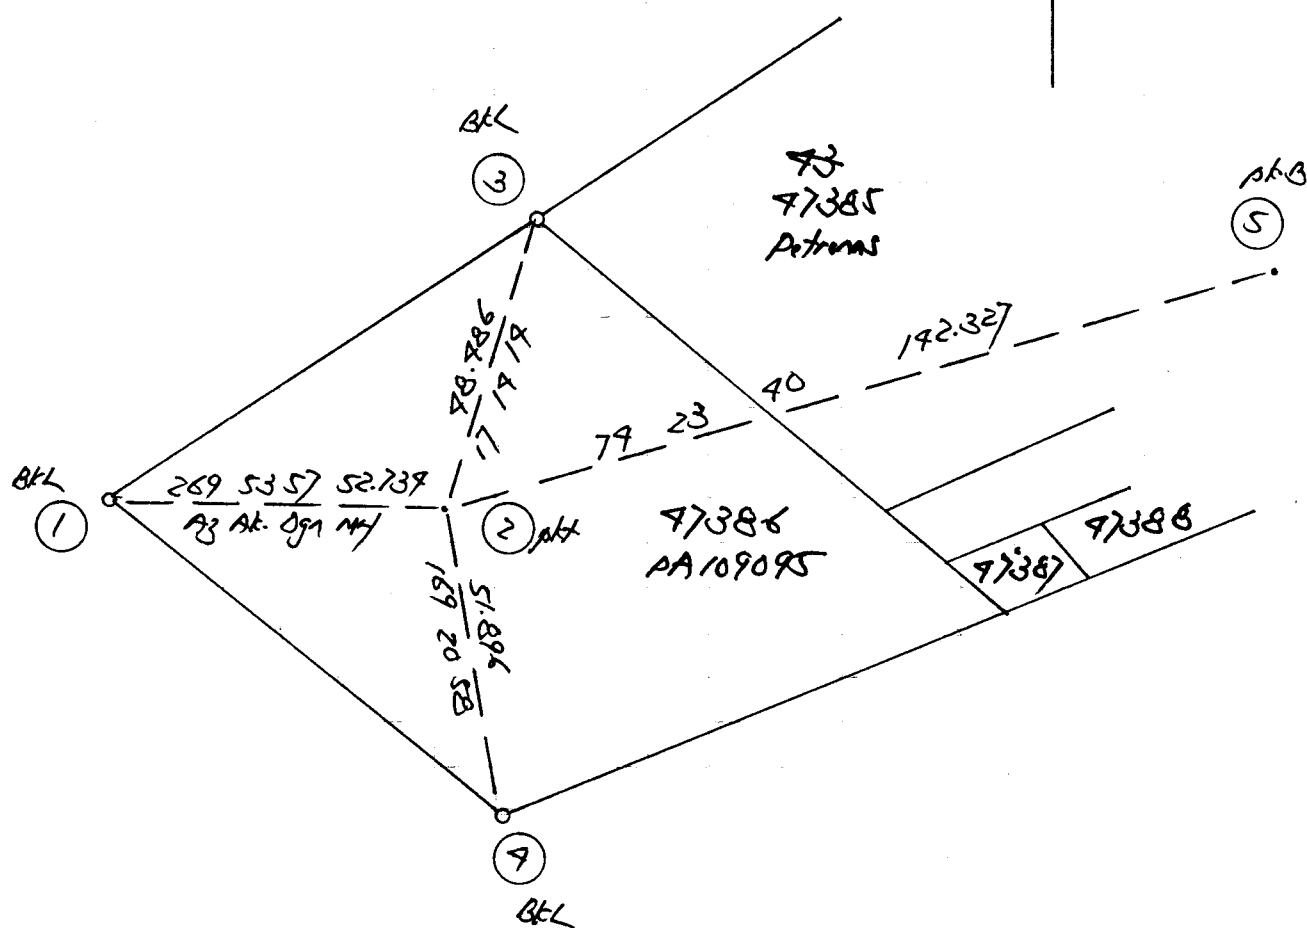

No. Fail JRS 80986-1 Petronas SKUE.

Rajah di muka

Stesen	BEARING / SUDUT			Dari Stn.	GARISAN		Ke Stn.	Sudut Pugak (±)	Jarak	Suhu	Jarak Antara Tugu	Jarak Muktamat
	Penyilang Kiri	Penyilang Kanan	Purata		Bearing Muktamat							
○	Datum	Danipadu		5	229 3506	6	4	61.822				61.822
	PA 126	M/S 13		sh		62						
				lanc		lanc						
6	229 3506	79 3506	259 1725	5	259 1725	50	4	192.116				192.116
5	50	259 1725	79 1725									
	pk.											
6	Seperti Di Atas	223 0906	5	223 0906	51	4	80.985					80.985
5	51	223 0906	73 0906									
	pk											
51-52	71 5133	10.928	PA	}	Annotate on 25/10/2019							
51-53	3 2008	11.368	PA									
51-54	333 5033	22.096	PA									
50-55	16 98 75	78.732	BIL (Rata)									
50-56	270 06 73	53.090	BIL (Rata)									
50-57	169 3629	51.557	PA									
6	229 3506	79 3506	239 1552	5	239 1552	60	4	117.939				117.939
5	60	239 1552	59 1552									
	pk											
50-61	336 5530	50.525	HWP (BH1)	}	Bore hole peg on 26/10/2019							
50-62	29 1918	15.738	HWP (BH2)									
50-63	311 2275	25.099	HWP (BH3)									
50-64	291 1354	53.395	HWP (BH4)									
50-65	273 49 28	27.760	HWP (BH5)									
50-66	261 3173	73.149	HWP (BH6)									

Amarrate on 25/10/2019

Rata hok peg on 25/10/2019