

JRS 80762 Jinjang. Rumah Setinggal

Rajah di muka

Stesen	BEARING / SUDUT		Purata	GARISAN		Ke Stn.	Sudut Pukak (±)	Jarak	Suhu	Jarak Antara Tupang	Jarak Mukamat
	Penyilang Kiri	Penyilang Kanan		Dari Stn.	Bearing Mukamat						
	Datun Daripada	273 08 98	2	273 06 98	1	11	33.792	33.792			
	PA 102733	M- 2 ^a pt.B		pt.L							
1	273 08 98	93 08 98	279 11 41	2	273 09 91	3	4	9.953	9.953		
2		M- 2									
3	279 11 41	99 11 41									
	pt.L ←										
1	Seperti Di Atas	317 21 95	2	317 19 95	4	4	13.309	13.309			
2		M- 2									
4	317 21 95	137 21 95									
	pt.L ←										
1	Seperti Di Atas	337 17 37	2	337 15 37	5	4	20.051	20.051			
2		M- 2									
5	337 17 37	157 17 37									
	pt.L ←										
1	Seperti Di Atas	273 23 35	2	273 21 35	6	4	7.510	7.510			
2		M- 2									
6	273 23 35	93 23 35									
	pt.L 42										
1	Seperti Di Atas	265 59 07	2	265 57 07	7	4	75.025	75.025			
2		M- 2					75.027				
7	265 59 07	85 59 07									
	pt.B										
1	Seperti Di Atas	181 57 09	2	181 55 09	8	4	78.232	78.232			
2		M- 2									
8	181 57 09	157 09									
	pt.L (F.B.195)										



No. Fail

Rajah di muka

No. Fail

Rajah di muka

Stesen	BEARING / SUDUT		Dari Stn.	GARISAN Bearing Mukamat	Ke Stn.	Sudut Pugak (±)	Jarak	Suhu	Jarak Antara Tupang	Jarak Mukamat
	Penyilang Kiri	Penyilang Kanan								

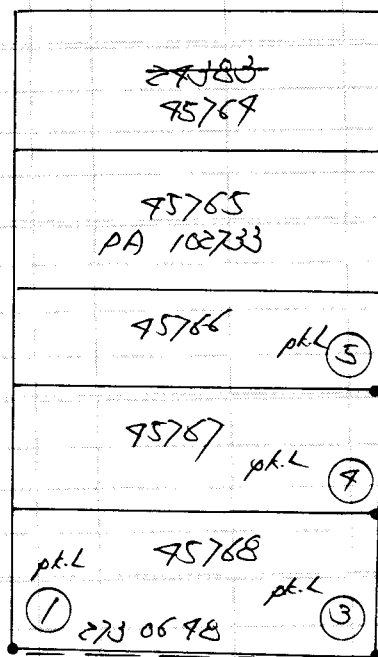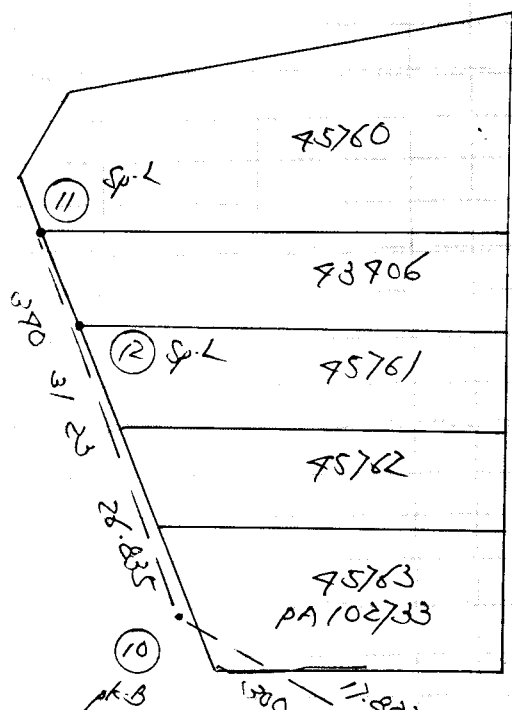

NYLAI/ PERSEKUTUAN
MYKIM BAYU
0359
TANDA STAKA

11-5 102 15 56 61.900 N
102 15 45 61.927 PD
+11" -0.027

11-1 129 36 29 76.082 N
129 36 32 76.087 PD
-3" -0.002

11-5 102 15 56 61.900 N
102 15 45 61.927 PD
+11" -0.027

11-1 129 36 29 76.082 N
129 36 32 76.087 PD
-3" -0.002

11-5 102 15 56 61.900 N
102 15 45 61.927 PD
+11" -0.027

11-1 129 36 29 76.082 N
129 36 32 76.087 PD
-3" -0.002

Tarikh *Tanjung Selat* Aras

Dibuat untuk

Daripada *GRS*

Ke

Pandangan Belakang	Pandangan Antara	Pandangan Hadapan	Naik	Turun	Aras Yang Dilaras	Jarak	Catitan
1. 975	(9.88)				95.505	<i>F9</i>	
1. 992	(9.89)	1.539	(0.505)		95.991	<i>F8</i>	
1. 925	(9.82)	1.188	(3.90)		95.795	<i>F2</i>	
	1.908	(9.62)			95.782	<i>H2 / BM L1368 (Atas H2, x ada penyung)</i>	
1.323	(9.39)	1.762	(5.78)		95.908	<i>F7</i>	
		1.183	(3.88)		95.598	<i>F10</i>	
1.038	(9.91)				96.952	<i>BM put W19558 RL: 96.952m</i>	
1.815	(5.96)	1.285	(9.22)				<i>BM W0178 RL: 92.065</i>
1.811	(5.28)	1.379	(9.51)				
2.019	(6.61)	1.810	(5.28)				
	1.673	(5.99)					<i>BM L1361' naif di bawah SKR dan Airman, Tanjung.</i>
0.508	(1.66)	1.788	(5.80)				
		2.156	(7.02)			<i>F2</i>	
6.986		8.193			95.795		