

Gyda Torga (Bkt Baja)

JRS 805/2

Willard

Kajato de moka

[illegible]

5 51/1837 23/1837 278 0905 107 278 0905 186 H 6.150 6.150

107
106 278 0905 98 0905

BAL

5 Sept Di Atas 188 5301 107 188 5301 107 H 11.701 11.701

107
107 188 5301 8 5301

PL

5 Sept Di Atas 150 2758 107 150 2758 108 H 27.681 27.681

107
108 150 2758 330 2758


ptt

5 Sept Di Atas 353 1050 107 353 1050 109 H 72.880 72.880

107
109 353 1050 173 1050

BAL

No. Fail			Raporan akhir		
BEARING / SUDUT			Nilai	Nilai	Nilai
Penyilang Kiri	Penyilang Kanan	Pusat	Nilai	Nilai	Nilai
			Nilai	Nilai	Nilai

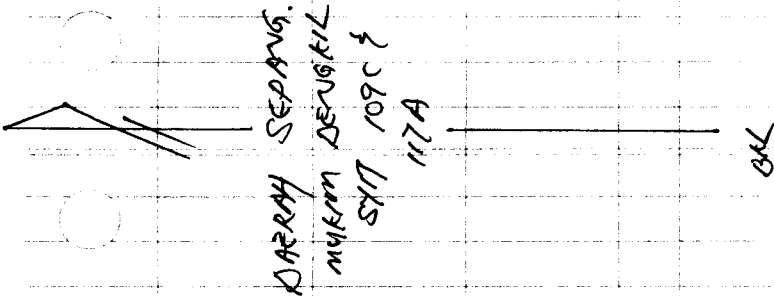


Demarcation.

109-A	1873335	33.900	AB
109-B	1615906	29.990	AB
109-C	1559002	16.579	AB
109-D	1197301	17.888	AB
108-E	1251919	58.706	AB
108-F	1500226	58.323	AB
108-G	1571808	60.366	AB

7-109 220 03 96 169.783 ✓
220 03 99 169.785 00
72' -0.002

7-3	9/0123	59.297	N
	9/0227	59.288	PO
	-18'	70.009	

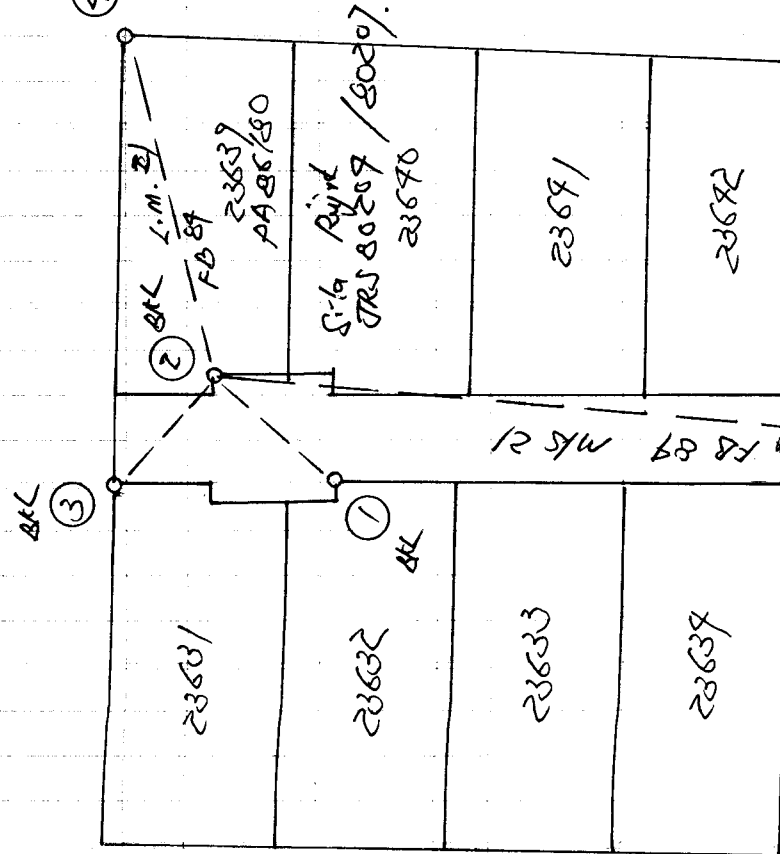

No. Lari

Rajah di muka

BEARING SURVEY

JARISAN

No. Spt

Jarak Dugaan

Jarak

Jarak

Amortisation.

107-A	127	53	18	33.797	(PB)
107-B	162	17	08	27.768	(PB)
107-C	155	57	33	16.391	(PB)
107-D	119	25	33	17.657	(PB)
108-E	128	11	37	58.963	(PB)
108-F	150	05	59	58.023	(PB)
108-G	157	23	16	60.136	(PB)

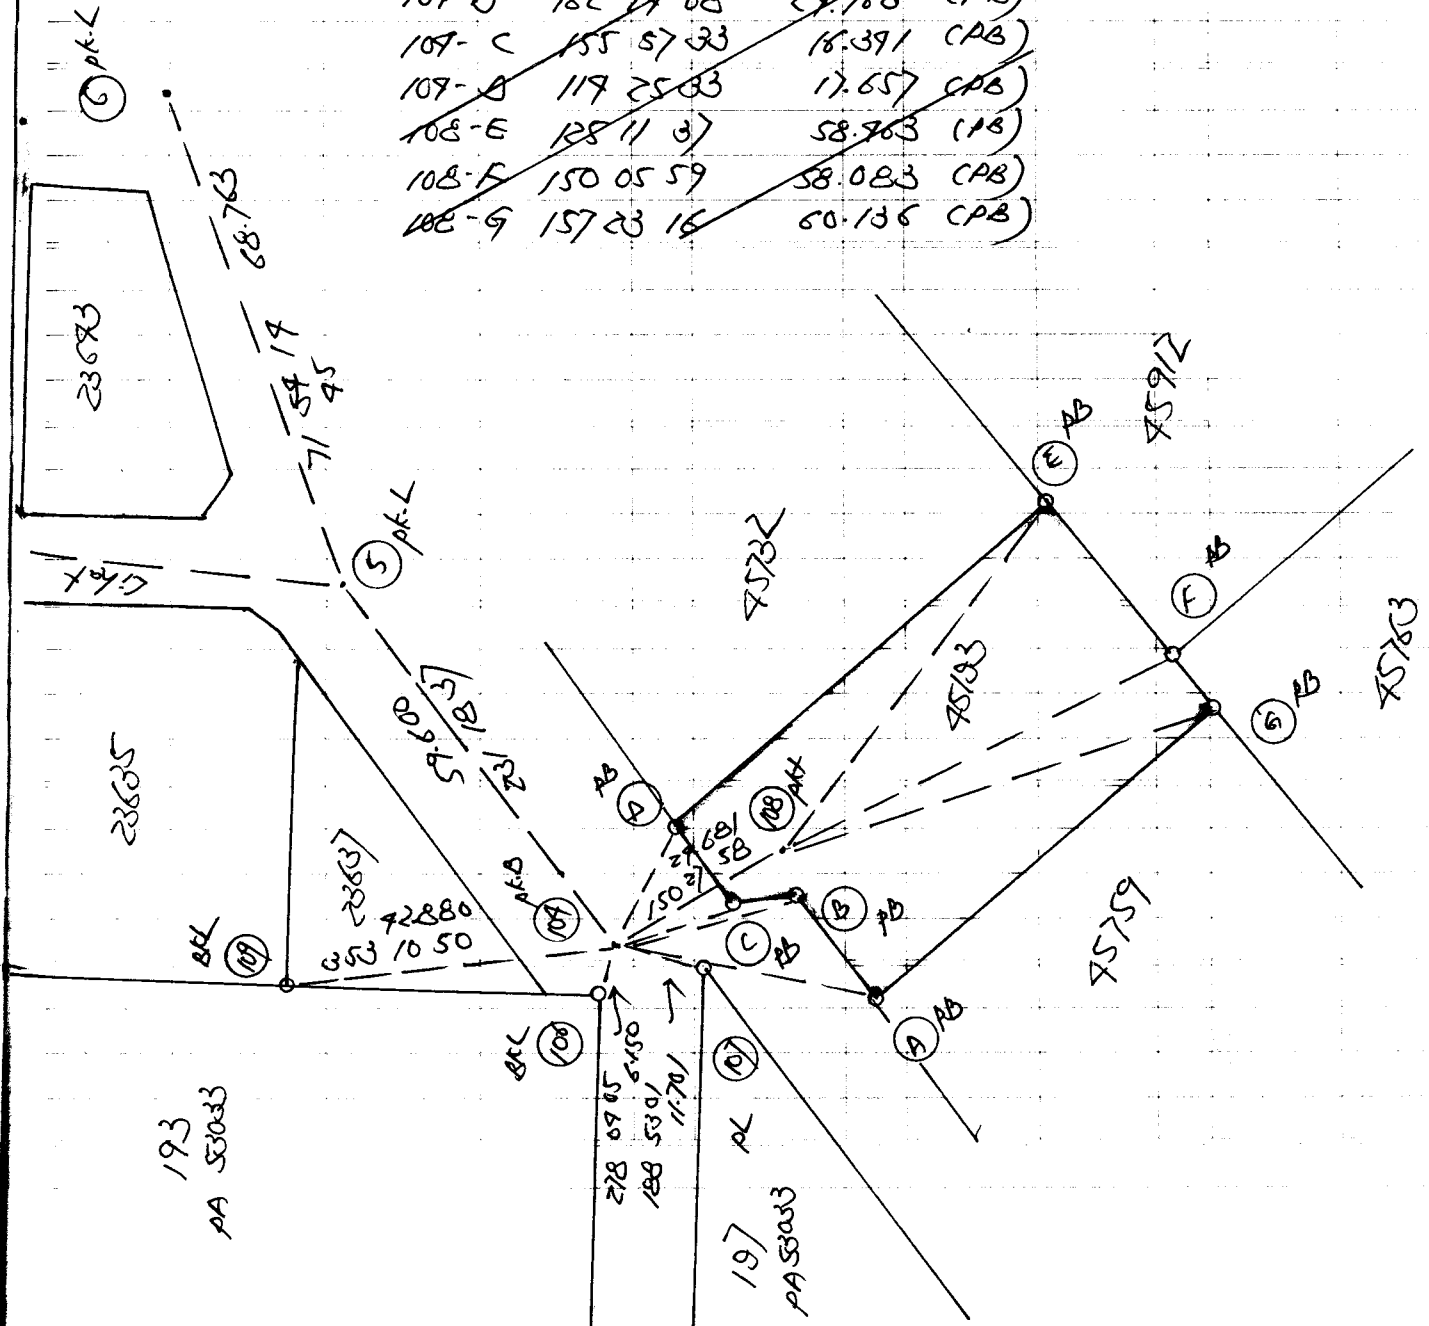

CERAPAN MATAHARI BAGI AZIMUT

Pengantar Hari Tarikh Bulan Tahun

Penilik: JRS80512 Bkt Baja Tarikh: 24/06/2008

Stn. 5 Koordinat: S31688 B7853 Selangor

T.R. 6 B.K.FB112 Ms.13

Tiodolit Satu bah. aras ufuk:

Waktu	Sasaran	Ufuk	Gelembong	Puguk		
	T.R.	71 45 15				
7 58	M.H.	66 59 00		79 38 21	Waktu purata	7 58 30
7 58	M.H.	66 26 48		79 32 26	Beza dari U.T. -	8 00 00
7 59	M.H.	246 26 27		280 35 35	U.T.	23 58 30
7 59	M.H.	246 58 24		280 39 34	Deklinasi	23 24 33
	T.R.	251 45 25				
	T.R.	71 45 15				
8 00	M.H.	66 58 27		79 14 01	Waktu purata	8 00 30
8 00	M.H.	66 26 10		79 09 06	Beza dari U.T. -	8 00 00
8 01	M.H.	246 25 55		280 57 41	U.T.	0 00 30
8 01	M.H.	246 57 50		281 02 38	Deklinasi	23 24 33
	T.R.	251 45 25				

	Set 1	Set 2
Sudut pugak	10 31 05	10 54 18
Pembetulan	- 0 04 29	- 0 04 20
Altitud	10 26 36	10 49 58
Jarak kutub	66 35 27	66 35 27
Latitud	2 53 15	2 53 15
Azimut M.H. yang dikira	66 43 17	66 42 40
Purata ke M.H.	66 42 40	66 42 05
Selisih:	0 00 37	0 00 35
Purata ke T.R.	71 45 20	71 45 20
Azimuth T.R. sebenar	71 45 57	71 45 55
Pembetulan aras	+ 0 00 00	+ 0 00 00
Tirusan	- 0 00 23	- 0 00 23
Bering grid T.R.	71 45 34	71 45 32

Purata bering grid T.R.	71 45 33
-------------------------	----------

Kategori		Kategori		Kategori	
Penyakit	Penyakit Kim	IR	Tanda Raga	WU	Waktu dan
Penyakit	Penyakit Kim	Sei	Sei	A 7 K	Waktu dan