


JRS 80547 Jln Pakang
~~80535 Pakang (Paco) T.Hk.~~

29/8/08

Detm Danpada 3833528 > 3973231 / 4 182250
 PA MT 57'03"

1 3833528 1633528 3585225 > 3599028 3 4 75.335 75.335
 2 MT 57'03"
 3 3585225 1785225
 Sp.L
 1 Separasi Di Atas 3585658 > 3595901 9 4 67.220 67.220
 2 MT 57'03"
 7 3585658 1785658
 pk.B
 1 Separasi Di Atas 877879 > 857552 5 4 36.909 36.909
 2 MT 57'03"
 5 877879 2877879
 B.L
 1 Separasi Di Atas 857778 > 867951 8 4 68.661 68.661
 2 MT 57'03"
 6 857778 2857778
 pk.L
 1 Separasi Di Atas 3907712 > 3917915 7 4 125.798 125.798
 2 MT 57'03"
 7 3907712 1607712
 Sp.L
 2 1785658 3585658 1173129 7 1182827 8 4 72.998 72.998
 9 MT 57'03"
 8 1173129 2973129
 pk.L ←


2	1633528 3833528	1655556	1	1665259	10	4	38.020	38.020
		MT 57'03"		Ag Ak.				
10	1655556 3855556			Ag 111				
2	Septis Di Akis	2881129	1	2890827	11	4	131.209	131.209
		MT 57'03"						
11	2881129 881129							
	pk.B							
1	881129 2881129	3317911	11	3329119	12	4	91.555	91.555
		MT 57'03"						
12	3317911 1517911							
	pk.LC							

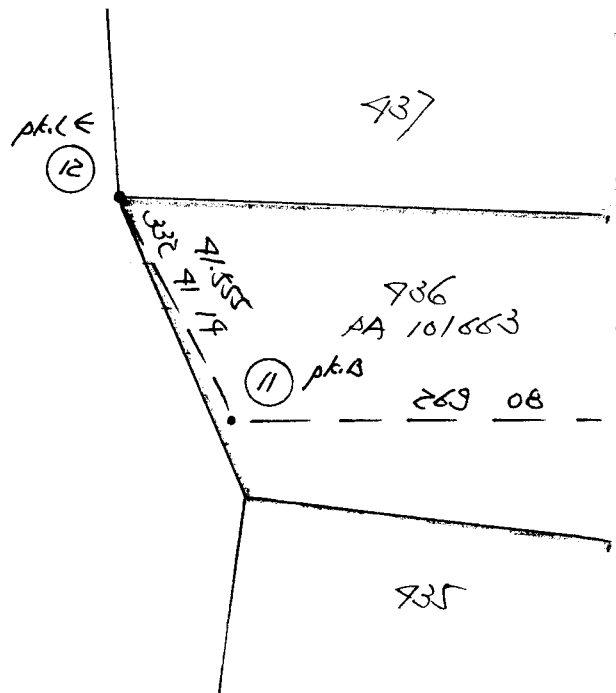

3-12	309 95 13	258.952~
	309 99 33	258.922 PO
	<u>70"</u>	<u>70.030</u>

5-12	311 25 07	319.238~
	311 25 05	319.216 PO
	<u>2'</u>	<u>70.022</u>

BAUKAR KUALA LUMPUR
SEKSYEN BS
TANDA SKALA

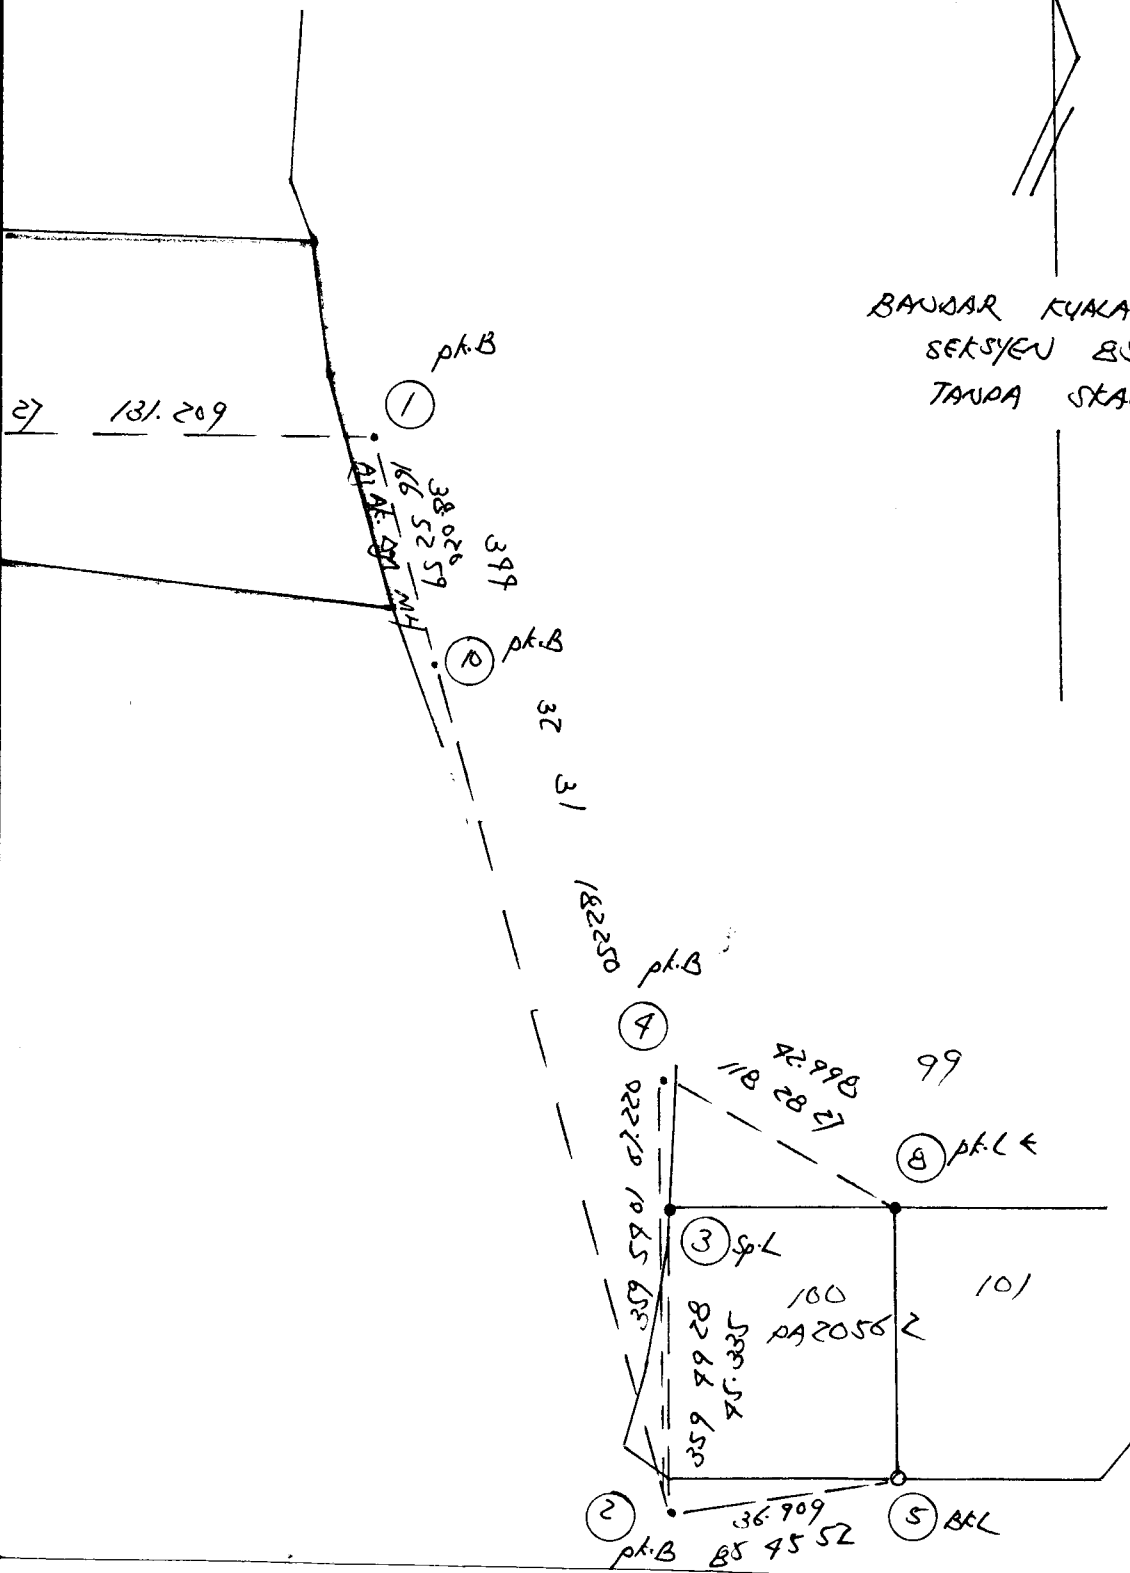

Penilik: JRS80547 Jln Pahang Tarikh: 29/08/2008
 Stn. 1 Koordinat: U1127.574 B84.825 W.P. Kuala Lumpur
 T.R. 10 B.K. Ms.
 Tiodolit Satu bah. aras ufuk:

Waktu	Sasaran	Ufuk	Gelembong	Puguk		
	T.R.	0 0 0				
9 40	M.H.	274 16 35		53 51 21	Waktu purata	9 40 30
9 40	M.H.	273 36 58		53 46 24	Beza dari U.T. -	8 00 00
9 41	M.H.	93 36 09		306 20 14	U.T.	1 40 30
9 41	M.H.	94 15 12		306 24 31	Deklinasi	9 16 31
	T.R.	180 0 20				
	T.R.	0 0 0				
9 42	M.H.	274 15 22		53 28 12	Waktu purata	9 42 30
9 42	M.H.	273 35 32		53 23 10	Beza dari U.T. -	8 00 00
9 43	M.H.	93 34 37		306 42 40	U.T.	1 42 30
9 43	M.H.	94 13 53		306 47 28	Deklinasi	9 16 29
	T.R.	180 0 20				

	Set 1	Set 2
Sudut pugak	36 16 45	36 39 41
Pembetulan	- 0 01 04	- 0 01 03
Altitud	36 15 41	36 38 38
Jarak kutub	80 43 29	80 43 31
Latitud	3 11 04	3 11 04
Azimut M.H. yang dikira	80 49 43	80 48 18
Purata ke M.H.	273 56 14	273 54 51
Selisih:	-193 06 31	-193 06 33
Purata ke T.R.	0 00 10	0 00 10
Azimuth T.R. sebenar	-193 06 21	-193 06 23
Pembetulan aras	+ 0 00 00	+ 0 00 00
Tirusan	- 0 00 39	- 0 00 39
Bering grid T.R.	-193 07 00	-193 07 02
Purata bering grid T.R.	- 193 07 01	

$$360 - 183^{\circ} 07' 01''$$

$$= 176^{\circ} 52' 59''$$

Tarikh 29/07/2017

Dibuat untuk

13

Daripada 0858057 9/98A

Ke

Pandangan Belakang	Pandangan Antara	Pandangan Hadapan	Naik	Turun	Aras Yang Dilaras	Jarak	Catitan
0.572 (1.88)					72.93	BM 00018	AC: 72.93/m
1.623 (5.32)	1.550 (5.09)				71.953		
1.876 (6.15)	1.862 (8.82)				72.27	A10	
	1.937 (8.77)				72.653	A1	
	1.285 (8.22)				72.805	BM 1/823 no1	
						di bawah jambas	
4.071		7.197					