


JRS 80583 Bander Enstrik Set Wall

		15		29/10/08			
	Datum Daripada	3353915	2	3353915	1	4	98.192
		AKL		AKL			98.192
1	3353915	1553915	1829715	2	1829715	3	4
2							113.283
3	1829715	29715					113.281
	pk. C (STN 2)						
2	29715	1829715	3993326	3	3993326	4	4
3							195.518
4	3993326	1693326					
	pk. E (STN 1)						
2	Septi Di Atas	921820	3	921823	5	4	81.379
3		ct 3					81.378
5	921820	2721820					
	pk. B						
3	2721820	921820	730691	5	730696	6	4
5			ct 5				192.691
6	730691	2730691					192.692
	pk. B						
5	2730691	730691	663122	6	663130	7	4
6			ct 8				196.850
7	663122	2963122					196.852
	pk. B						
6	2963122	663122	810991	7	810999	8	4
7			M-1 8				169.861
8	810991	2610991					169.861
	pk. B						


6	2963122	663122	379929	7	379939	9	4	96.599	96.599
7			4	10				96.599	
9	379929	2179929							
	pht								
7	2179929	379929	2939109	9	2939122	10	4	220.272	220.272
9			4	13				220.273	
10	2939109	639109							
	pht								
9	639109	2939109	2512293	10	2512258	11	4	185.985	185.985
10			4	15				185.983	
11	2512293	712293							
	pht								
10	712293	2512293	2983525	11	2983593	13	4	61.208	61.208
11	25		4	18				61.206	
13	2983593	683525							
11	683525	2983525	3993306	13	3993326	9		Sila	Light m/s at R.3
13			4	20					
9	3993306	3993306							

Bring 3-9 Dibara 3993306
 Spatula Dibara 3993326
 Tikaian -20" wtk 8 sty 2.5 per stn.
 Ambetulan +25 per stn.

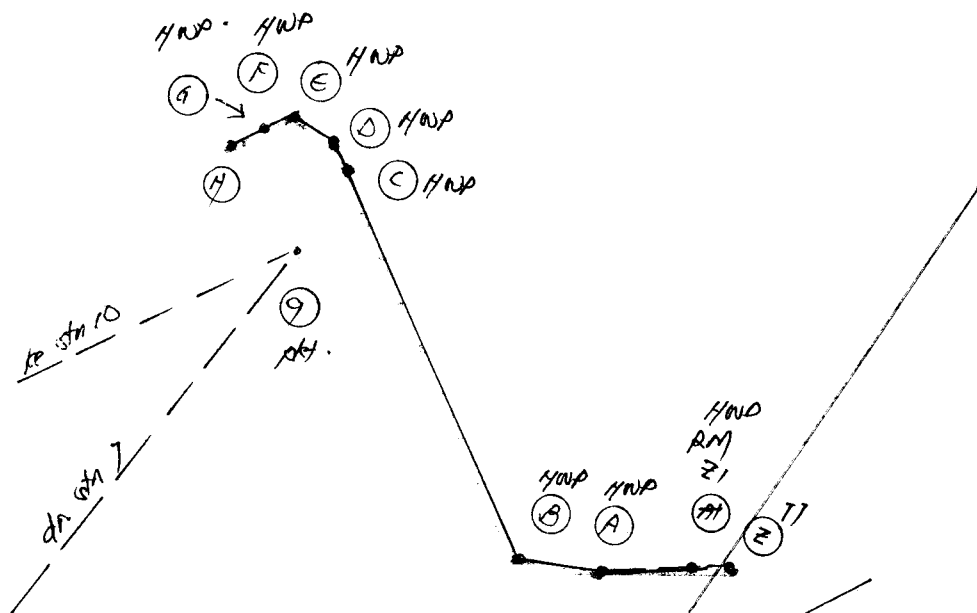

Setting out.

9-A	135 58 00	28.299	HWP
9-B	172 28 73	29.358	HWP
9-C	37 10 00	6.082	HWP
9-D	17 30 40	7.176	HWP
9-E	1 26 59	7.897	HWP
9-F	395 59 36	8.290	HWP
9-G	330 29 35	8.280	HWP
9-Z	123 21 39	35.737	7T
9-Z1	123 51 01	35.370	HWP (offset 0.5m)

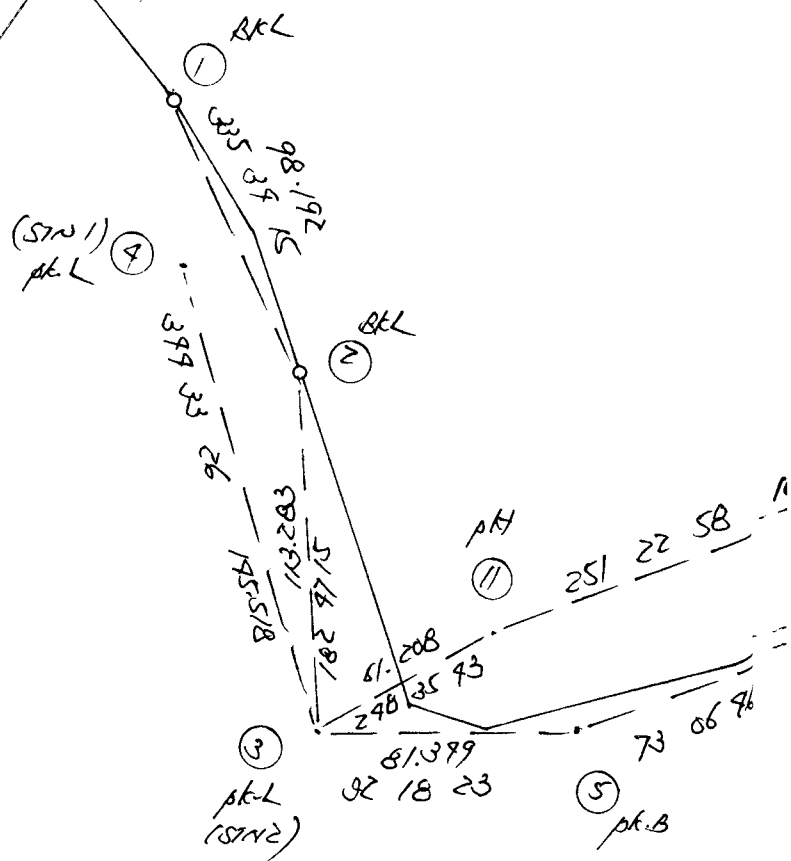

A simple line drawing of a house. The house has a rectangular body and a triangular roof. A single vertical line extends from the right side of the roof, representing a chimney. The drawing is composed of several straight line segments.

