

JRS 80631 Tg. Sept.

5/1/09

Jatim Danipada
PA 27052.

36 0890 2

36 0890 1

4

51.090

51.090

Aj Ak.

Agn Mxj

2-3 212 2338

2 212 2338

3

4

29.183

AjKL

29.183

2-4 169 9626

2 169 9626

4

4

11.751

BKL

11.751

2-5 135 9522

2 135 9522

5

4

32.999

BKL

32.999

2-6 119 0200

2 119 0200

6

4

31.979

BKL

31.979

2-7 95 0697

2 95 0697

7

4

9.711

Sp.L

9.711

1 36 0890 216 0890 127 0905 2 127 0905 8 4

58.773

58.773

2

8 127 0905 307 0905

pk.B

2 216 0890 36 0890 122 0718 1 122 0718 9 4

57.372

57.372

12

9 122 0718 302 0718

pk.B

2 Septis Di Atas 197 0532 1 197 0532 10 4

17.997

17.997

1

10 197 0532 17 0532

PL

1 302 0718 122 0718 26 2695 9 26 2695 11 4

37.789

37.789

9

11 26 2695 206 2695

pk.B

1 3020718 1220718 863509 9 863509 12 4 3.892 3.892

9
12 863509 2663509

BtL

11-13 1217732

11 1217732 13 4 29.985

BtL 29.985

11-19 1235259

11 1235259 19 4 6.927


pLLE 6.927.

Demarcation.


1 - B C	118 0196	27.359	pt. B
1 - B	98 0911	3.789	pt. B
C - D	211 1550	16.703	PB

10-17	81 1396	79.697	N
	81 1135	79.712	PO
		-2' 1"	-0.005

10-15	183 2939	50.217	N
	183 3139	50.196	PO
		-1' 55"	+0.021

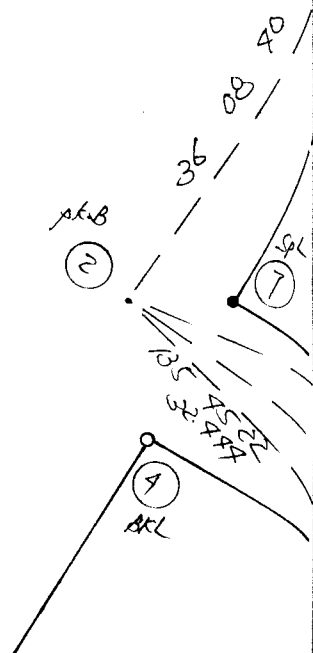

MUKAM OF BATU
DISTRICT OF KUALA LANGSAT.
TG. SEPAT

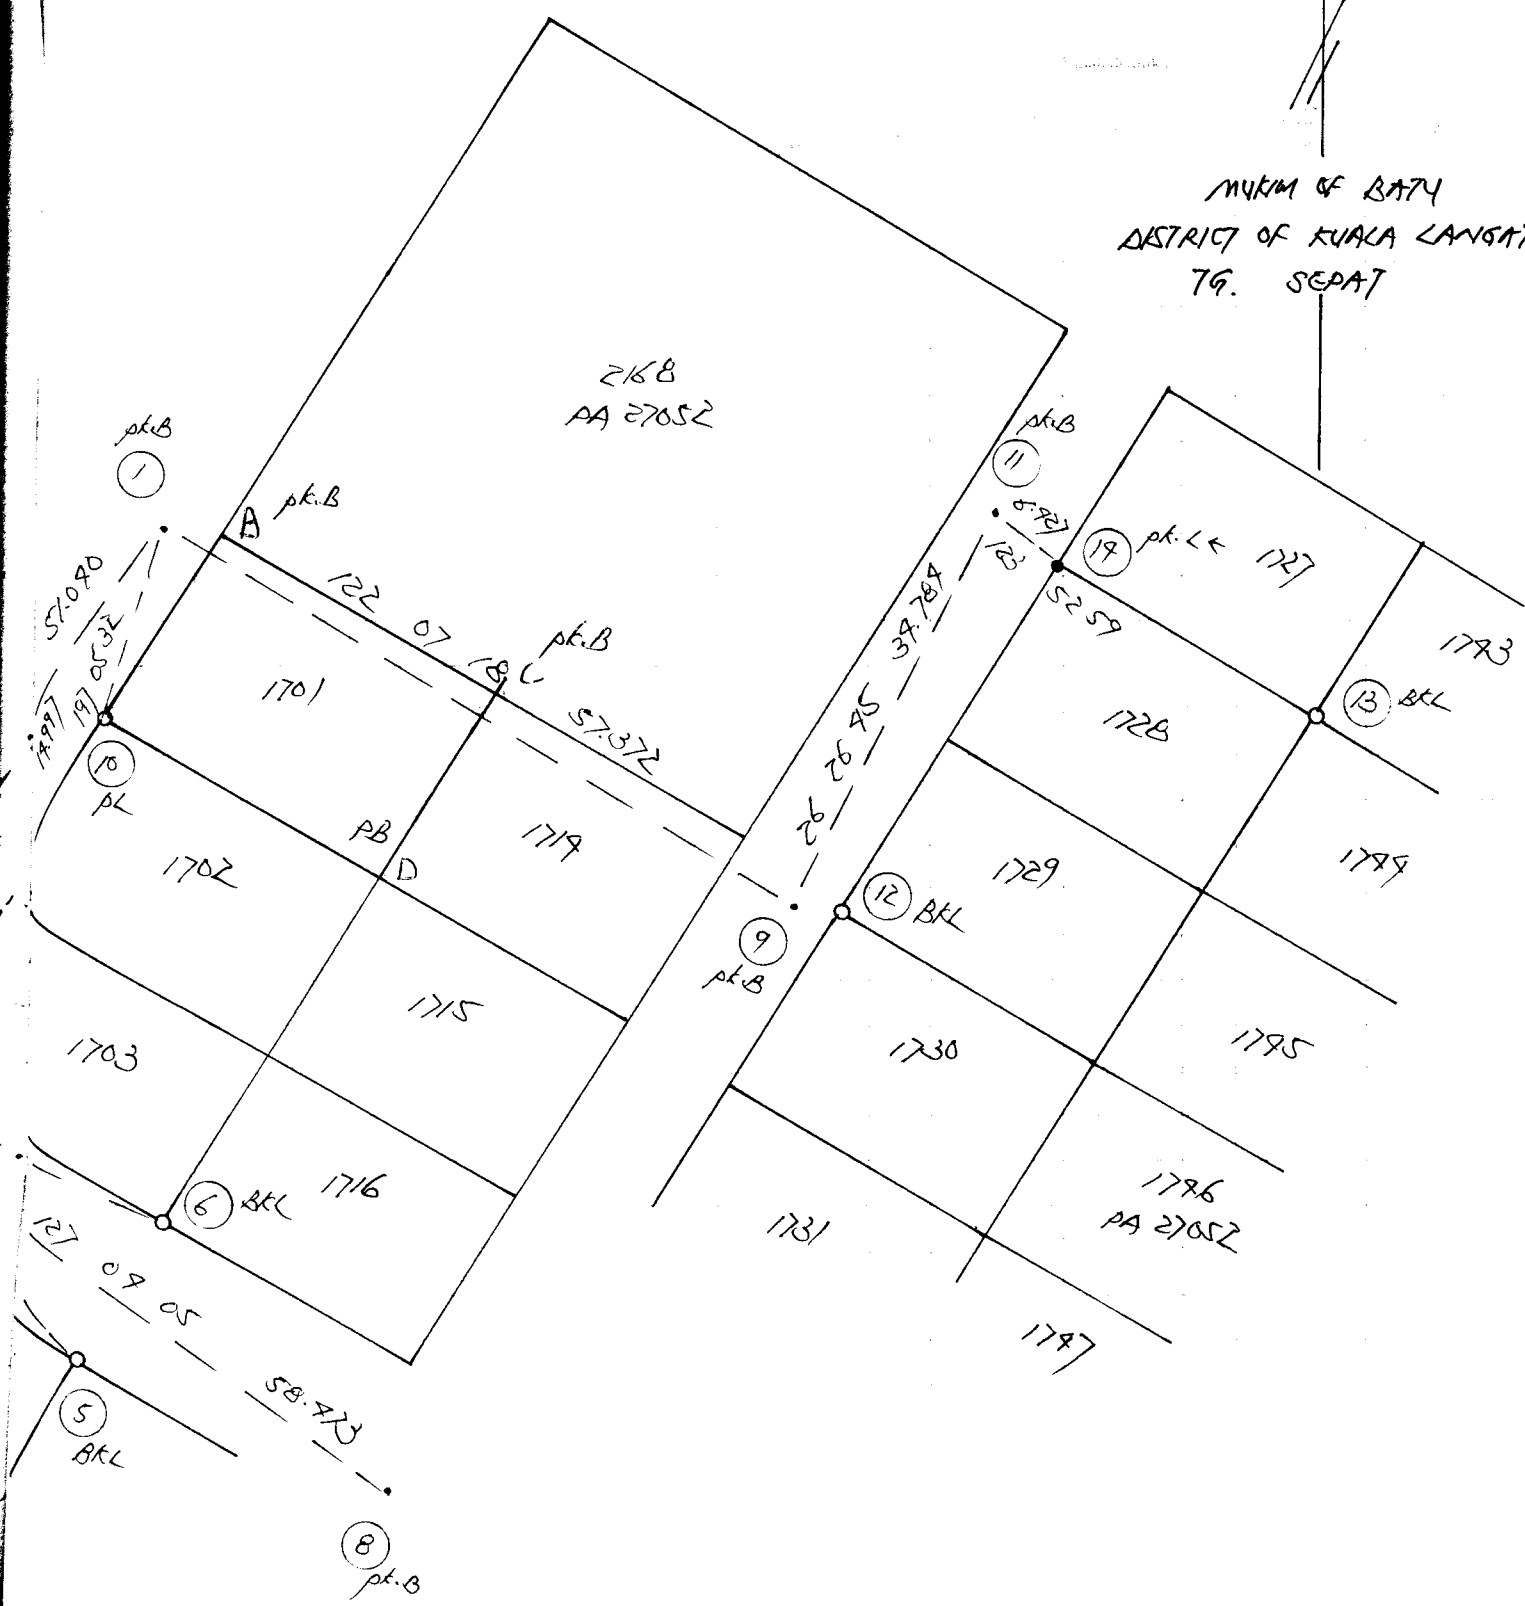

CERAPAN MATAHARI BAGI AZIMUT

Penilik: JRS80631 Tg Sepat Tarikh: 05/01/2009

Stn. 2 Koordinat: S56916 B15814 Selangor

T.R. 1 B.K. Ms.

Tiodolit Satu bah. aras ufuk:

Waktu	Sasaran	Ufuk	Gelembong	Puguk
	T.R.	35 00 00		
8 10	M.H.	112 45 02	79 12 33	Waktu purata 8 10 30
8 10	M.H.	112 12 41	79 07 31	Beza dari U.T. - 8 00 00
8 11	M.H.	292 13 21	281 00 01	U.T. 0 10 30
8 11	M.H.	292 47 08	281 03 50	Deklinasi - 22 37 11
	T.R.	215 00 10		

	T.R.	35 00 00		
8 12	M.H.	112 48 39	78 47 14	Waktu purata 8 12 30
8 12	M.H.	112 16 03	78 43 15	Beza dari U.T. - 8 00 00
8 13	M.H.	292 16 40	281 24 06	U.T. 0 12 30
8 13	M.H.	292 50 30	281 28 05	Deklinasi - 22 37 11
	T.R.	215 00 10		

	Set 1	Set 2
Sudut pugak	10 55 57	11 20 25
Pembetulan	- 0 04 19	- 0 04 09
Altitud	10 51 38	11 16 16
Jarak kutub	112 37 11	112 37 11
Latitud	2 39 34	2 39 34
Azimut M.H. yang dikira	113 38 18	113 41 40
Purata ke M.H.	112 29 33	112 32 58
Selisih:	1 08 45	1 08 42
Purata ke T.R.	35 00 05	35 00 05
Azimuth T.R. sebenar	36 08 50	36 08 47
Pembetulan aras	+ 0 00 00	+ 0 00 00
Tirusan	- 0 00 09	- 0 00 09
Bering grid T.R.	36 08 41	36 08 38

Purata bering grid T.R.

36 08 40