

LOTS 5255-5257  
MUKIM OF PETALING  
DISTRICT OF  
KUALA LUMPUR

Scale Two Chains to an Inch

Std. Sheet 93-8

Svy. Ref. R. 8.5.82-56

L. O. Ref. D. O. K. L. 735-52

Cal. Vol. 293 pp. 574-58

Surveyed by Abu bin Manap

Completed on 29.8.56

Field Book 12505 pp. 1-12

Second Class Survey

Drawn & Charted by M. J. G. L.


Examined by CH. L. M. 17-12-58

Approved 31.12.58

Plan No. 21465

Note:-  
Lots 5255, 5256 & 5257 comprise parts of lots  
1001, 1002 & 1003 respectively Plan 4107

Adopted Azimuth from Plan 20237

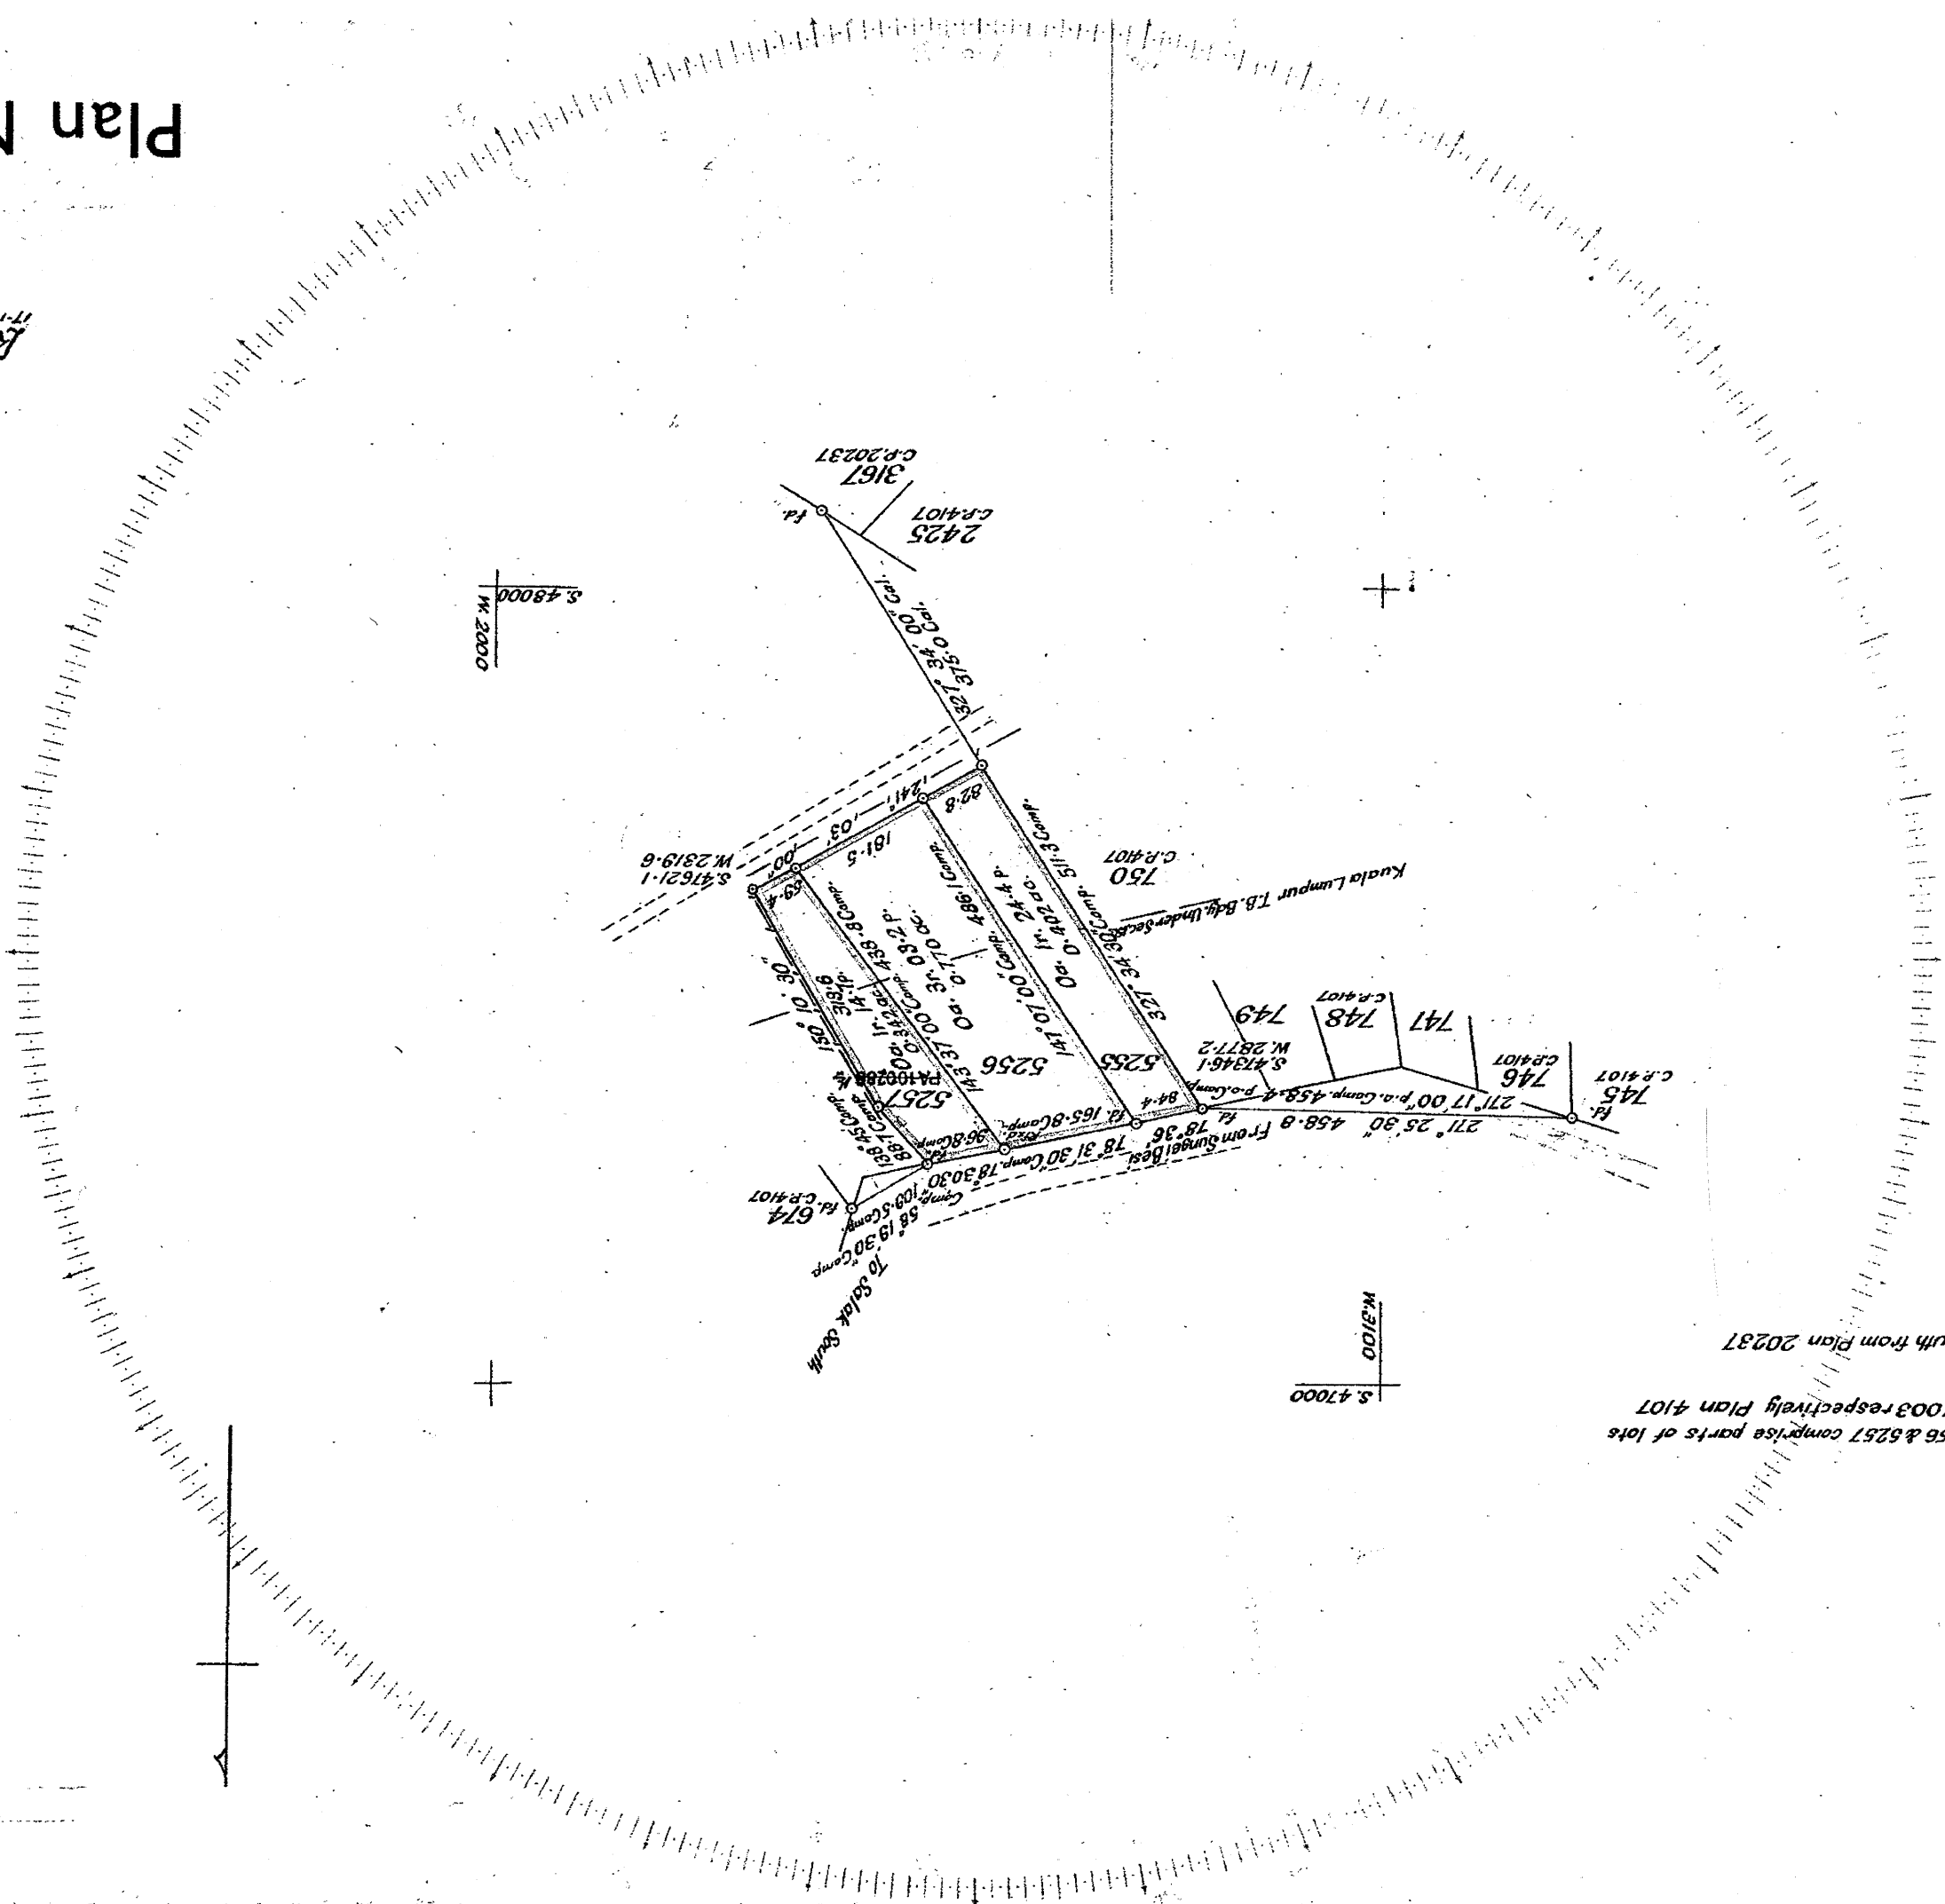

S. 48000  
W. 2000

S. 47000  
W. 3100