


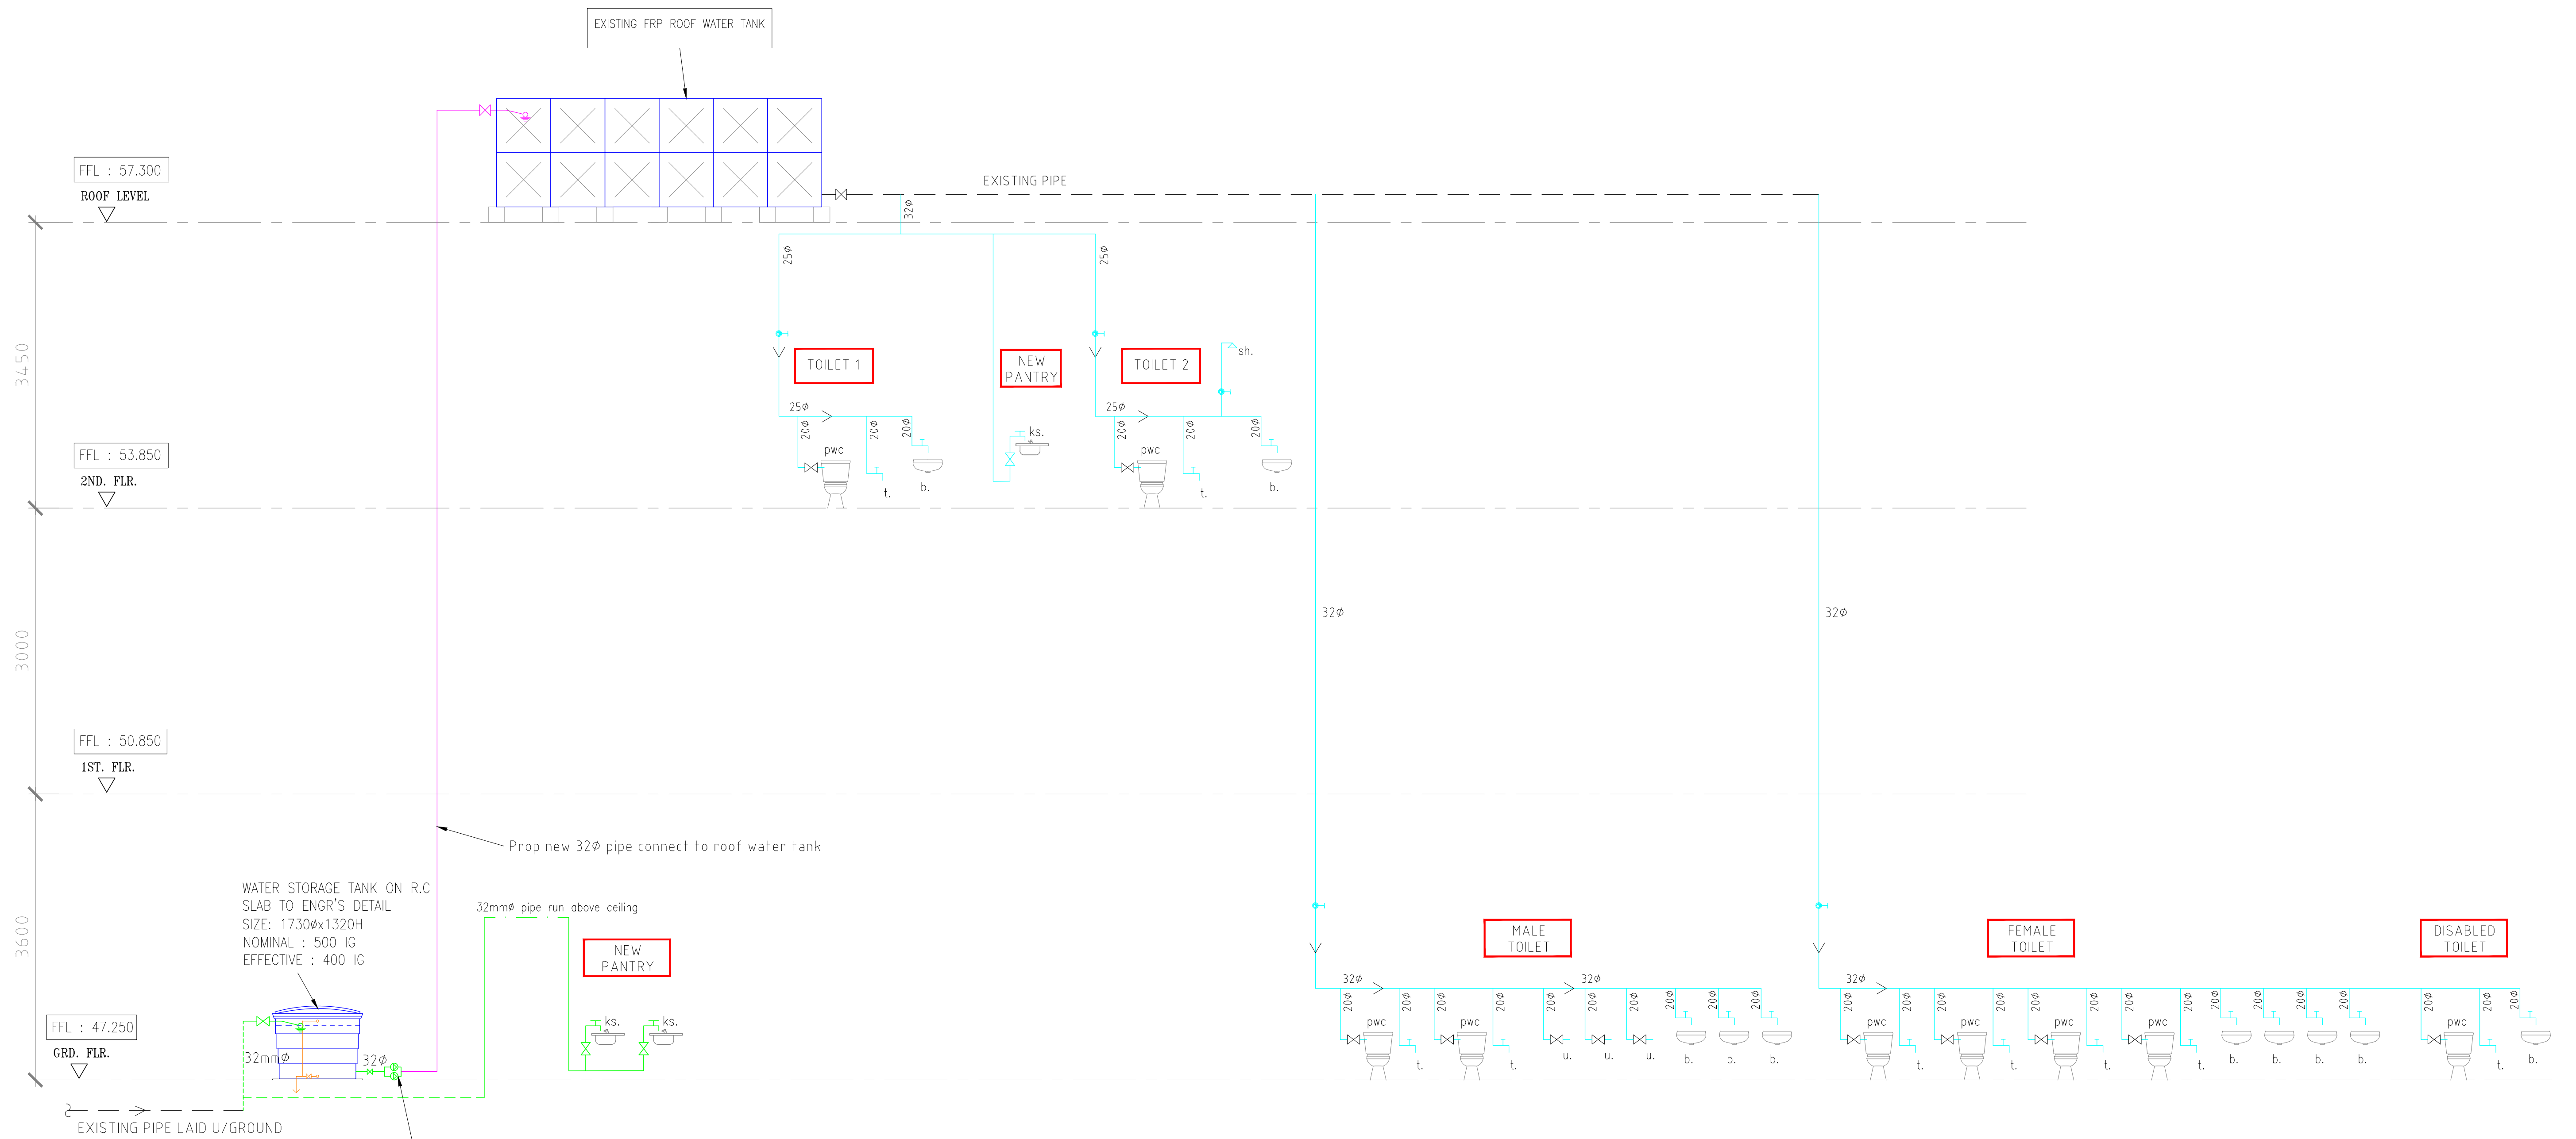

COLD WATER PIPING SCHEMATIC DIAGRAM
SCALE : N.T.S.

MAIN CONTRACTOR : NSK Construction & Engineering Sdn. Bhd. 8-2-6, 881 One Boulevard Lebuhr. Batu Nilam 2, Bandar Bukit Tinggi, 41200 Klang, Selangor Darul Ehsan. Tel : +603-3325 2328 / 2628 Fax : +603-3325 2168 E-mail: enquiry@nskce.com		
Tajuk Lukisan : COLD WATER PIPING SCHEMATIC DIAGRAM		
Tarikh : April 2023	Dilukis Oleh : Teoh	
Ukuran : N.T.S.	Disemak Oleh : Ng	
Projek No: JCY/18043/SCH-01		Bil. Lukisan : -

AS BUILT DRAWING
APRIL 2023