

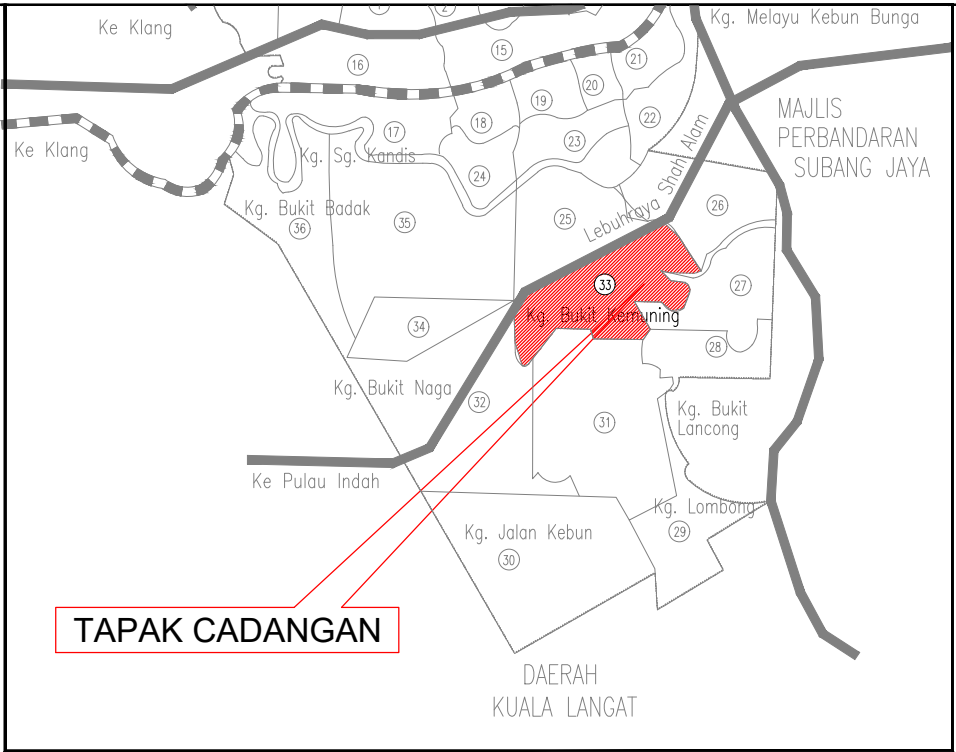
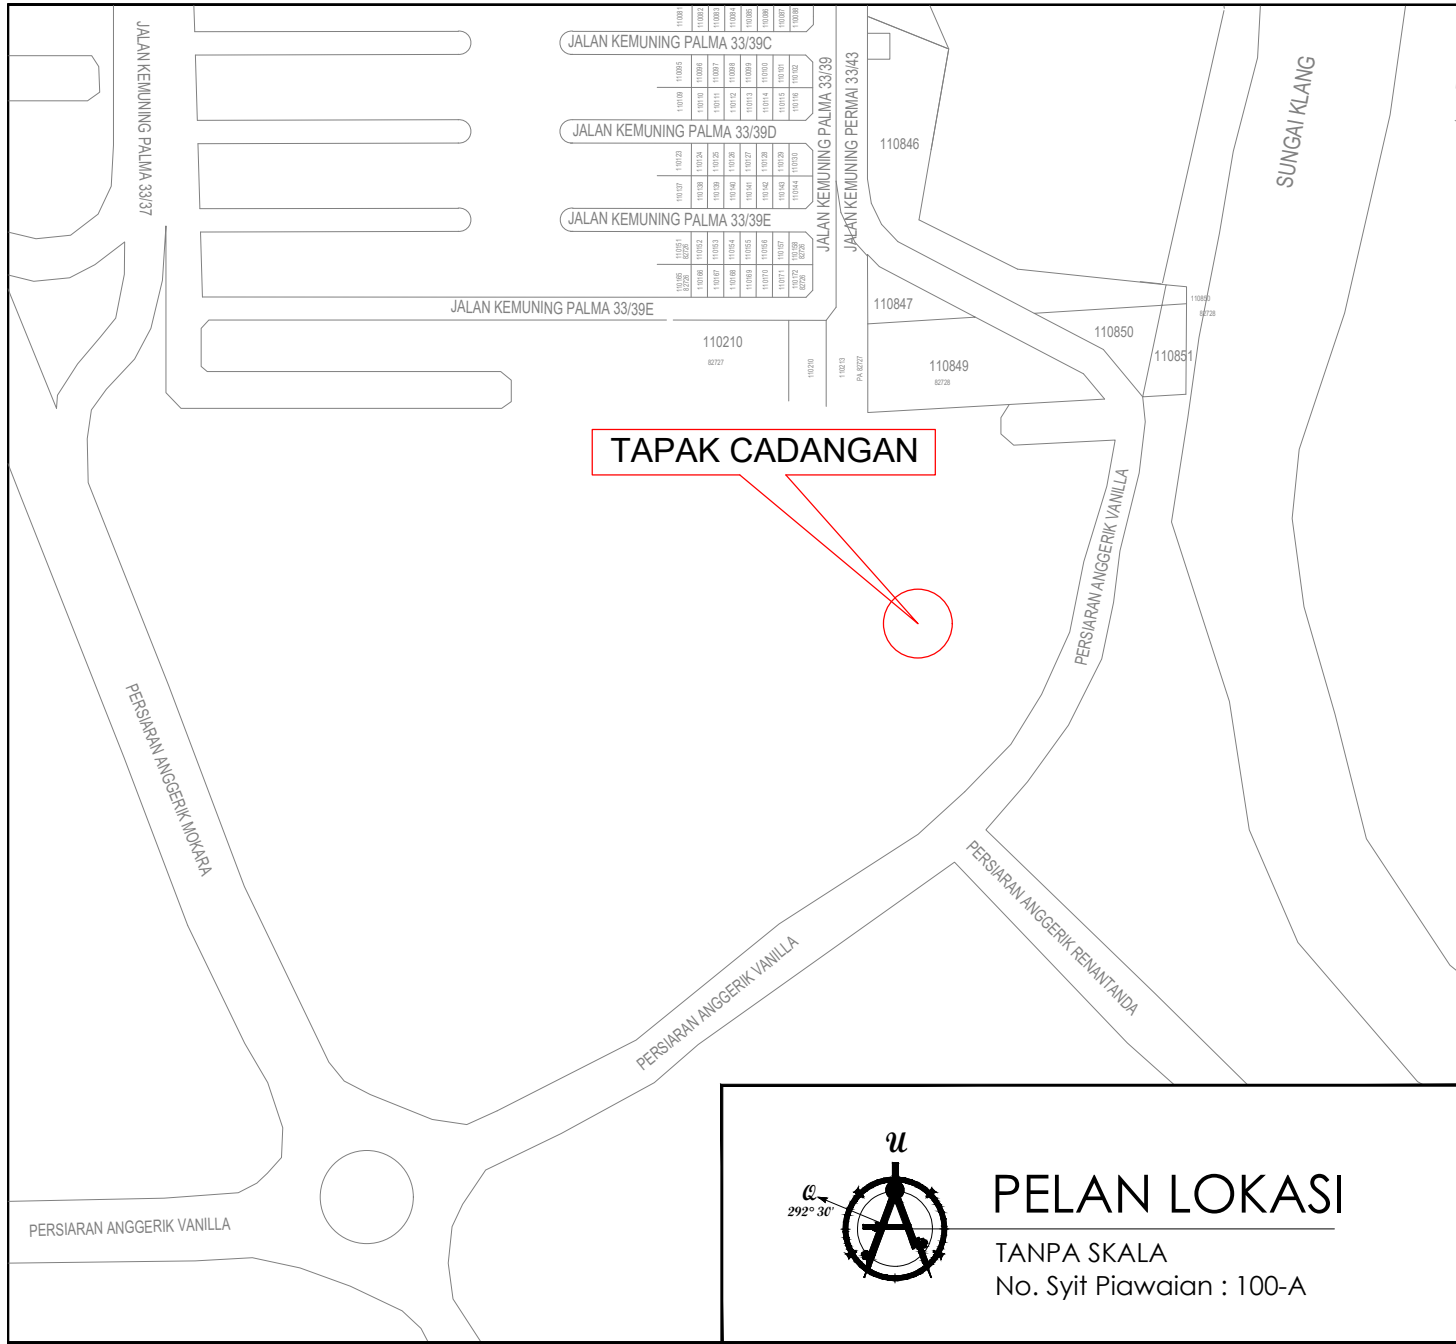
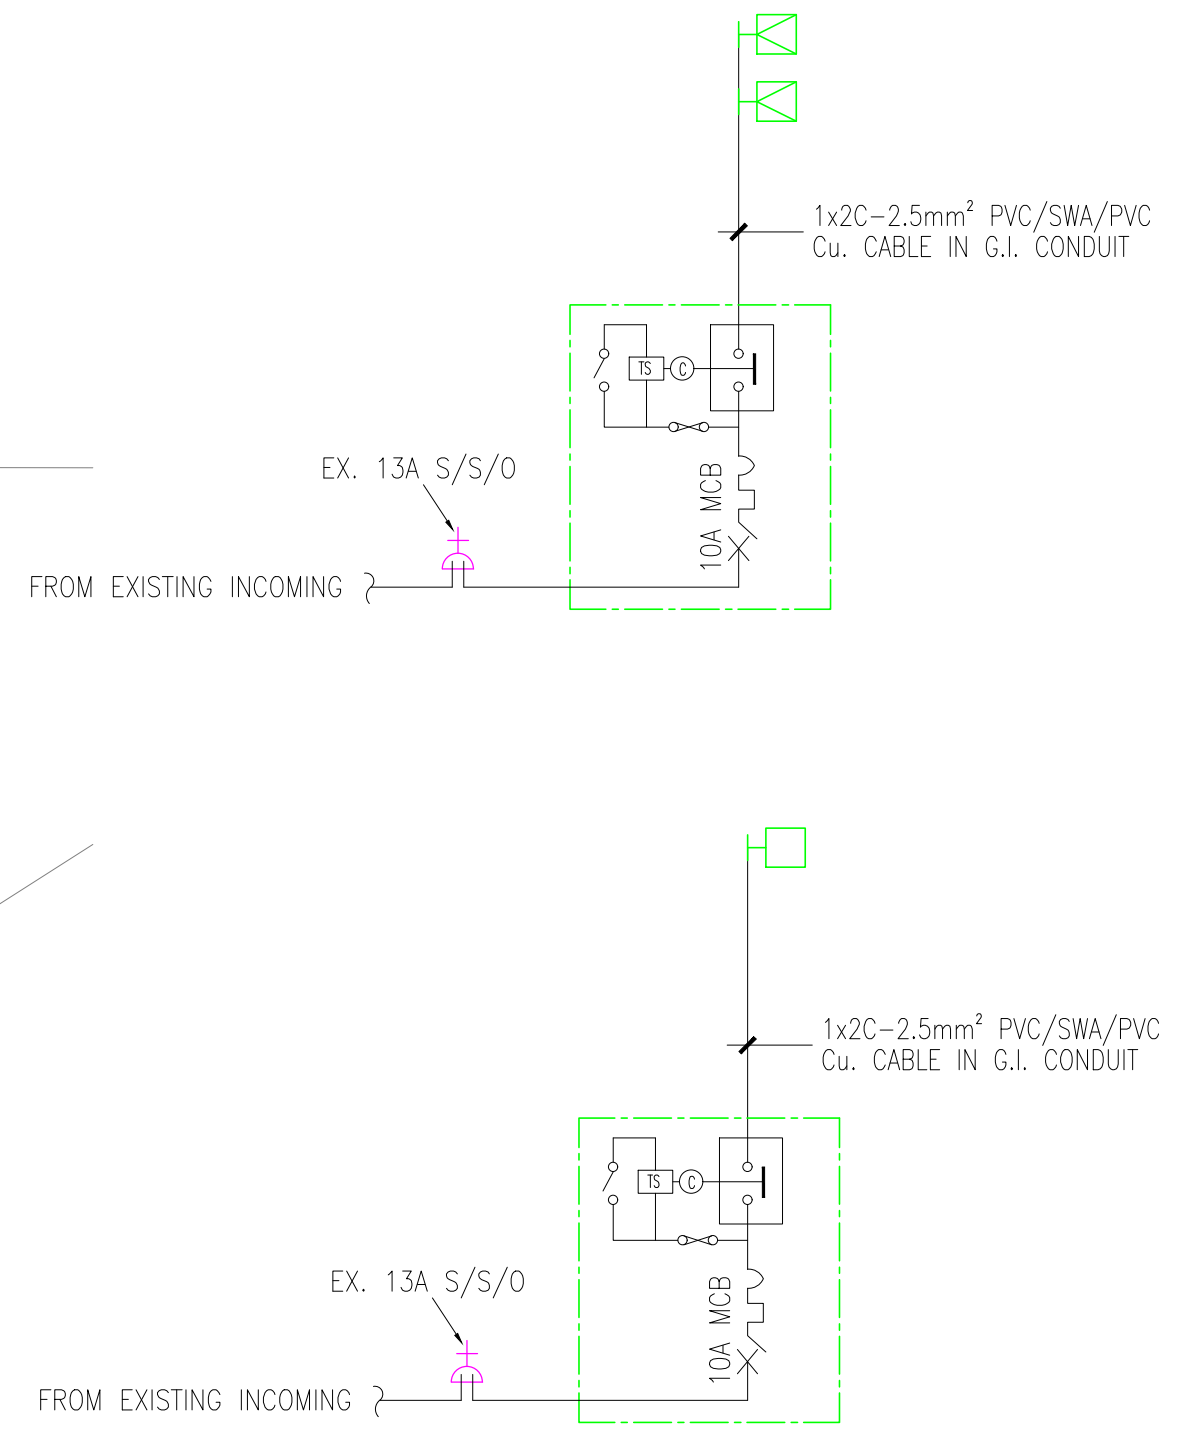


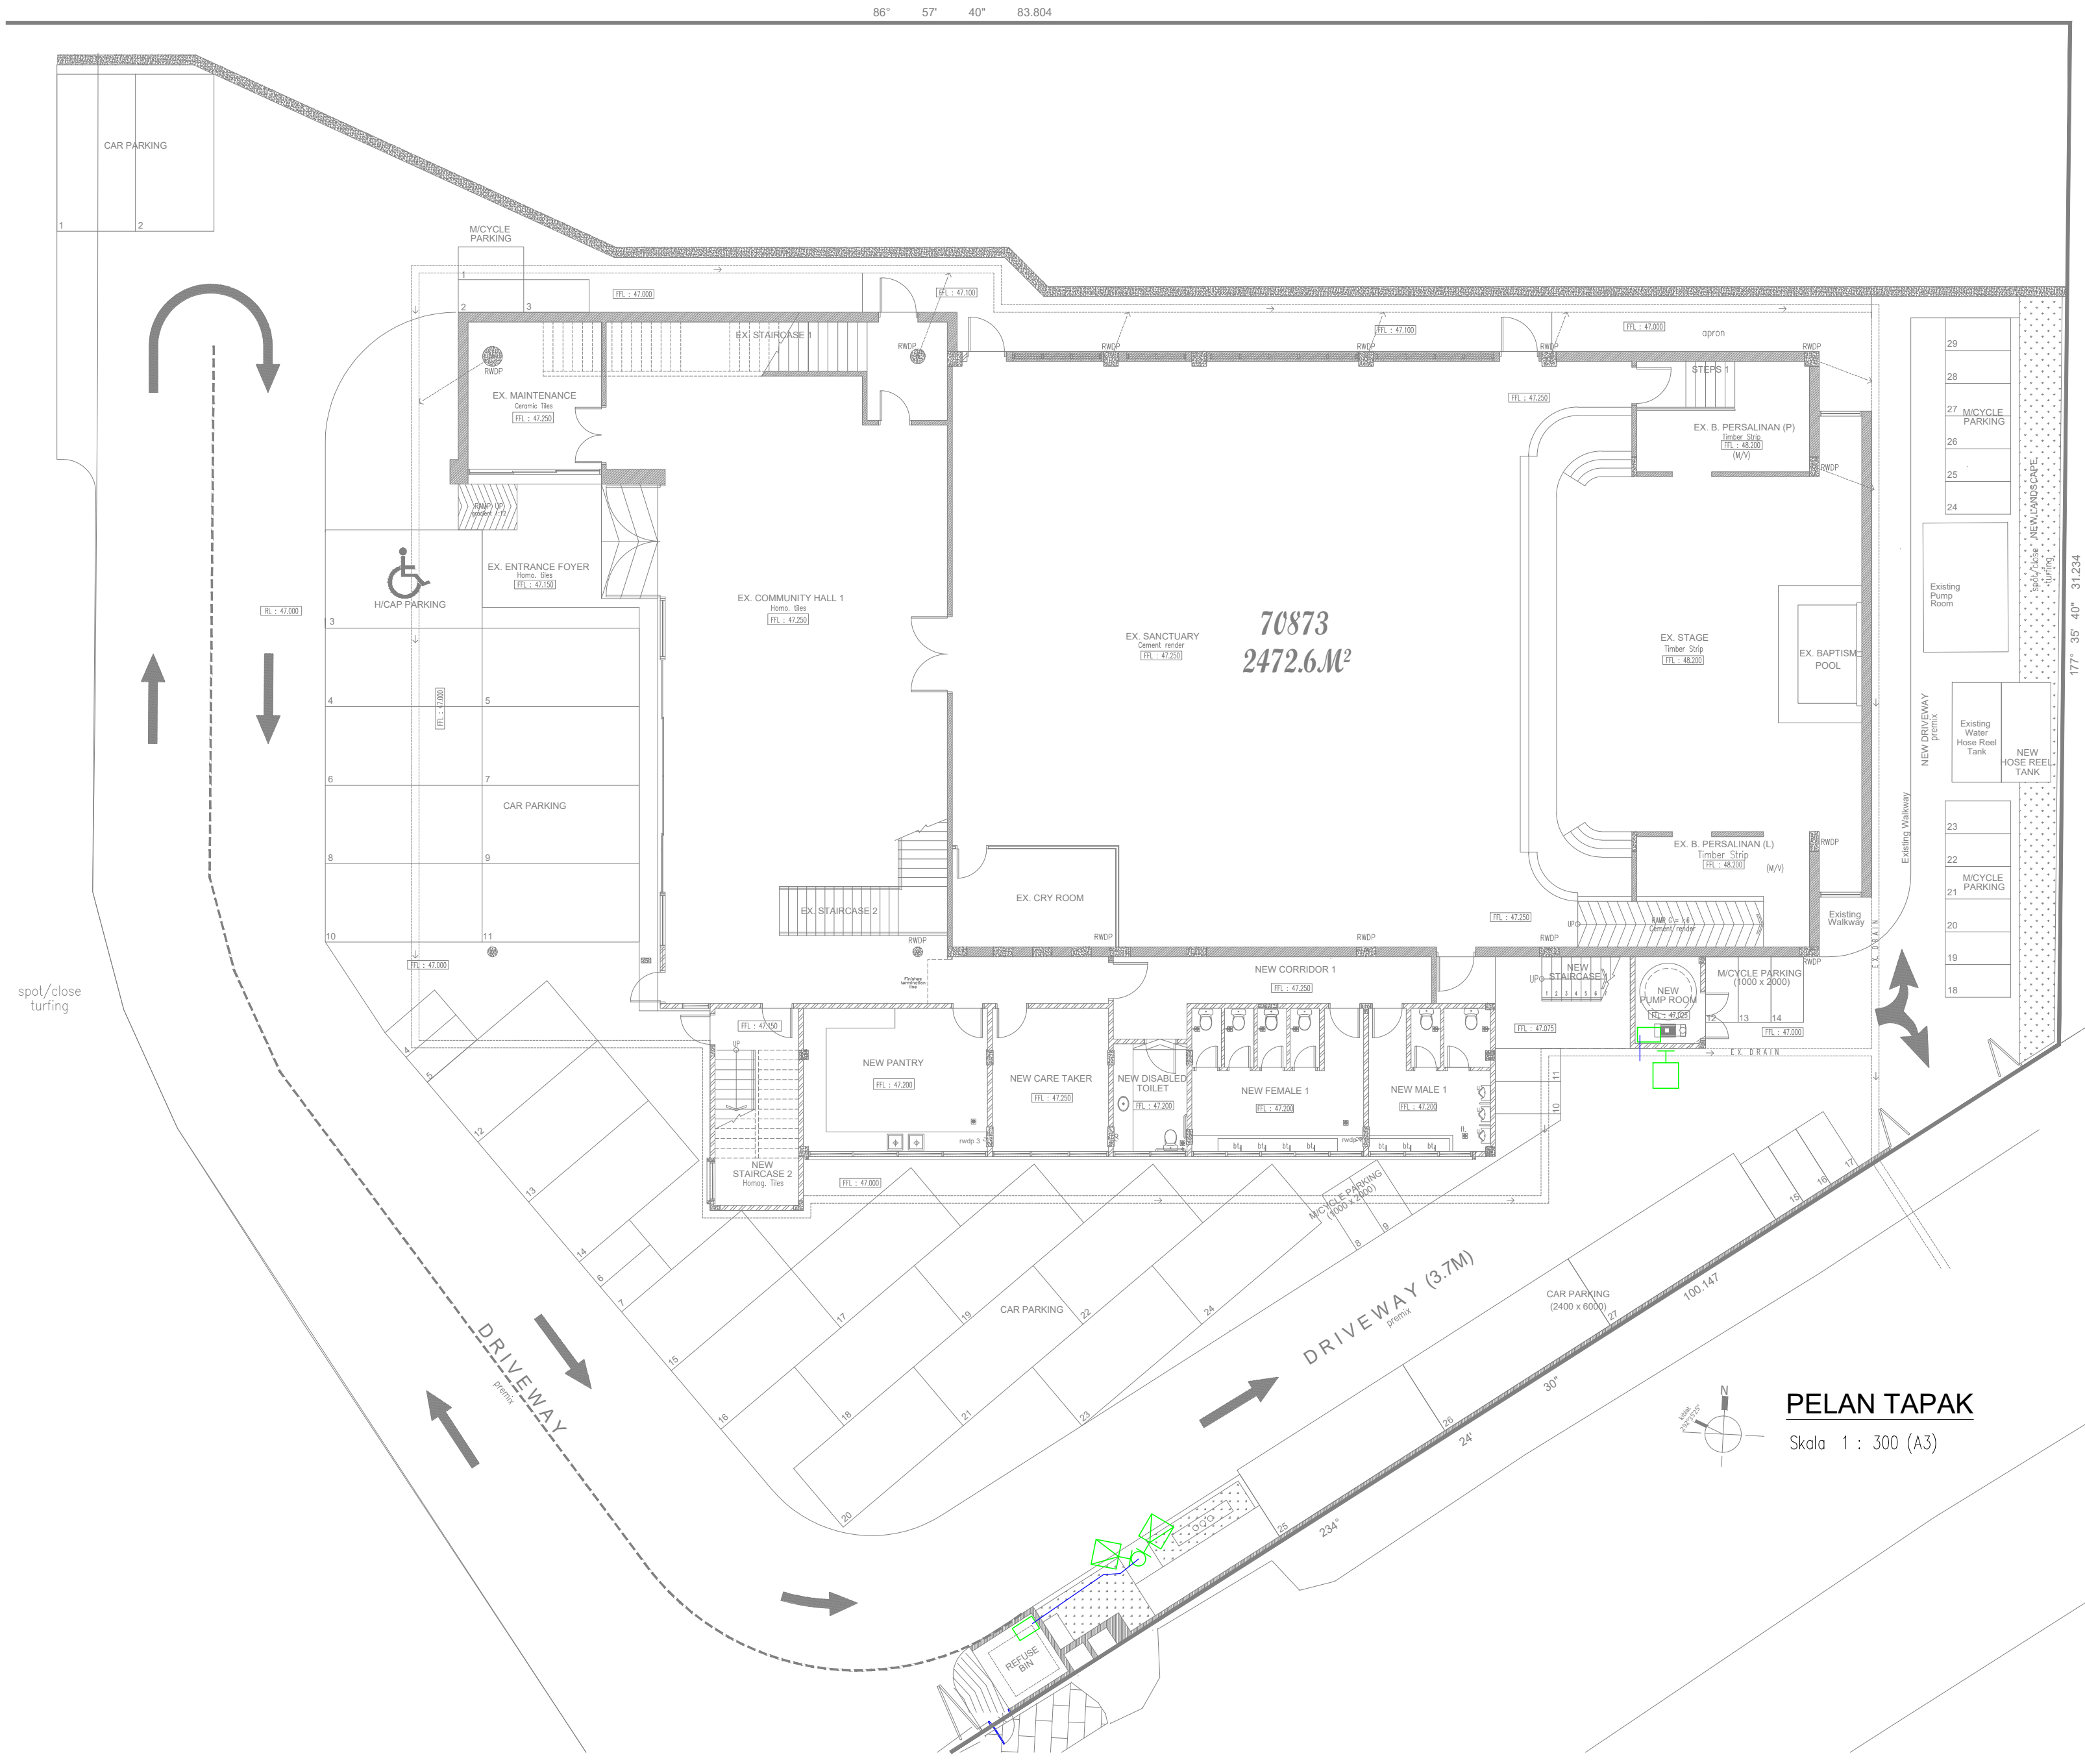

PELAN KUNCI
TANPA SKALA

PELAN LOKASI
TANPA SKALA
No. Syif Pitawaan : 100-A

SYMBOL	DESCRIPTION
	200W LED FLOOD LIGHT C/W SUPPORT BRACKET MOUNTED ON 6m AFFL
	200W LED FLOOD LIGHT C/W SUPPORT BRACKET MOUNTED ON WALL

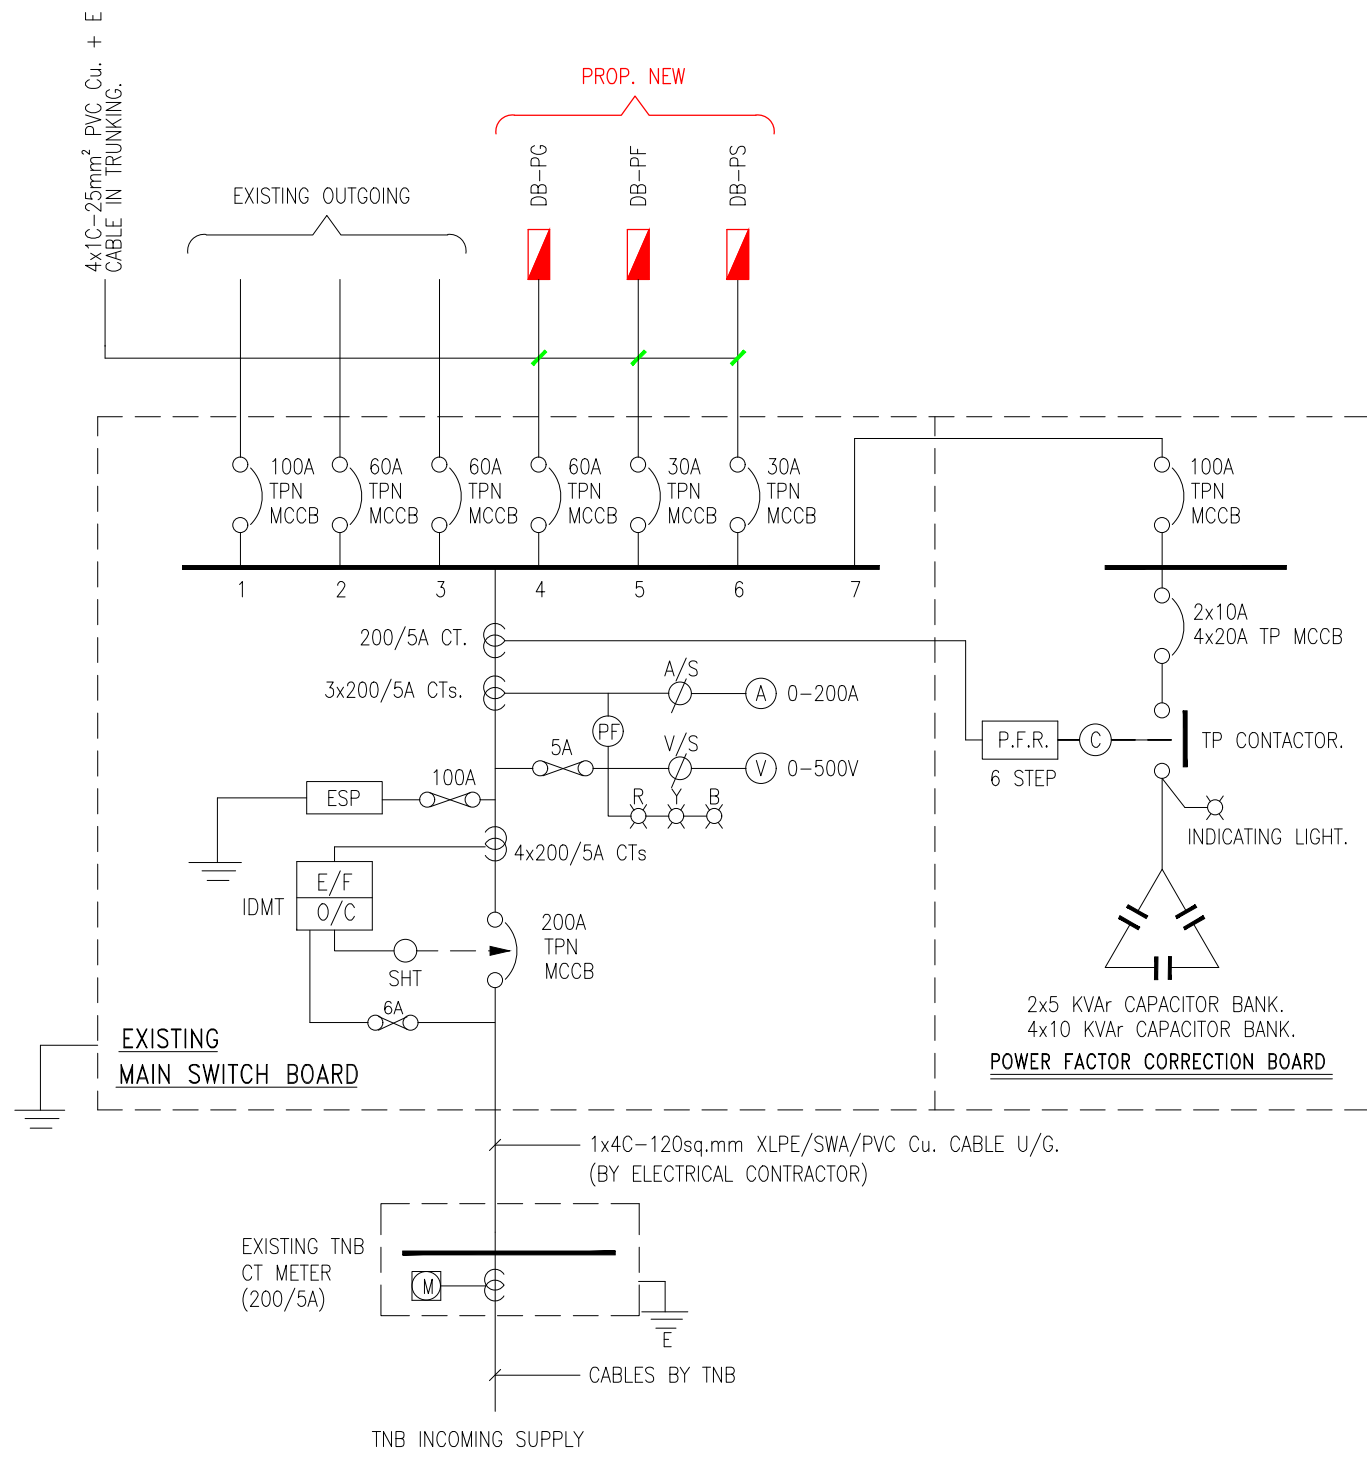

PELAN TAPAK
Skala 1 : 300 (A3)

AS BUILT DRAWING
APRIL 2023

PEMILIK :

THE SECRETARY OF THE TRUSTEES
OF THE METHODIST CHURCH IN MALAYSIA

Address : No. 69, Jalan 5/31,
46000 Petaling Jaya,
Selangor Darul Ehsan

PERUNDING M & E :

PERUNDING JC YEO SDN. BHD.

(817811-M)

MECHANICAL & ELECTRICAL CONSULTING ENGINEERS

NO. 62B, JALAN BENDAHARA 8, OFF JALAN SUNGAI JATI,
TAMAN SENTOSA JAYA, 41200 KLANG,
SELANGOR DARUL EHSAN.

TEL : 03-5162 1499
E-mail: pjyso@gmail.com

MAIN CONTRACTOR :

NSK Construction & Engineering Sdn. Bhd.

B-2-6, 8BT One Boulevard
Lebuah Batu Nilam 2, Bandar Bukit Tinggi,
41200 Klang, Selangor Darul Ehsan.

Tel : +603-3325 2328 / 2628
Fax : +603-3325 2168
E-mail: enquiry@nskce.com

PROJEK:

CADANGAN TAMBAHAN DAN PINDAAN KEPADA SEBUAH
GEREJA DUA TINGKAT SEDIA ADA DAN SATU UNIT TEMPAT
PEMBUANGAN SAMPAH DI NO.7, PERSIARAN ANGERIK
VANILLA, SEKSYEN 31, 40460 SHAH ALAM, SELANGOR
DARUL EHSAN UNTUK
TETUAN THE SECRETARY OF THE TRUSTEES
OF THE METHODIST CHURCH IN MALAYSIA

TAJUK LUKISAN:

PELAN KUNCI, PELAN LOKASI & PELAN TAPAK

- LOKASI UNTUK MSB SEDIA ADA
- GAMBARAJAH SKEMATIK UNTUK MSB

SKALA : DITUNJUKKAN

DILUKIS OLEH : TEQH

DISEMAK OLEH : NG

TARIKH : APRIL 2023

NO. LUKISAN

JCY/18043/SPE-1

NO. PINDAAN

(-)