


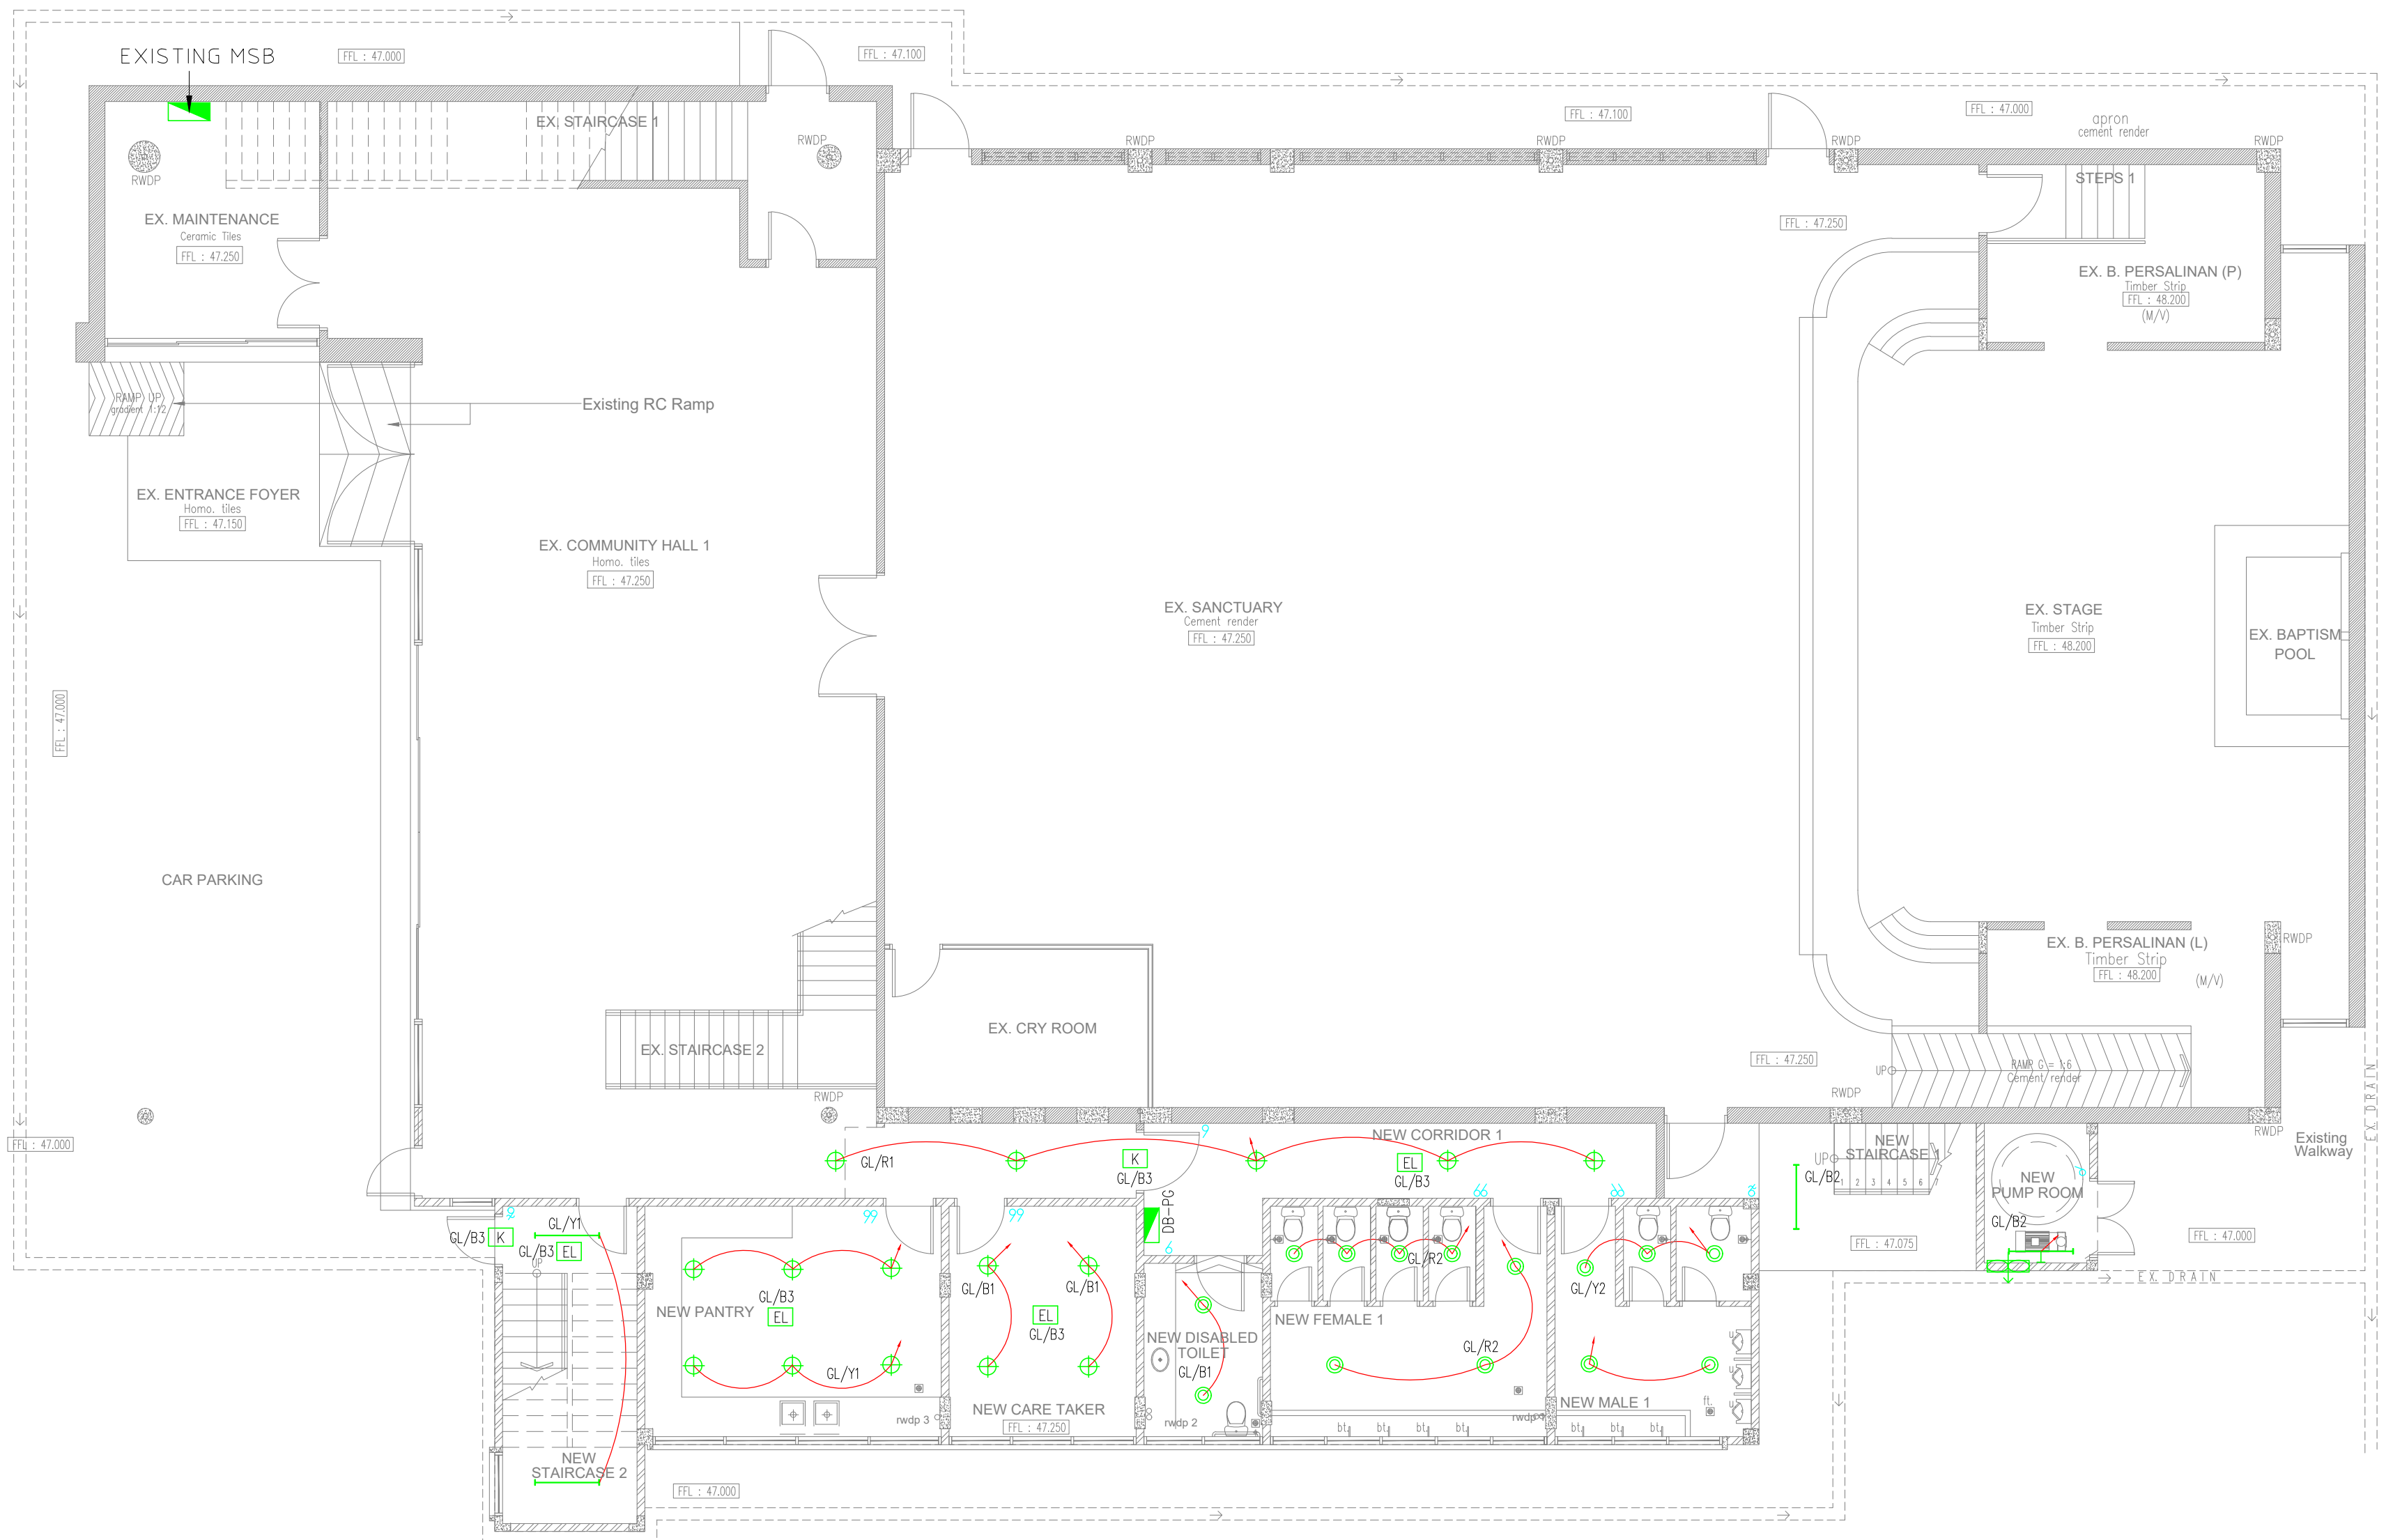


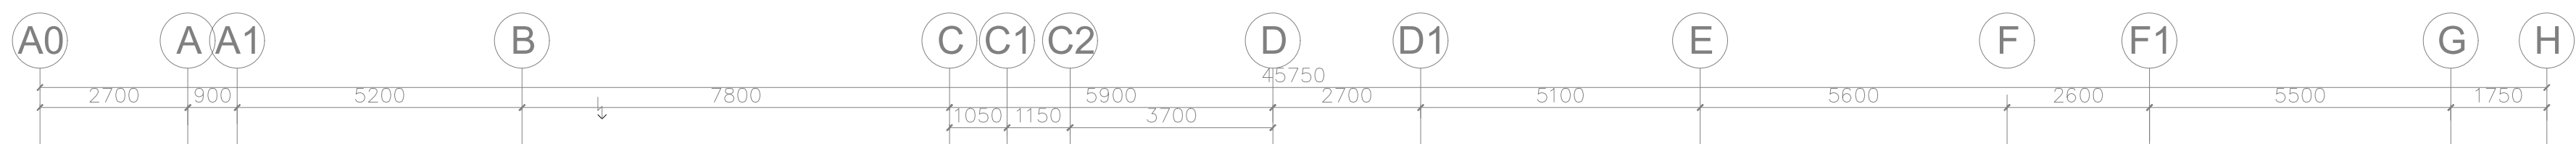

GROUND FLOOR PLAN - LIGHTING & AIR COND LAYOUT
SCALE = 1 : 200 (A3)

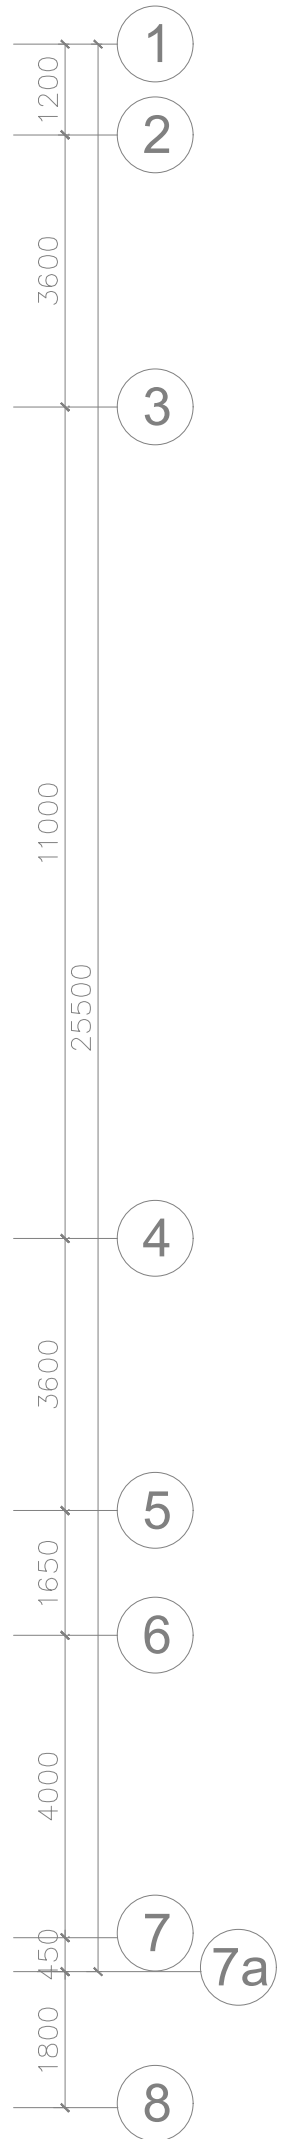

LEGEND:		QTY			
		GRD.	FIRST	SECOND	TOTAL
	13W LED DOWN LIGHT	14	-	4	18
	25W LED DOWN LIGHT	15	45	51	111
	1x18W LED BARE CHANNEL FLUO.	4	4	4	12
	8W EMERGENCY LIGHT FITTING	4	10	10	24
	15W KELUAR SIGN FITTING	2	2	2	6
	1HP WALL MOUNTED AIR-COND	0	1	0	1
	1.5HP WALL MOUNTED AIR-COND	0	1	6	7
	2.0HP WALL MOUNTED AIR-COND	0	2	0	2
	2.5HP WALL MOUNTED AIR-COND	0	1	0	1
	13A SWITCH SOCKET OUTLET	13	30	30	73
	WATER HEATER POINT	0	0	1	1
	AIR-COND POINT	1	4	6	11
	LIGHTING SWITCH (ONE-WAY)	7	14	14	35
	LIGHTING SWITCH (TWO-WAY)	2	6	6	14
	DISTRIBUTION BOARD (DB)	1	1	1	3
	12" EXHAUST FAN C/W FRAME	1	0	0	1
	5' CEILING FAN C/W REGULATOR SWITCH, HOOK AND ACCESSORIES	0	0	0	0
	AIR COMPRESSOR	0	5	6	11
	REFRIGERANT PIPE - SUPPLY AND RETURN COPPER PIPES ARE TO BE INSULATED SEPARATELY USING ARMAFLEX				
	ALL CONDENSATION PIPE USING 25mmØ UPVC PIPE FOR FAN CEILING UNIT C/W ARMAFLEX INSULATOR CONNECT TO MAIN CONDENSATION PIPE 38mmØ				

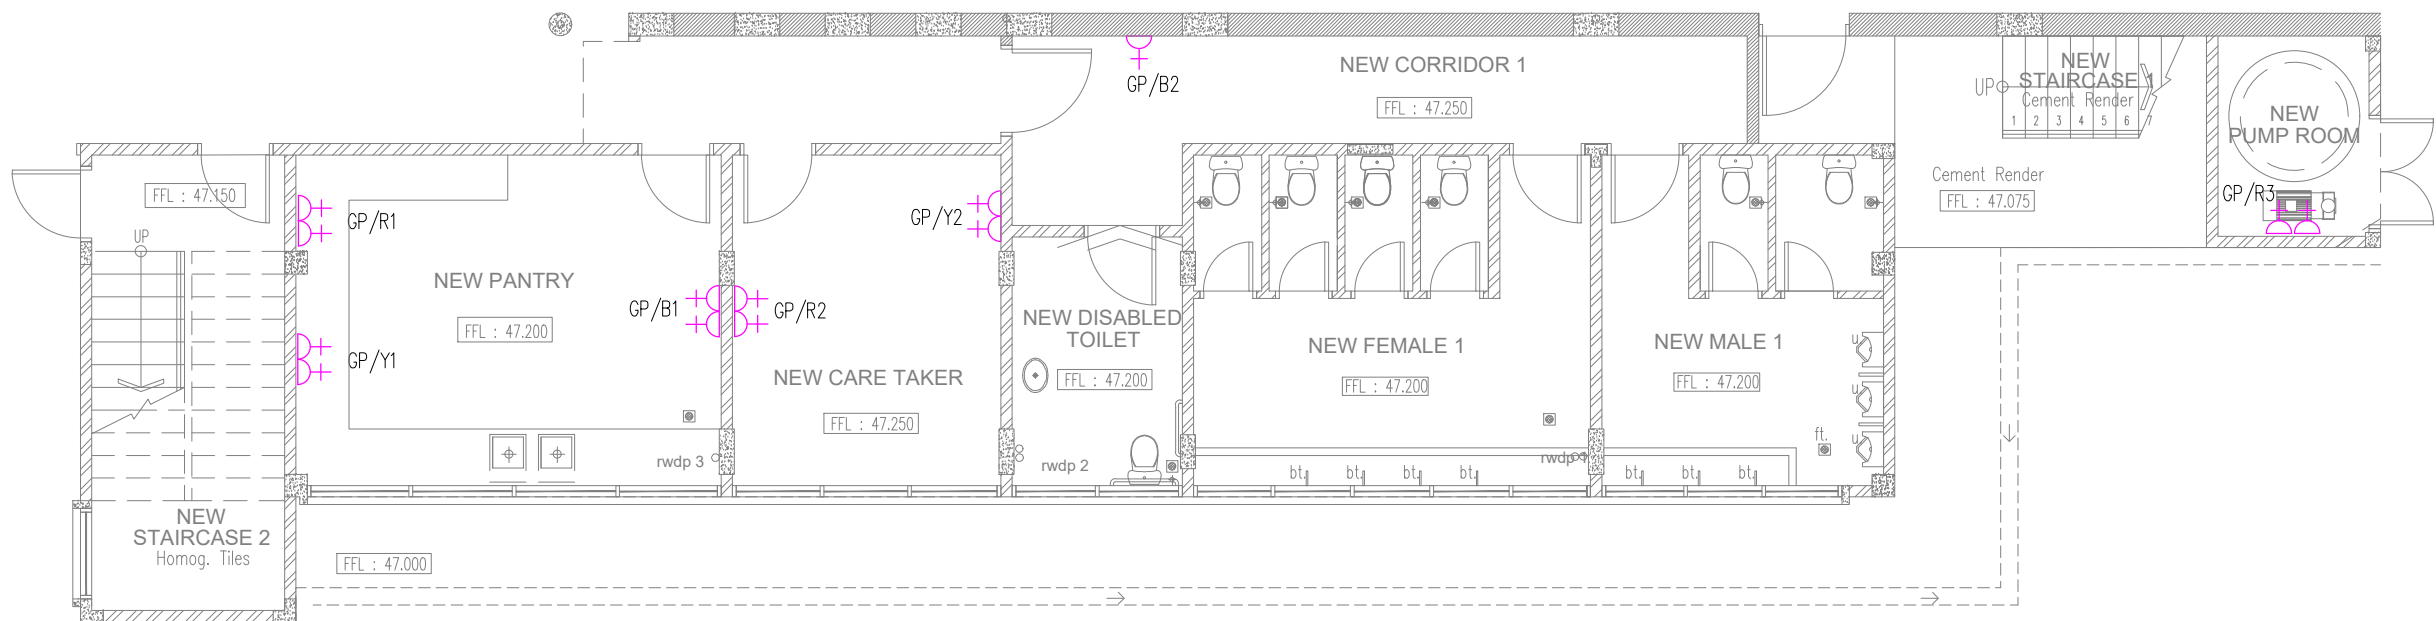

GROUND FLOOR PLAN - POWER POINT LAYOUT
SCALE = 1 : 200 (A3)

MAIN CONTRACTOR : NSK Construction & Engineering Sdn. Bhd. B-2-6, BBT One Boulevard Lebuhraya Nelayan 2, Bandar Bukit Tinggi, 41200 Klang, Selangor Darul Ehsan. Tel : +603-3325 2328 / 2628 Fax : +603-3325 2168 E-mail: enquiry@nskce.com	
Tajuk Lukisan : GROUND FLOOR PLAN LIGHTING, POWER POINT & AIR COND LAYOUT	
Tarikh : April 2023	Dilukis Oleh : Teoh
Ukuran : 1 : 100	Disemak Oleh : Ng
Projek No : JCY/18043/E-1A	Bil. Lukisan : -

AS BUILT DRAWING
APRIL 2023