


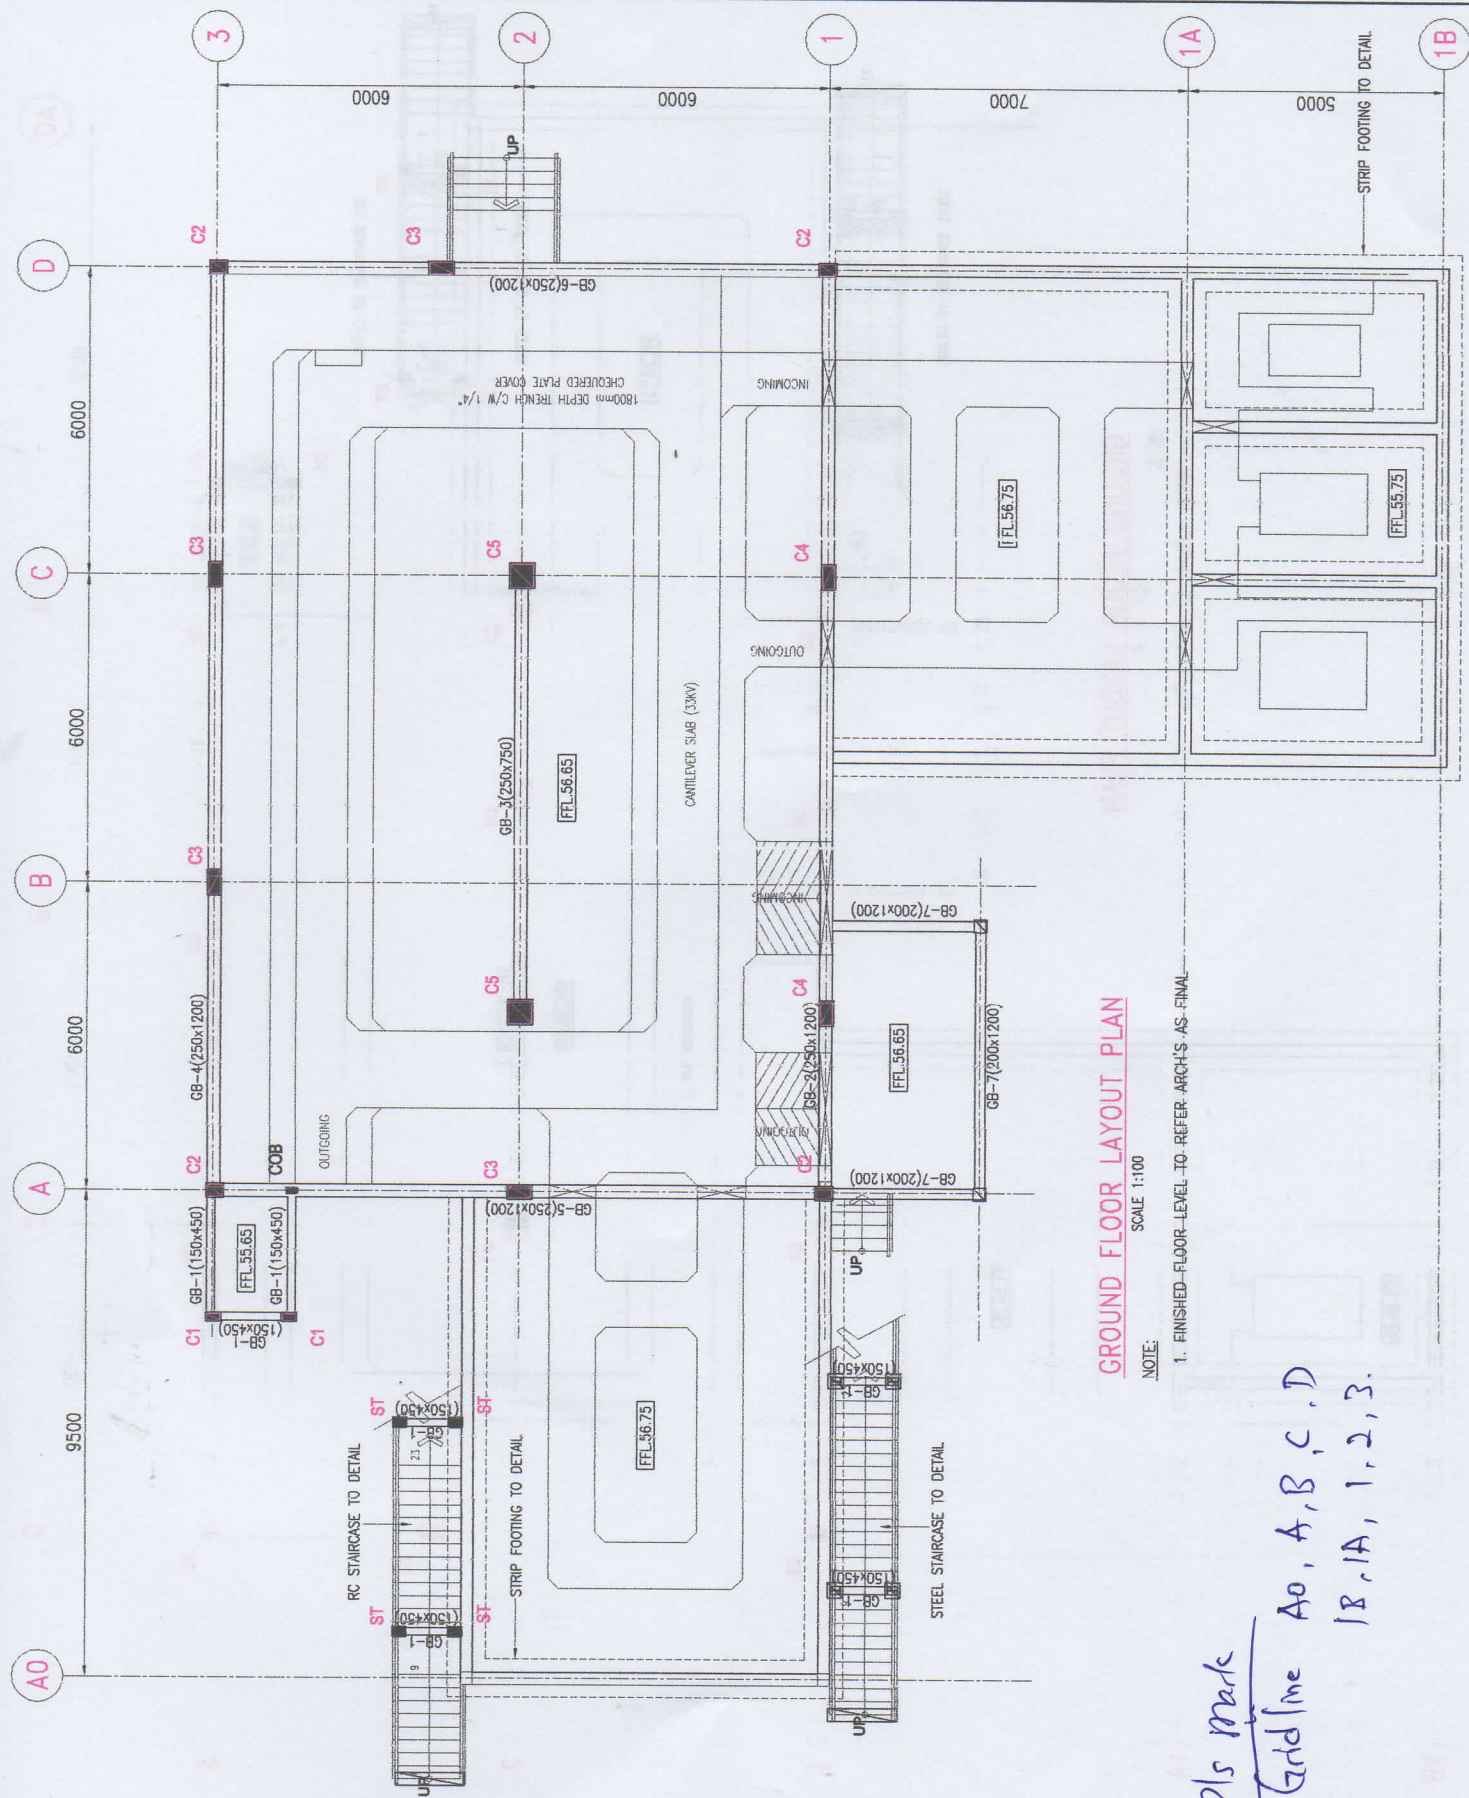

GROUND FLOOR LAYOUT PLAN

SCALE 1:100

NOTE:

1. FINISHED FLOOR LEVEL TO REFER ARCH'S AS FINAL

Pls mark
Gridline A0, A, B, C, D
 1B, 1A, 1, 2, 3.