

W 109 Tm Dava.

Jatim Dapada 137 1300 2 137 1113 1 4 12/8/09 93.065 93.065
M- 1'47"

2-3	38 9015	} M- 1'47"	2	38 3828	3	4	20.996	BKL	20.996
2-4	35 0803		2	35 0616	4	4	19.939	BKL	19.939
2-5	70 5717		2	70 5530	5	4	19.673	BKL	19.673
2-6	192 1615		2	192 1728	6	4	7.539	PL	7.539
2-7	138 2313		2	138 2126	7	4	37.938	PL	37.938
1-8	315 3357		1	315 3210	8	4	27.657	pt-L	27.657
1-9	352 7739		1	352 7552	9	4	37.727	PL	37.727
1-10	355 9706		1	355 9519	10	4	35.330	PL	35.330
1-11	359 0990		1	359 0753	11	4	33.057	pt-L	33.057

2	37 1300	137 1300	139 1639	1	139 1452	12	4	61.538	61.538
1			M- 1'47"		A3 Ak.				
12	139 1639	139 1639			Agg M4				
	pt-B								
1	139 1639	139 1639	221 0741	12	221 0559	13	4	79.662	79.662
12			M- 1'47"						
13	221 0741	221 0741							
	pt-B								
1	Sepati Di Atas	29 0657	12	29 0510	19	4	63.608	63.608	
12		M- 1'47"							
19	29 0657	29 0657							
	pt-B								


12-15 216 9838
12-16 321 0329
12-17 356 9959
12-18 5 5902

} M-1'97"

12	216	9851	15	4	70.350	Sp-L	70.350
12	321	0137	16	4	18.503	Sp-L	18.503
12	356	9807	17	4	70.209	PL	70.209
12	5	5215	18	4	69.905	PL	69.905

16-8	31/1950	70.682 ✓
	31/2000	70.735 10
	-10'	-0.053

17-8	299 3501	60.943 ✓
	299 3517	60.087 10
	-18'	-0.031

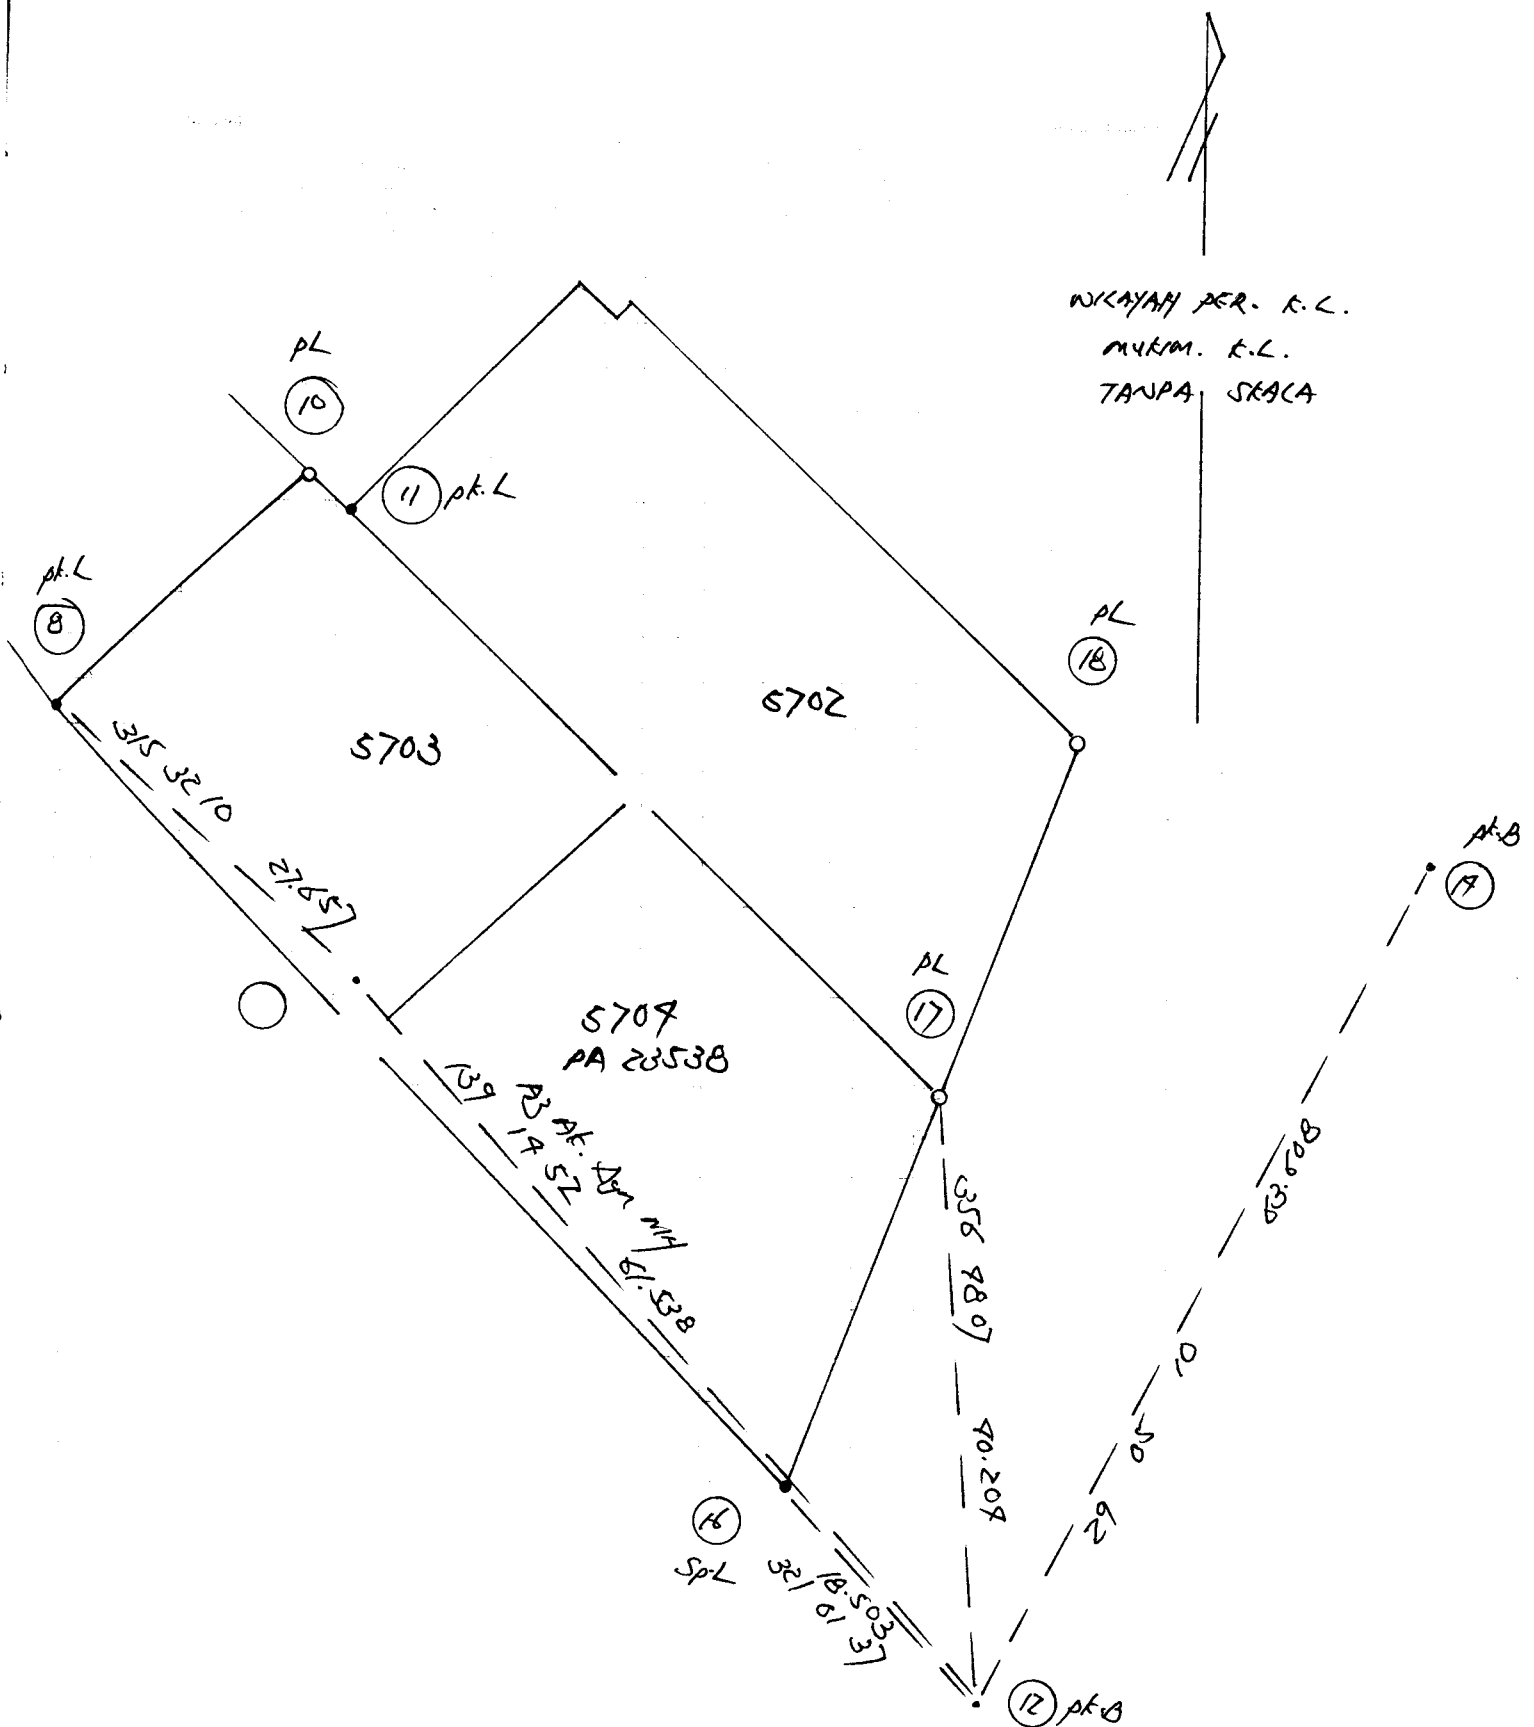

Penilik: WP109 Tmn Desa Tarikh: 18/08/2009
 Stn. 8 Koordinat: S7331 B2015 W.P. Kuala Lumpur
 T.R. 1 B.K. Ms.
 Tiodolit Satu bah. aras ufuk:

Waktu	Sasaran	Ufuk	Gelembong	Puguk		
	T.R.	319 16 40				
8 30	M.H.	77 30 57		72 07 05	Waktu purata	8 30 30
8 30	M.H.	76 57 37		72 03 31	Beza dari U.T. -	8 00 00
8 31	M.H.	256 57 14		288 04 13	U.T.	0 30 30
8 31	M.H.	257 30 33		288 07 57	Deklinasi	13 06 55
	T.R.	139 16 40				
	T.R.	319 16 40				
8 32	M.H.	77 30 46		71 44 46	Waktu purata	8 32 30
8 32	M.H.	76 57 17		71 40 30	Beza dari U.T. -	8 00 00
8 33	M.H.	256 56 53		288 25 37	U.T.	0 32 30
8 33	M.H.	257 30 16		288 31 15	Deklinasi	13 06 53
	T.R.	139 16 40				

	Set 1	Set 2
Sudut pugak	18 00 24	18 22 54
Pembetulan	- 0 02 34	- 0 02 30
Altitud	17 57 50	18 20 24
Jarak kutub	76 53 05	76 53 07
Latitud	3 06 28	3 06 28
Azimut M.H. yang dikira	77 12 55	77 12 32
Purata ke M.H.	77 14 05	77 13 48
Selisih:	- 0 01 10	- 0 01 16
Purata ke T.R.	319 16 40	319 16 40
Azimuth T.R. sebenar	319 15 30	319 15 24
Pembetulan aras	+ 0 00 00	+ 0 00 00
Tirusan	- 0 00 35	- 0 00 35
Bering grid T.R.	319 14 55	319 14 49

Purata bering grid T.R. 319 14 52

Tarikh

7th Dec

Aras

Dibuat untuk

36

Daripada

WSP/189

Ke

Pandangan Belakang	Pandangan Antara	Pandangan Hadapan	Naik	Turun	Aras Yang Dilaras	Jarak	Catitan
0.828	(272)				75.559	78m F/562 na/on top of symp.	
	1/138	(1373)			66.901	F14	
0.931	(1345)	1/727	(567)		66.312	F12 F12	
	1/613	(1529)			65.630	F12 F13	
1.759		1/783	(1585)		75.808	CPX	
		3510			65.760		
0.832	(1273)				65.760		
1.124	(1369)	2000	(656)		75.808	CPX	
0.182	(1066)	3.163	(1102)				
0.554	(1182)	2.082	(683)				
0.252	(1083)	3.235	(1106)				
0.323	(1106)	3.885	(1274)				
0.144	(1098)	3.911	(1283)				
0.082	(1027)	3.756	(1232)				
0.560	(1184)	2.957	(970)				
0.148	(1079)	3.530	(1158)				
0.188	(1062)	3.798	(1296)				
0.283	(1093)	3.844	(1261)				
		3.183	(1104)		30.838		
482		39.244			39.146	CPY	

Tarikh Aras


Dibuat untuk

Daripada

Ke

Pandangan Belakang	Pandangan Antara	Pandangan Hadapan	Naik	Turun	Aras Yang Dilaras	Jarak	Catitan
0.382	(1.25)				39.186 ✓	CP	
0.452	(1.78)	2.908	(9.59)				
0.963	(3.16)	2.068	(6.77)				
1.464	(4.69)	1.739	(5.71)				
0.913	(2.99)	0.838	(1.89)				
0.916		0.916	(3.01)		26.987.		
4.179		8.065					
0.916					28.987		
2.185	(7.17)	0.985	(3.23)				
1.051	(3.45)	1.694	(5.56)		26.892		
1.528		1.528	(5.01)				
4.152		4.207					

BM W 0007 RP Jln Klang Lama.
RC: 26.892

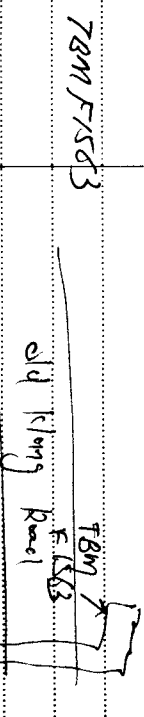

CP
TBM F1503 D. bawah kaki jambatan.
TBM F1503