

MEZ 003 Jalan Selok Pantai Aringgi

29/8/09

Datum Daripada
Matahari

3/9/93

Z

3/9/93

1

68.895

68.895

68.895

Aj Ak.

Aj mH

2-3 68 7856

2 68 7856

3

4

17.930

ptL

17.930

2-4 191 7009

2 191 7009

7

4

7.657

ptL

7.657

2-5 297 1033

2 297 1033

5

4

27.903

ptL

27.903

1 3/9/93

139/93

193 7897

2

193 7897

6

4

71.736

71.736

2

6 193 7897

pt.B

2 223 7897

193 7897

6

69 5753

7

4

128.196

128.196

6

7 69 5753

pt.B

6 299 5793

69 5753

7

199 3815

8

4

25.919

25.919

7

8 199 3815

pt.L

6 Seperti Di Atas

213 7357

7

213 7357

9

4

128.777

128.777

7

9 213 7357

pt.

6 Seperti Di Atas

120 5576

7

120 5576

10

4

87.787

87.787

7

10 120 5576

pt.B

Kupah di muka

7	3005596	1205596	1613733	10	1613733	11	4	22.891	22.891
10									
11	1613733	3913733							
	BTL								
7	Septis Di Atas	1299039	10	1299039	12	4	77.259	77.259	
10									
12	1299039	3099039							
	pkB								
10	3099039	1299039	3099719	12	3099719	13	4	29.996	29.996
12									
13	3099719	1399719							
	BTL (out)								
10	Septis Di Atas	279895	12	279895	19	4	90.612	90.612	
12									
19	279895	2079895							
	pkB								
12	2079895	279895	31755	19	31755	15	4	35.776	35.776
19									
15	31755	1831755							
	pkB								
19	1831755	31755	3270716	15	3270716	16	4	37.987	37.987
15									
16	3270716	1970716							
	pkB.								
15	1970716	3270716	2989209	16	2989209	17	4	32.217	32.217
16									
17	2989209	1189209							
	pkB								

16 118 9209 298 9209 339 0329 17 339 0329 9 4 87.359 87.359
17
9 339 0329 159 0329


17 159 0329 339 0329 213 9359 9 213 9359 7 Sika Gikat m/s 19 R 6
9
7 213 9359 33 9359 Bering
Tutup

Bering 97 Dibaca 213 9359
Sepertinya Di baca 213 9359


Tikaian Ni)
Ambukan Ni)

8-11 1291359 78-293 ✓
1271390 78-298 PD

+19" -0.005

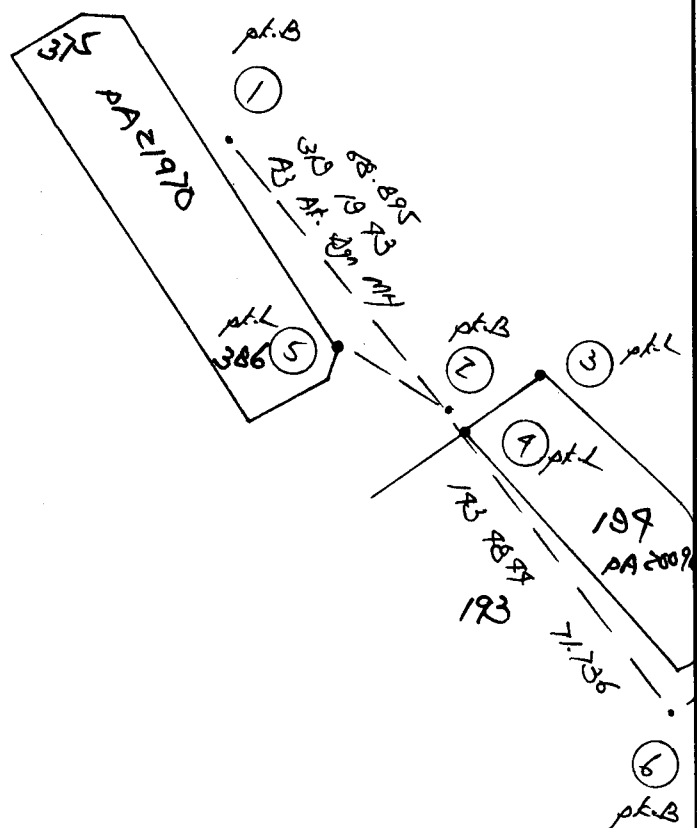

DAERAH MELAKA TENGAH
 BANDAR BARU BARU
 SEK. V
 39-C-111
 TANPA SKALA

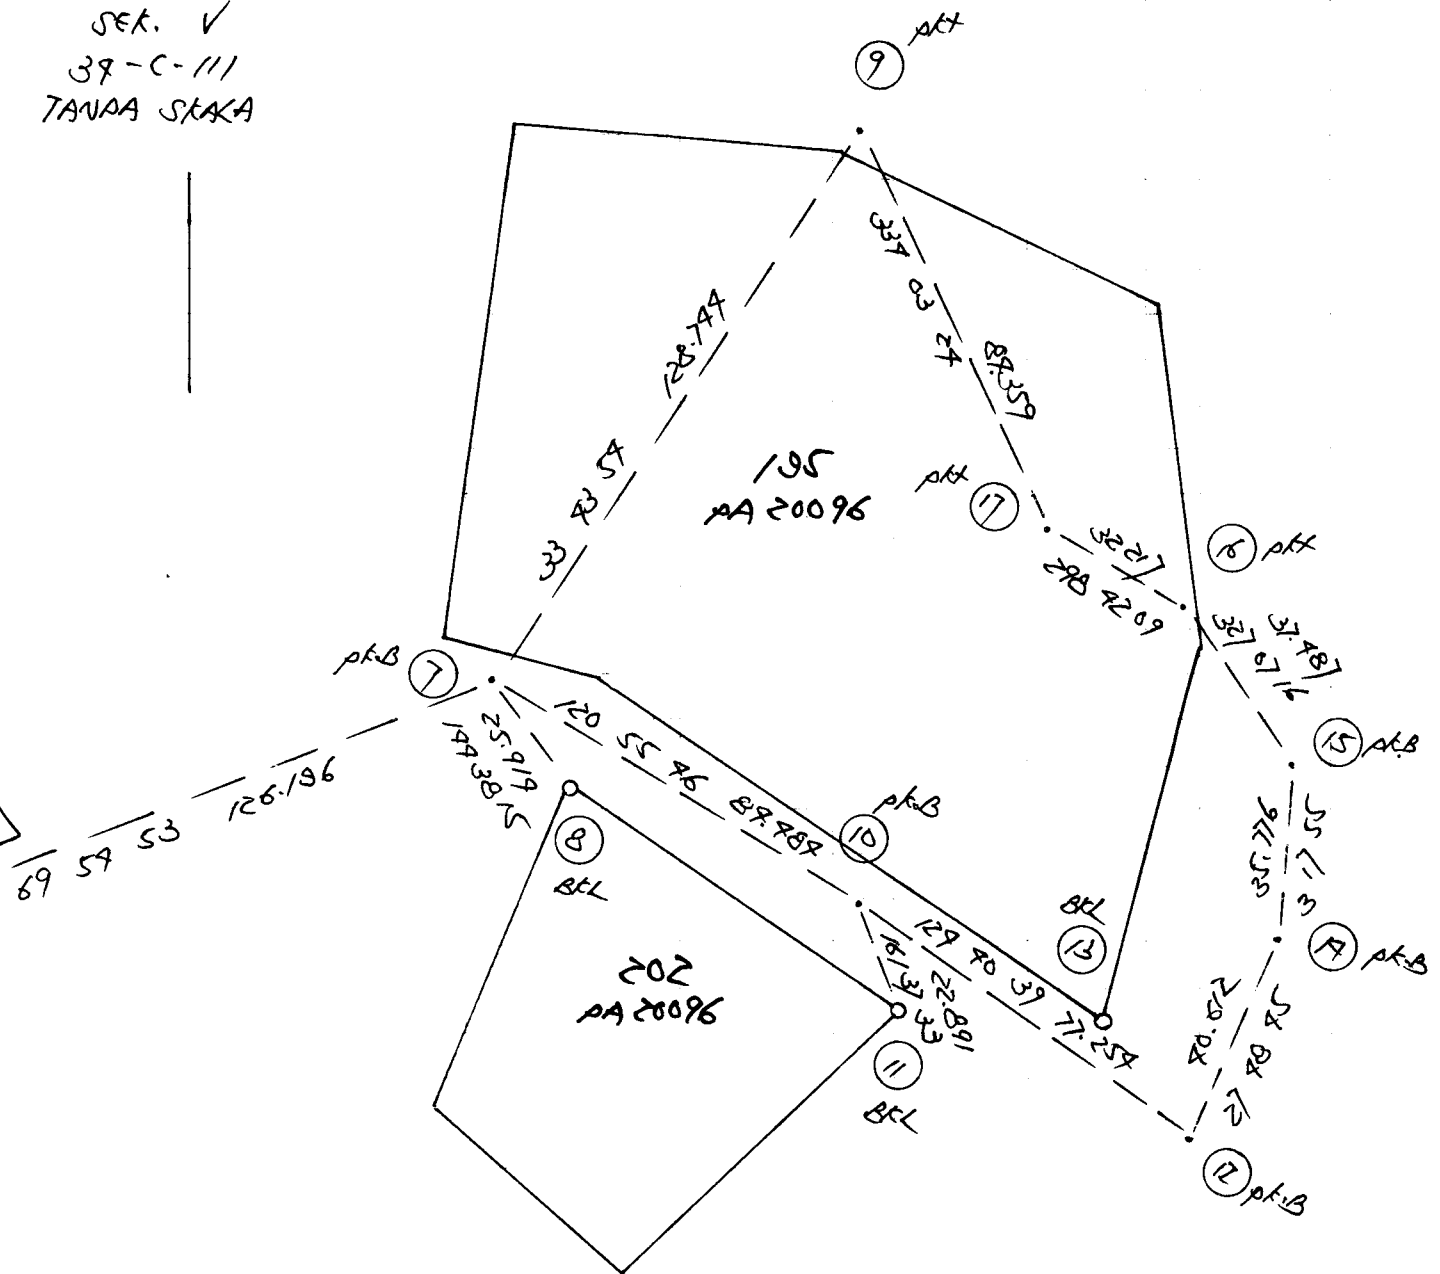

Penilik: MEL003 Jln Pantai Pringgit Tarikh: 24/08/2009

Stn. 2 Koordinat: S54790 T34976 Melaka

T.R. 1 B.K. Ms.

Tiodolit Satu bah. aras ufuk:

Waktu	Sasaran	Ufuk	Gelembong	Puguk
	T.R.	316 00 00		
8 35	M.H.	75 55 25	70 09 28	Waktu purata 8 35 30
8 35	M.H.	75 21 32	70 04 05	Beza dari U.T. - 8 00 00
8 36	M.H.	255 21 06	290 03 09	U.T. 0 35 30
8 36	M.H.	255 54 38	290 09 31	Deklinasi 11 07 06
	T.R.	136 00 00		

	T.R.	316 00 00		
8 37	M.H.	75 54 47	69 42 43	Waktu purata 8 37 30
8 37	M.H.	75 20 43	69 37 37	Beza dari U.T. - 8 00 00
8 38	M.H.	255 20 07	290 31 23	U.T. 0 37 30
8 38	M.H.	255 53 50	290 36 25	Deklinasi 11 07 04
	T.R.	136 00 00		

	Set 1	Set 2
Sudut pugak	19 59 47	20 26 52
Pembetulan	- 0 02 17	- 0 02 13
Altitud	19 57 30	20 24 39
Jarak kutub	78 52 54	78 52 56
Latitud	2 13 31	2 13 31
Azimut M.H. yang dikira	78 58 38	78 57 47
Purata ke M.H.	75 38 10	75 37 22
Selisih:	3 20 28	3 20 25
Purata ke T.R.	316 00 00	316 00 00
Azimuth T.R. sebenar	319 20 28	319 20 25
Pembetulan aras	+ 0 00 00	+ 0 00 00
Tirusan	- 0 00 44	- 0 00 44
Bering grid T.R.	319 19 44	319 19 41

Purata bering grid T.R. 319 19 43

Tarikh M 003

Aras 50% k

Daipada

Dibuat untuk

40


Ke

Pandangan Belakang	Pandangan Antara	Pandangan Hadapan	Naik	Turun	Aras Yang Dilaras
--------------------	------------------	-------------------	------	-------	-------------------

1.325	(1.835)				8.090
	1.798	(1.75)			7.967
		1.395	(1.558)		8.020
1.195	(1.378)				8.020
1.049	(1.378)	1.921	(1.630)		
0.884	(1.290)	1.993	(1.558)		
1.194	(1.392)	2.129	(1.698)		
1.078	(1.354)	1.923	(1.631)		
1.224	(1.902)	1.711	(1.561)		
1.332	(1.837)	1.831	(1.601)		
1.471	(1.983)	1.840	(1.608)		
1.621	(1.532)	1.583	(1.519)		
1.568	(1.519)	1.616	(1.539)		
1.481	(1.881)	1.466	(1.961)		
		1.202	(1.399)		2.852
1.047		1.925			

Jarak

Catitan

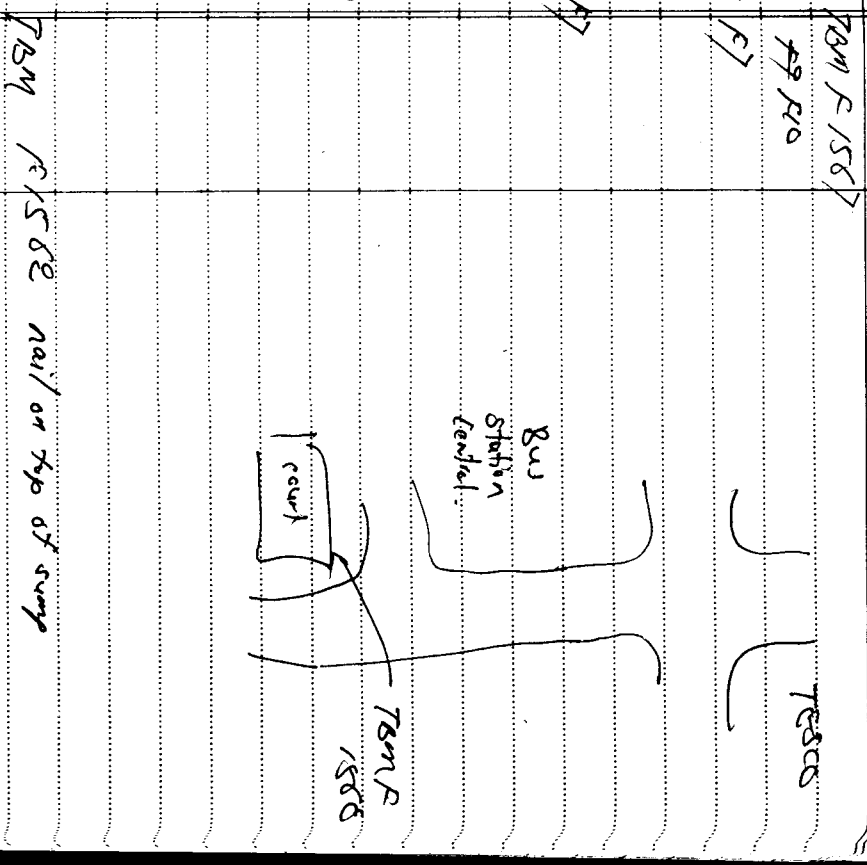

Tarikh Aras

Dibuat untuk

Daripada

Ke

Pandangan Belakang	Pandangan Antara	Pandangan Hadapan	Naik	Turun	Aras Yang Dilaras	Jarak	Catitan
1.333	(9.37)				2.852	78M 5/568	
1.608	(5.27)	1.788	(5.87)				
1.595	(5.07)	1.589	(5.20)				
1.518	(9.98)	1.968	(9.82)				
2.093	(6.70)	1.618	(5.31)				
1.539	(5.03)	1.958	(9.78)				
1.608	(5.27)	1.536	(5.09)				
1.469	(9.80)	1.598	(5.08)				
1.550	(5.09)	1.723	(5.65)				
1.525	(5.00)	1.520	(9.99)				
1.531	(5.02)	1.527	(5.01)				
1.959	(9.77)	1.558	(5.11)				
1.778	(9.85)	1.513	(9.97)				
1.539	(5.05)	1.999	(9.79)				
1.726	(5.06)	1.555	(5.10)				
1.318	(9.32)	1.285	(9.22)				
2.521	(8.27)	0.560	(1.83)				
1.202	(3.99)	0.573	(1.88)				
0.373	(1.22)	2.927	(9.60)				
		2.988	(8.16)		2.099	CP3	
28870		29673					

Tarikh Aras

Dibuat untuk

42

Daripada

Ke

Pandangan Belakang	Pandangan Antara	Pandangan Hadapan	Naik	Turun	Aras Yang Dilaras	Jarak	Calitan
1. 9223	(9.67)				2 049	3	
1. 663	(5.98)	1. 989	(9.8)			2	
1. 928	(9.69)	1. 626	(5.38)			901	
9. 519		1. 133	(3.72)		2320	78m F/1569	
		9. 283					
1. 188	(3.87)				2320	78m F/1569	
1. 638	(5.36)	1. 960	(9.79)				
1. 981	(9.85)						
1. 987	(9.88)	1. 298	(9.26)				
1. 575	(5.17)	1. 999	(9.25)				
1. 967	(9.81)	1. 352	(9.99)				
1. 708	(5.60)	1. 279	(9.20)				
1. 690	(5.38)	1. 516	(9.97)				
1. 534	(5.03)	1. 375	(9.51)				
1. 503	(4.93)	1. 561	(5.12)				
		1. 329	(4.34)		3928	8m 15038	
1. 3722		12.614					

8m 15038 Dihadapan DTC motor stand.

Tarikh Aras

Dibuat untuk Ke

43

Daripada

Pandangan Belakang	Pandangan Antara	Pandangan Hadapan	Naik	Turun	Aras Yang Dilaras	Jarak	Catitan
1.229					3.928	BM M 5036	
1.493 (4.74)		1.988	(4.88)				
1.422 (4.66)		1.813	(5.95)				
		1.663	(5.96)		2.653	BM M 0139	RC: 2.653m
2.189 -		2.969					