

No. Fail

NS005A Aulian Rasant

Rajah di muka

Stesen	BEARING / SUDUT			Dari Stn.	GARISAN		Ke Stn.	Sudut Pugak (±)	Jarak	Subu	Jarak Antara Tupang	Jarak Muktamat
	Penyilang Kiri	Penyilang Kanan	Purata		Bearing Muktamat							
1	Datum Daripada	751708	2	751708	1	4	111.095			29/6/67		111.095
2	NS017 1											
1	751708	2551708	190929	2	190929	100	4	89.885				89.885
2	100	190929	320929					89.886				
	pk. L (F3)											
2	320929	190929	2383992	100	2383992	101	4	87.190				87.190
100								87.190				
101	2383992 583992											
	pk											
100	583992	2383992	2811029	101	2811029	102	4	199.929				199.929
101								199.929				
102	2811029 1011029											
	pk											
101	1011029	2811029	339393	102	339393	109	4	107.689				107.689
102								107.686				107.689
103	339393 1339393											
	pk.B											
102	1339393	339393	3051236	103	3051236	109	4	33.959				33.959
103								33.959				
109	3051236 1251236											
	pk.B											
103	1251236	3051236	3515009	109	3515009	105	4	56.789				56.789
109								56.789				
105	3515009 1715009											
	pk.B											

No. Fail

Rajah di muka

BEARING / SUDUT

GARISAN

Stesen

Penyilang Kiri

Penyilang Kanan

Purata

Dari
Stn.

Bearing Muktamat

Ke
Stn.Sudut Pugak
(±)

Jarak

Suhu

Jarak
Antara
Tupang

Jarak Muktamat


Stesen	Penyilang Kiri	Penyilang Kanan	Purata	Dari Stn.	Bearing Muktamat	Ke Stn.	Sudut Pugak (±)	Jarak	Suhu	Jarak Antara Tupang	Jarak Muktamat
107 105	111 5009	351 5009	296 0927	105	296 0927	106	4	27.023			27.029
106	296 0927	116 0927									
	pt.B										

pt.B

No. Fail


Rajah di muka

Stesen	BEARING / SUDUT			Dari Stn.	GARISAN Bearing Muktamat	Ke Stn.	Sudut Pukak (±)	Jarak	Suhu	Jarak Antara Tupang	Jarak Muktamat
	Penyilang Kiri	Penyilang Kanan	Purata								

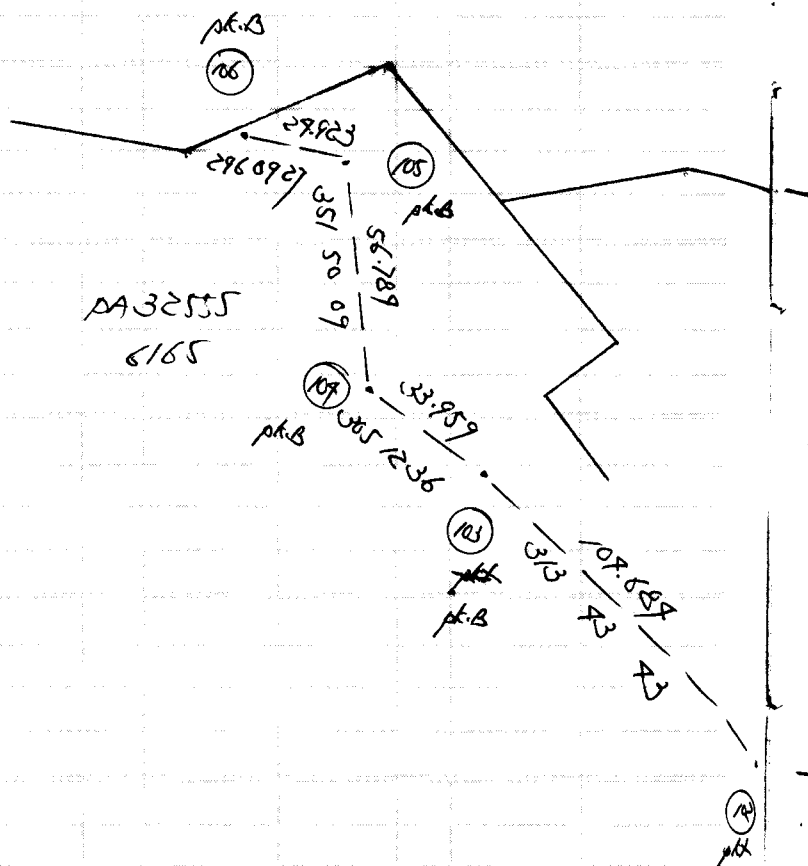

Stesen	BEARING	SUDUT	Dari	Ke	Sudut Pukak	Jarak	Suhu	Jarak Antara Tupang	Jarak Mukmat
	Penyilang Kiri	Penyilang Kanan	Purata	Stn.	Bearing Mukmat	Stn.	($\pm$)		

DAERAH PORT DICKSON
MUKIM SI RUSA
SHEET 73 D IV
TANDA SKALA

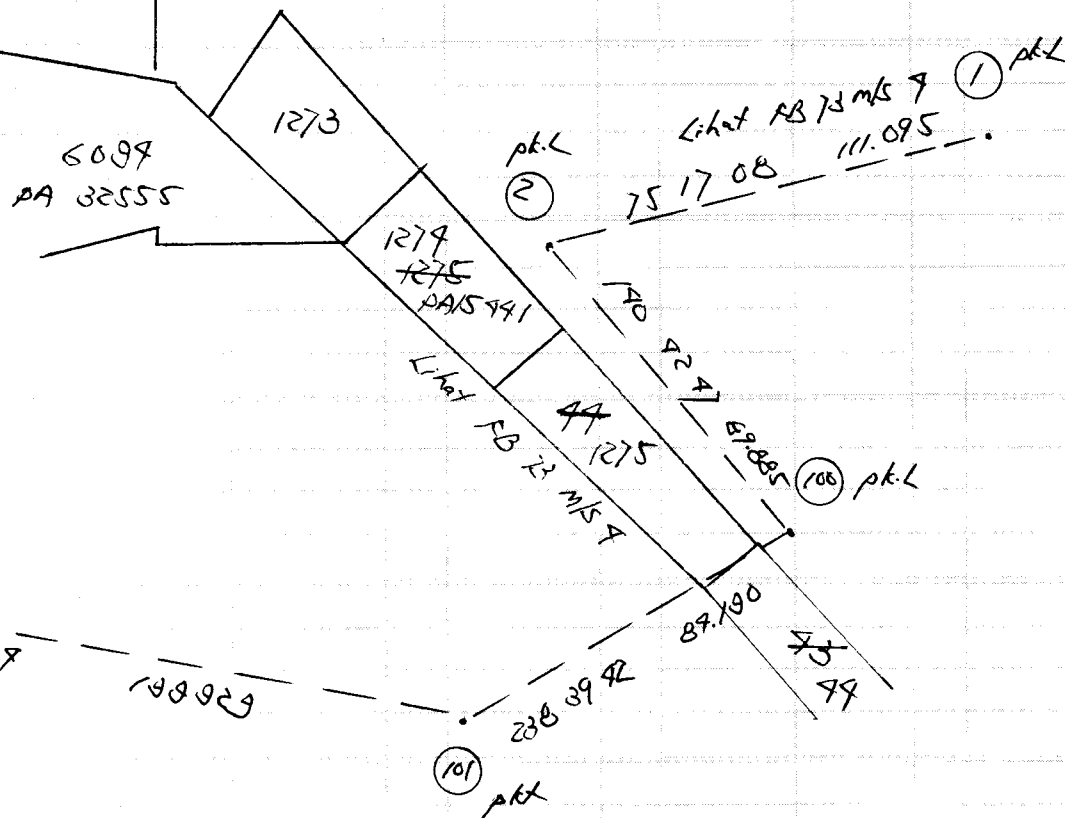

DATEM RUTUK FB073 115017

Tarikh

Ajiliah Rosyid

Aras

Dibuat untuk

66

NS005A

Daripada

Ke

Pandangan Belakang	Pandangan Antara	Pandangan Hadapan	Naik	Turun	Aras Yang Dilaras	Jarak	Catitan
1.979	(9.88)				3.918		
	1.032	(3.39)			3.880		F106 BM 51 N021C
	1.909	(9.81)			3.508		TBM F1216 4pai jolokta bu
		1.982	(9.86)		3.910 -		F105 90
1.826	(5.99)				3.930		
2.096	(6.71)	1.008	(3.31)				
3.809	(12.98)	0.078	(0.28)				
5.190	(0.96)	0.701	(2.30)				
		2.825	(8.84)				
3.631	(11.91)	0.817	(2.68)				
2.775	(8.91)	0.179	(0.55)				
0.352	(1.16)	0.110	(0.36)				
1.331	(9.32)	3.918	(11.2)				
2.017	(6.62)	5.981	(1.58)				
1.058	(3.97)	1.773	(5.82)				
0.990	(1.99)	1.798	(5.90)				
		1.992	(6.58)		10.935		
1.980		12.355					

F2

~~TBM~~

F3

NS017

Namin Bay

<808 m/s NS