



Rajah di muka

[illegible]

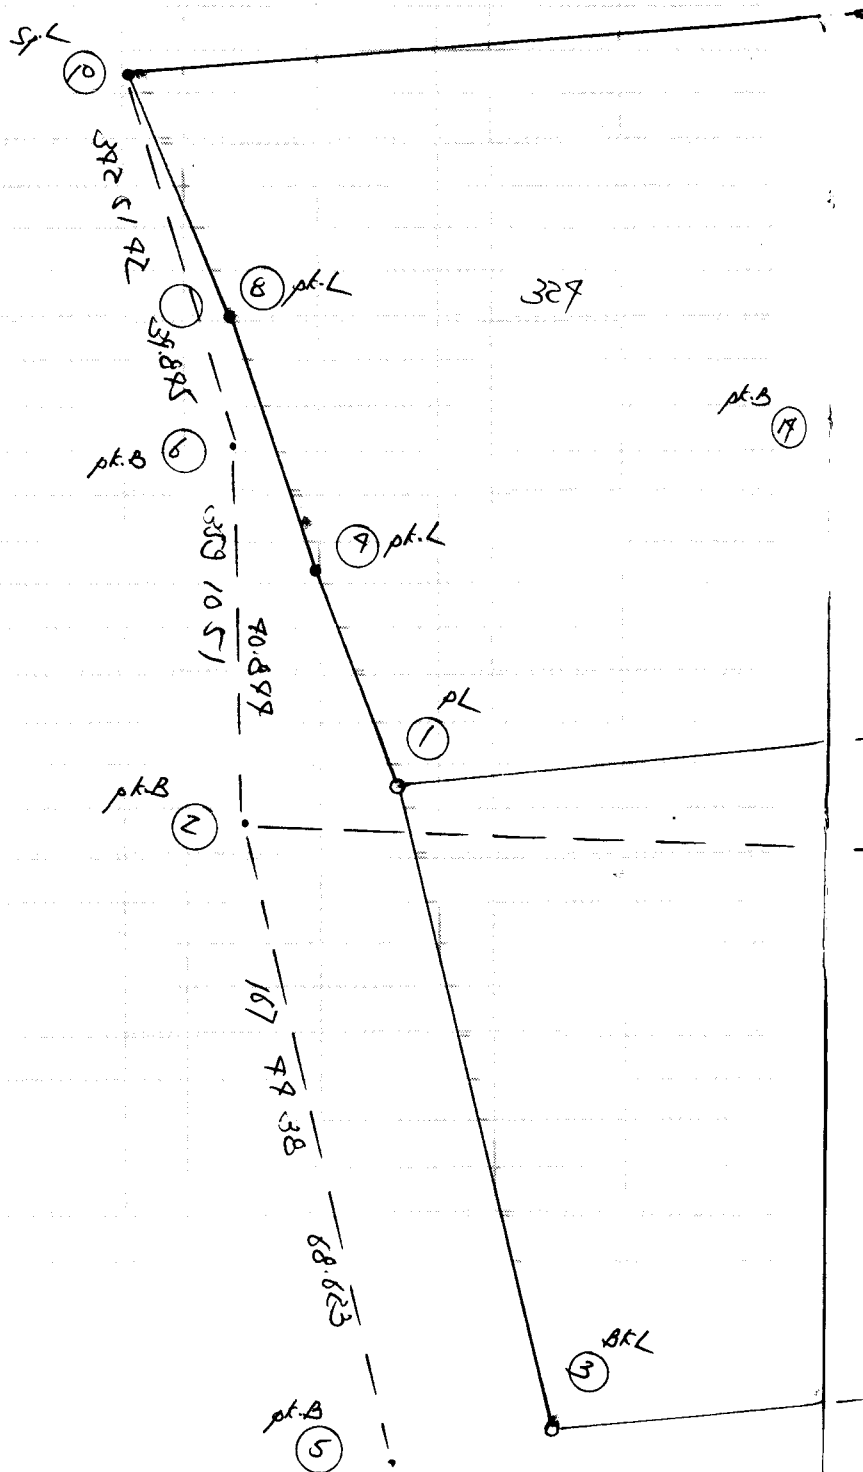

No. Fail

Rajah di muka

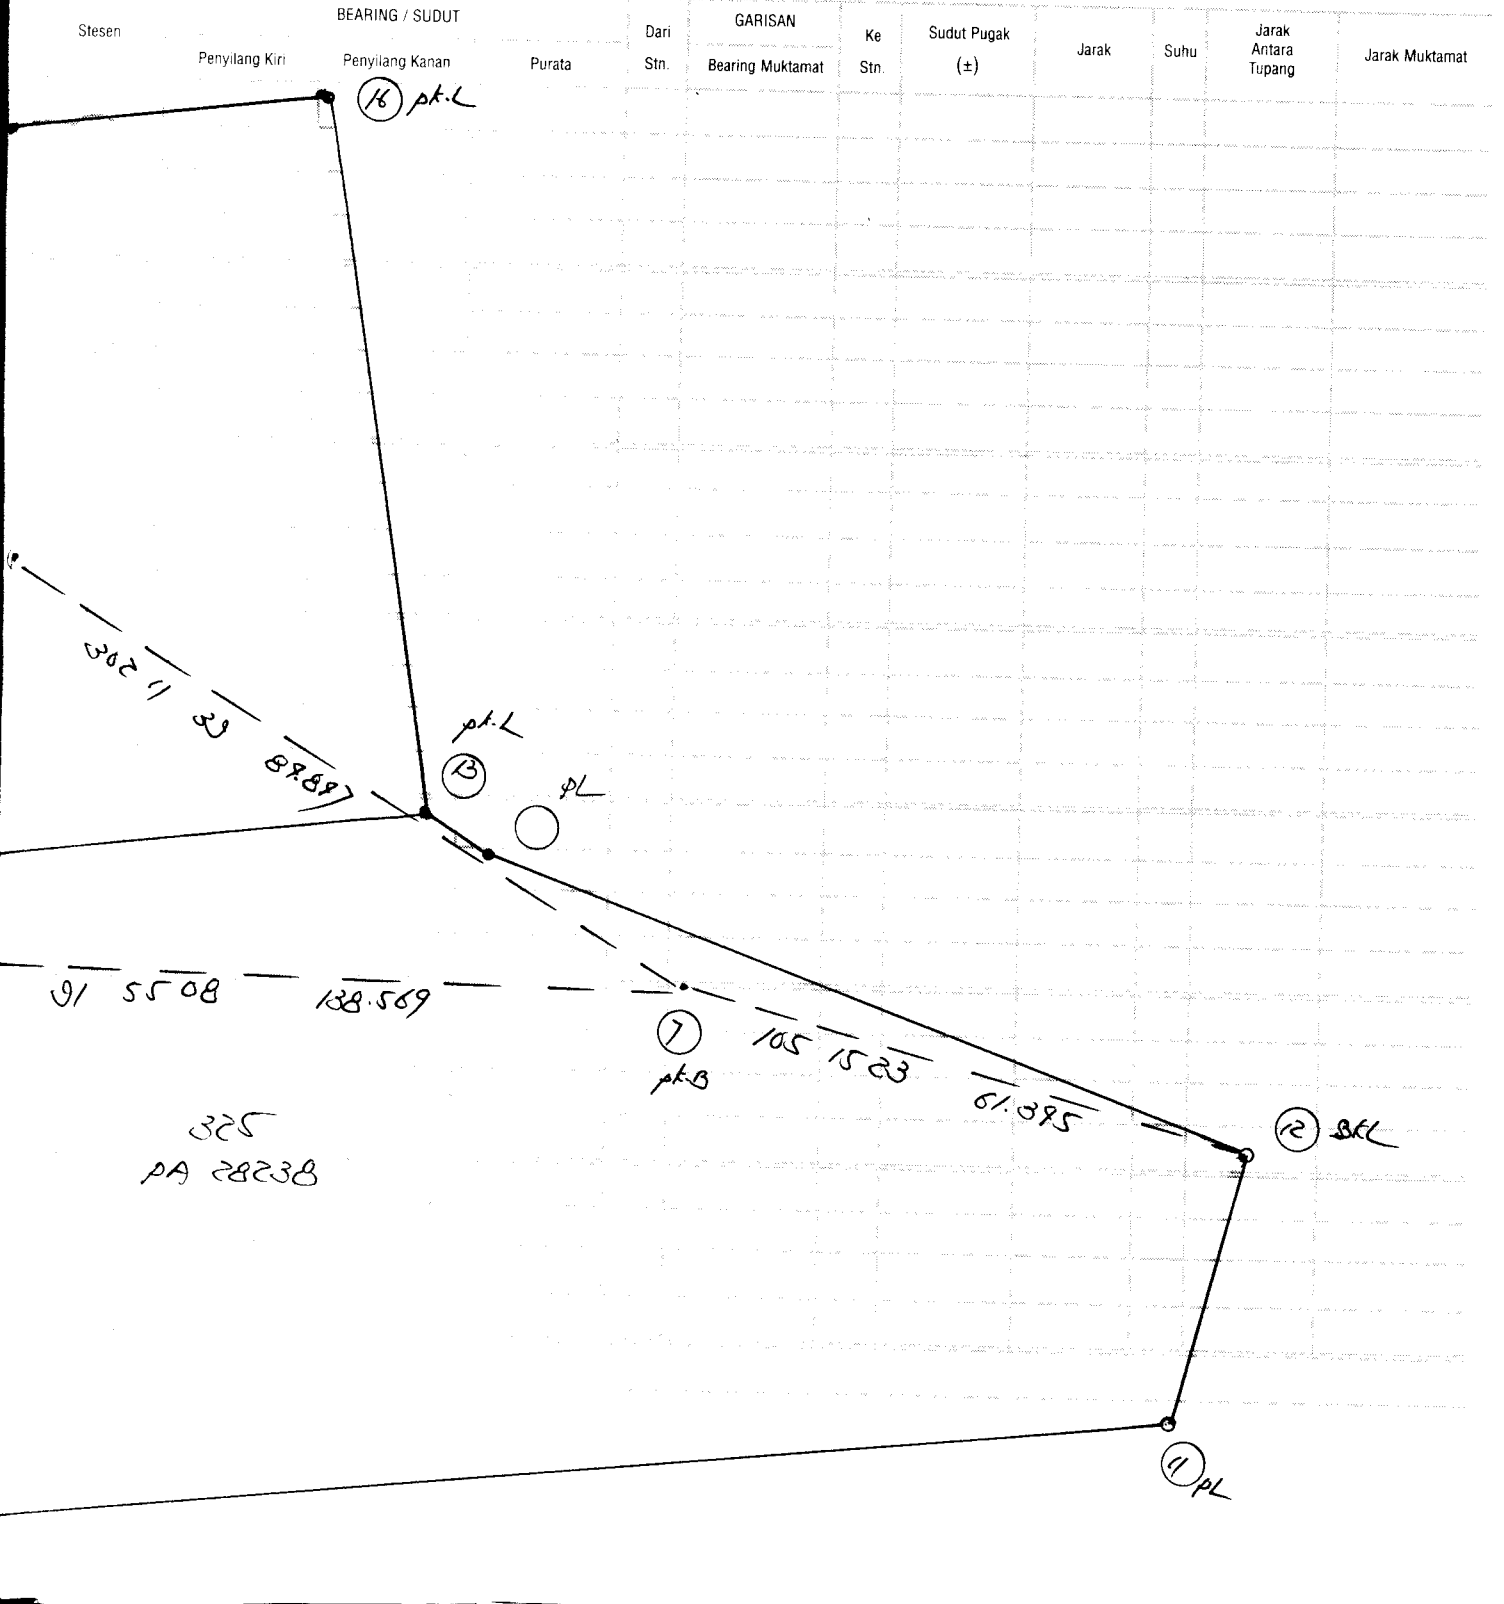

১৫

के

78M F/27S Ahs Kott omdenk.
 78M DCC Ahs pds wq
 sp/1
 78M DCC Ahs Hynd.
 sp2
 sp2
 sp2

TAM FILL
 SATO
 10
 5/2/21
 SATO
 Hynd.
 Vandys
 pds.
 L. 2/21


Tarikh Aras

Dibuat untuk

40

Daripada

Ke

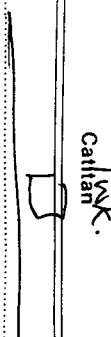Pandangan Belakang	Pandangan Antara	Pandangan Hadapan	Naik	Turun	Aras Yang Dilaras	Jarak	Catatan
1.585	(5.20)				22.58	X1	
1.963	(6.98)	1.909	(18.62)				514 222 TBM F 127 Bus stop.
1.625	(5.33)	1.032	(3.35)				
1.605	(5.27)	1.971	(18.83)				
6.778		1.380	(18.53)		29.067	TBM F 127	Ai bus stop. gubang pendang sdh Bld.
1.380					29.067	TBM F 127	RHB Bank RHB Dth Business Center.
1.699	(5.90)	1.570	(5.15)				
1.956	(7.78)	1.220	(18.00)				
1.820	(5.97)	0.995	(3.28)				
2.396	(7.86)	0.520	(1.77)				
0.529	(1.72)	1.783	(5.78)				
	1.908	(18.62)					
		1.57	(18.98)		25.702	TBM F1 / TBM F127	Apex joint m04
9.22		7.585					BM 2 0033 (Rc: 23.280m)

Tarikh Aras

Dibuat untuk

Daripada

Ke

Pandangan Belakang	Pandangan Antara	Pandangan Hadapan	Naik	Turun	Aras Yang Dilaras	Jarak	Catitan
1.691	(5.38)				22239	12 (RM1)	
	1.162	(3.81)			23.013	15 (RM2) Km2	
	1.686	(5.53)			22689	90.5020	
1.567	(5.18)	1.929	(18.67)		222951	90	
1.957	(9.18)	1.686	(5.53)		22832	92	
		1.325	(9.5)		22919	RM3)	
7.665		7.985					