


S. 290900
E. 175300



LOTS 337 to 375

Lots 337 to 366—being Amalgamation and Subdivision of lots 158, 160 & 161 & 162—C.P. 5687
Lots 367 to 375—being Subdivision of lots 159 & 160—C.P. 5687

TOWN AREA XXIX
TOWN OF MALACCA
Scale Forty Feet to an Inch

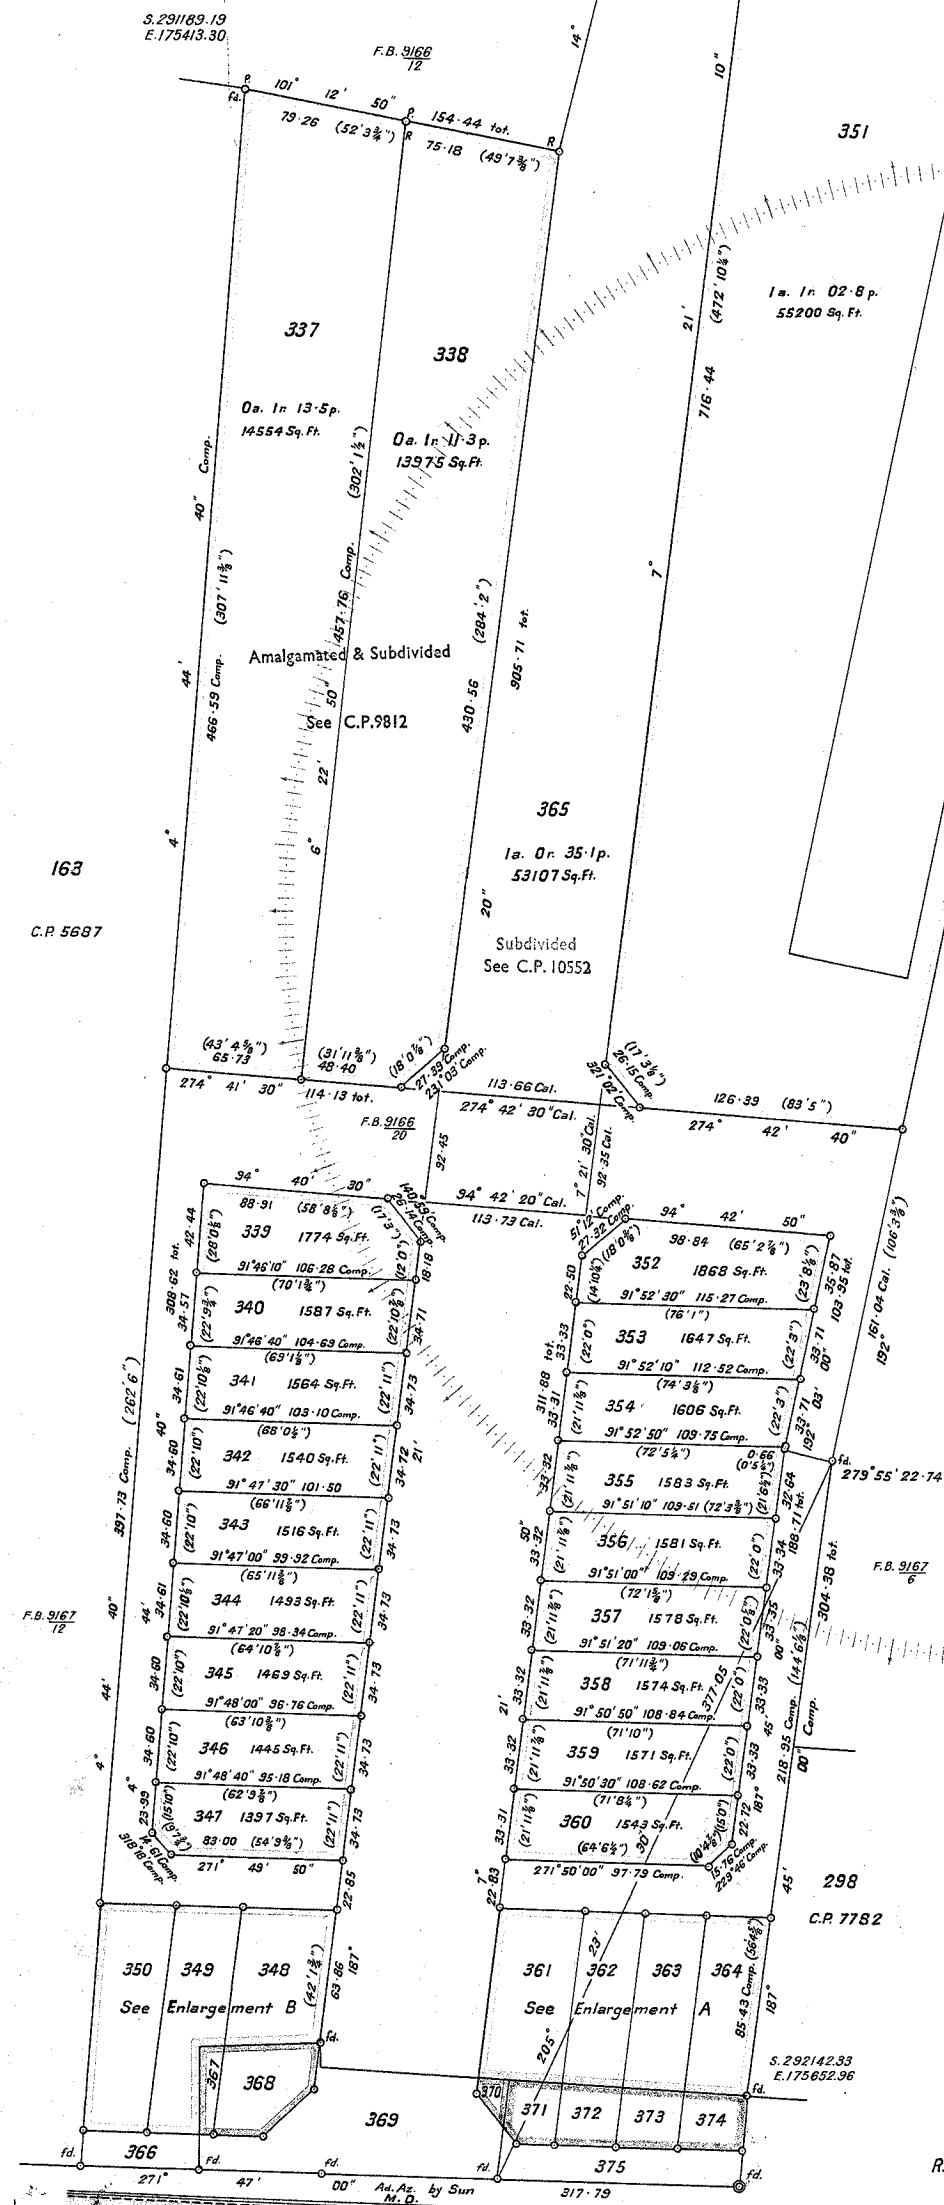

I, **AYOB BIN SAUD**, a surveyor licensed under the Licensed Land Surveyors Ordinance No. 11 of 1958, certify that the survey from which this plan has been prepared was carried out and marked on the ground by me or under my immediate personal direction and supervision in the field in strict accordance with the Licensed Land Surveyors Regulations, and that this plan correctly represents that survey completed on the 6th day of May, 1961.
Dated this 12th day of October, 1961.
highland
Surveyor.
Licensed under Ordinance No. 11 of 1958.

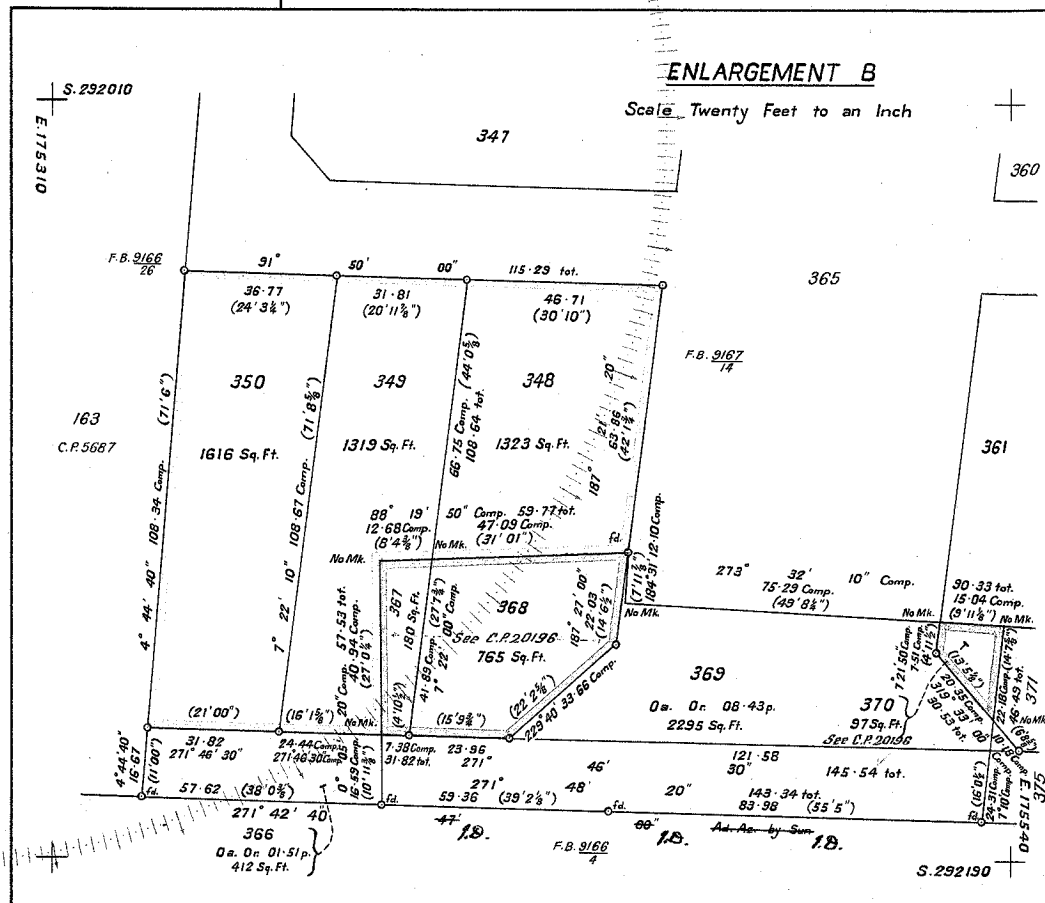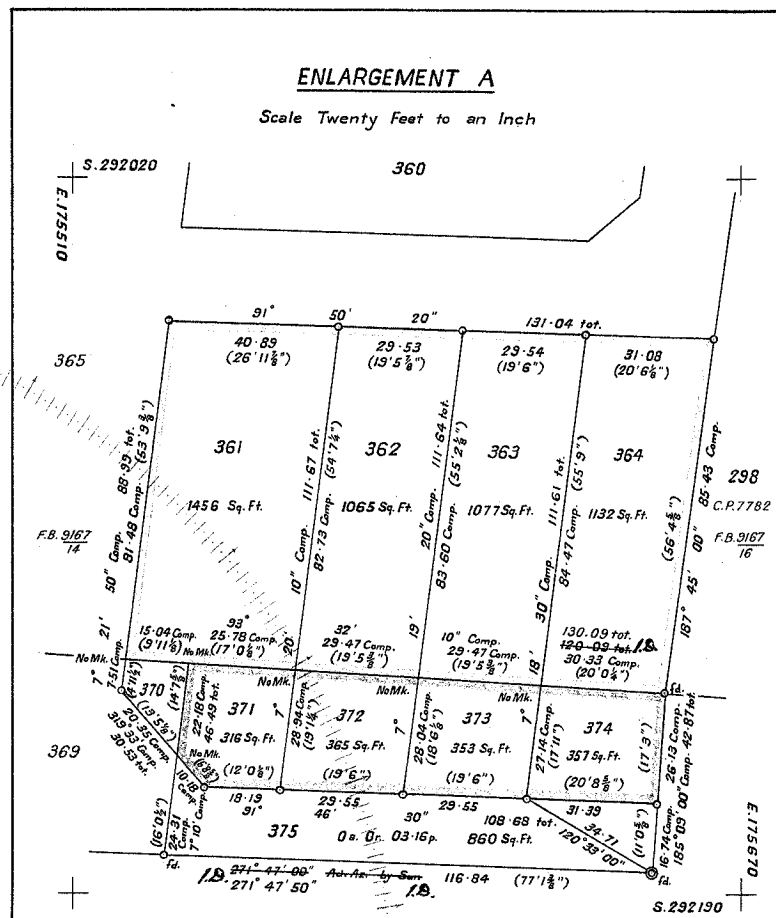

BANDA HILIR ROAD

Cal. Vol. 260 pp. 39 to 62

TOWN AREA XXX

R.S.M. (L.S.) 19-61

D.O.M. 03840

Std. Sheet 44-A - 1/3

Field Books 9166 pp. 1 to 42
9167 pp. 1 to 16

First Class Survey

Charted by *Ayob Bakar*
10.11.61

Examined by *S. C. Shuniora*
10.11.61

Approved *I. R. Dunlop*
10.11.61

Plan No. 9258