

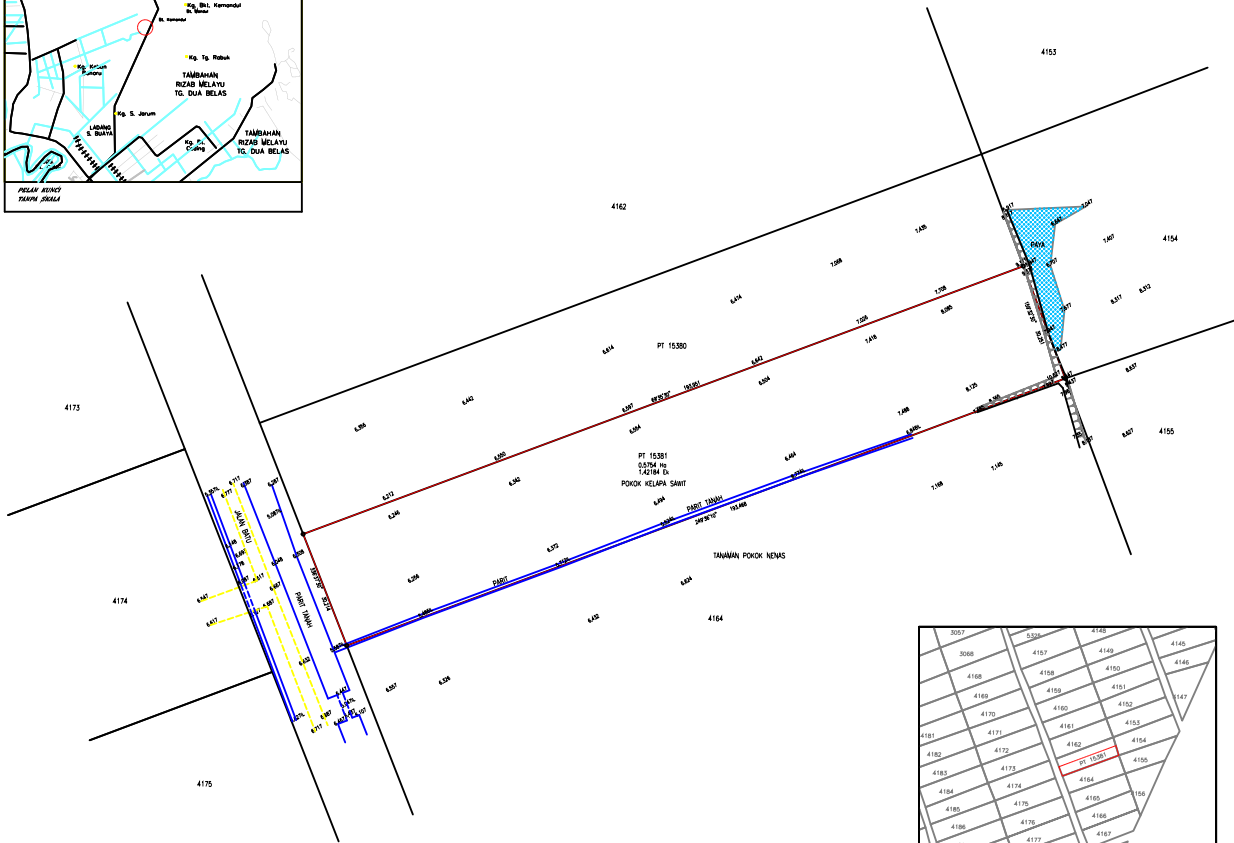
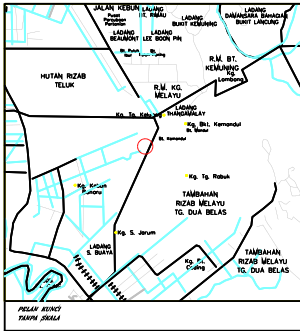


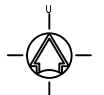

NOTA :
 - JALAN BATU
 - LONGKING / PAHAT
 - TEBING

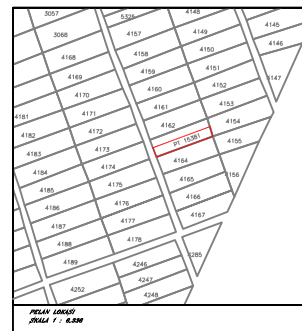

PELAN TAPAK
 SKALA 1 : 500
 SYIT PIAWAI : 108-A

TAJUK
 PELAN BUTIRAN DAN ARAS LARAS
 BAGI PT 15381
 MUKIM TELUK PANGLIMA GARANG
 DAERAH HULU LANGAT
 SELANGOR DARUL EHSAN

PEMOHON:

TAJUK LUKSARAN :
 PELAN KUNCI,LOKASI DAN TAPAK

DISEMAKAN : IDA TARIKH : DIS 2016

DISEMAK : ZAMMIRZA

JURUKUR BERLESEN:

JURUKUR SAMSUDIN HASSAN
 (LICENSED LAND AND PLANNING SURVEYOR)
 Land & Planning Development Consultant/Land & Survey, Road & Marine,
 Transportation & Infrastructure City, District/Regional/Planning Survey.

SELANGOR : No.11, Jalan Patau Kempas 26/1, Taman Rim Baga/Selangor 28
 43400 Shah Alam, Sel. Tel: 03-61918573 Fax: 03-61928573

NO PELAN : JSH/SEL/END/ /2016