


# LOTS 1258 - 1265

## MUKIM OF AMPANG

### DISTRICT OF KUALA LUMPUR

Scale Two Chains to an Inch

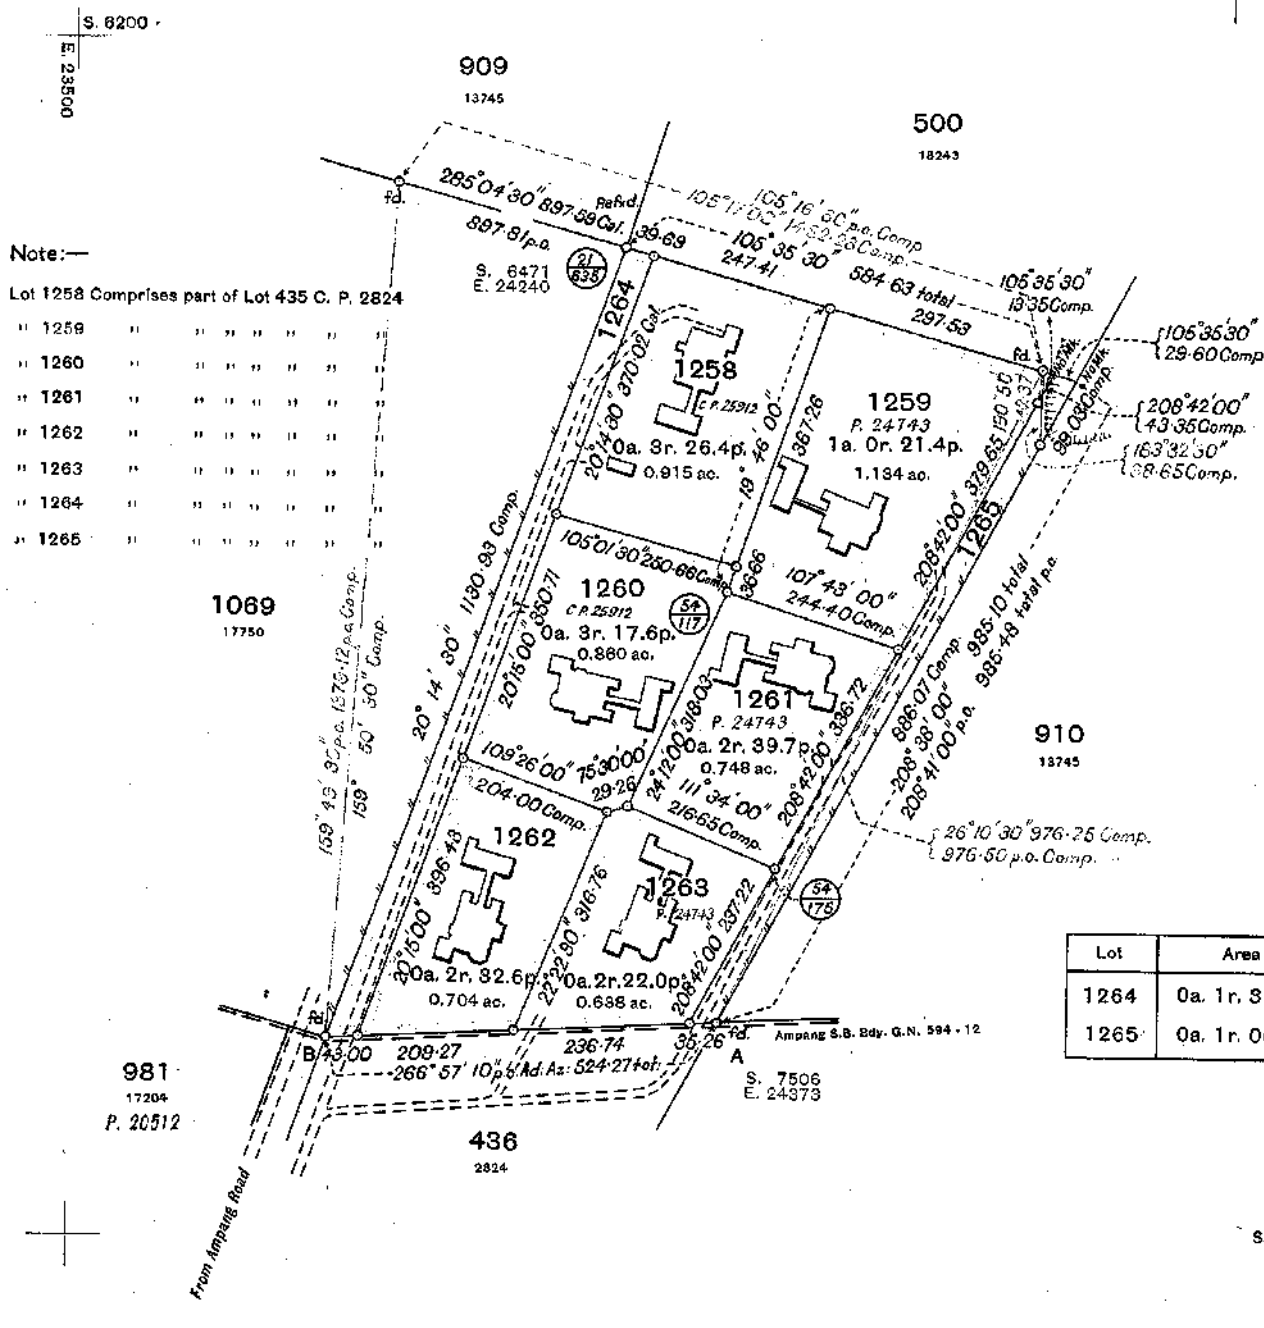

Azimuth from A. B.

Lot Svy. L.O.  
1258 - 1265 500 - 40 711 - 39

Surveyed by Chin Kon Yong

Second Class Survey

Completed on 11. 10. 40

Drawn & Charted by

*Lekario*  
7. 11. 40

Field Book 10232 pages 13 - 22

Examined by

*Abdullah*  
8. 11. 40

Plan Approved

*A. Blackman*  
13. 11. 40