

LOTS 1523-1528

MUKIM OF AMPANG

DISTRICT OF KUALA LUMPUR

Scale One Chain to an Inch


Note:

Lots 1523-1525 being subdivision of lot 1258-C.P.19645

Lots 1526-1528 being subdivision of lot 1260-C.P.19645

I, **YEON HO HUAT** a surveyor
Licensed under the Licensed Land Surveyors Ordinance No. 11
of 1958, certify that the survey from which this plan has been
prepared was carried out and marked on the ground by me or
under my immediate personal direction and supervision in the
field in strict accordance with the Licensed Land Surveyors
Regulations, and that this plan correctly represents that survey
completed on the 10th day of September 1972
Dated this 14th day of September 1972

[Signature] Surveyor.
Licensed under Ordinance No. 11 of 1958

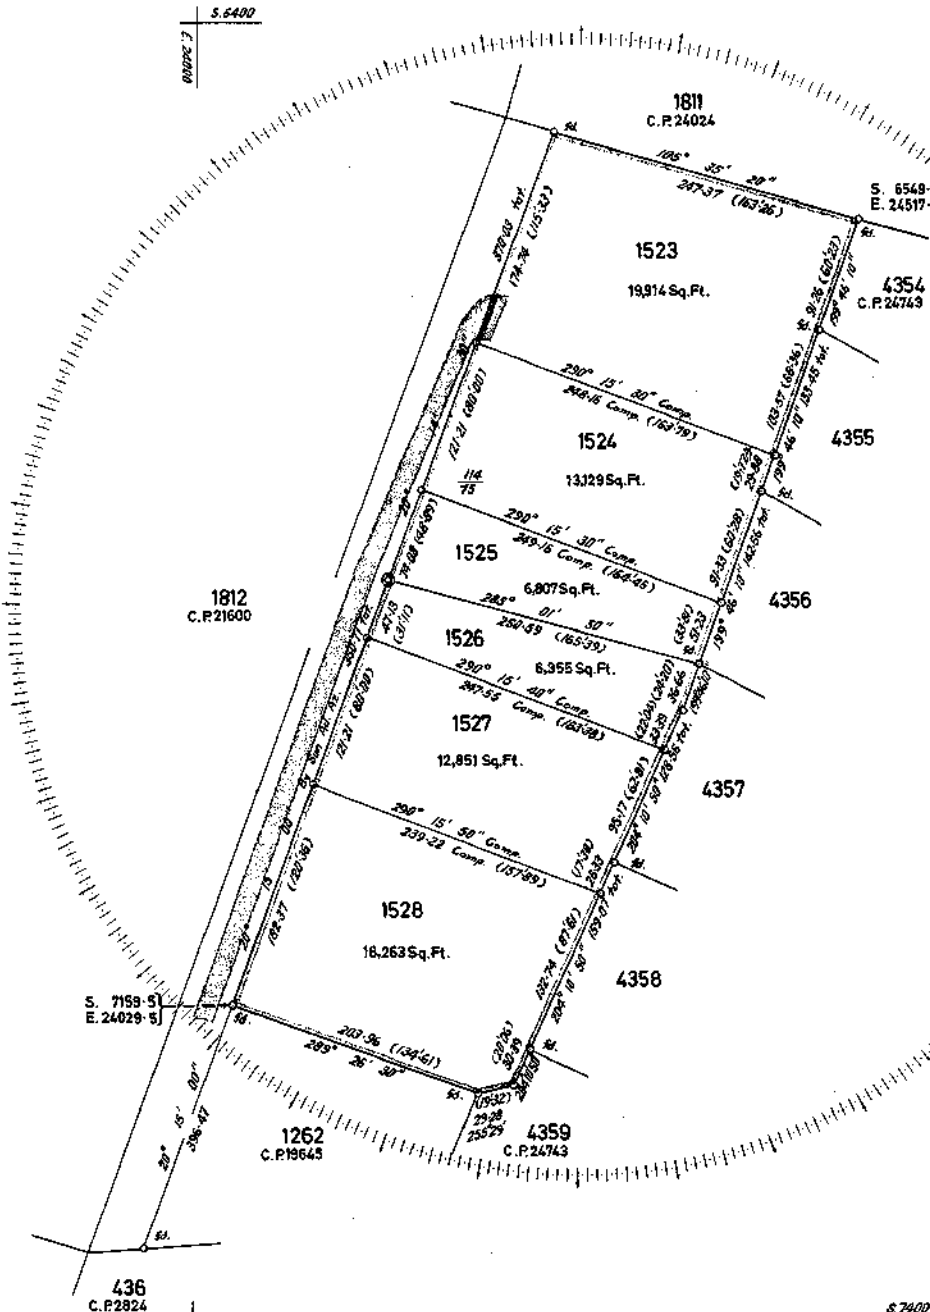

Std. Sheet 86-A

Svy Ref P.U.B.L. Sel. 119-68

L.O. Ref. P.H.T.K.L. 6-1191-65

Cal. Vol. 465 pp.191-193

Field Book 17753

First Class Survey

Examined by *[Signature]* S. 1.73.

Approved *[Signature]* 1.2.73

C.P.25912